


This drawing and the design it covers are the property of BECHTEL. They are hereby loaned and on the borrower's express agreement they may not be reproduced, copied, loaned, exhibited, or used except in the limited way and for the purposes permitted by any written consent given by the lender to the borrower.

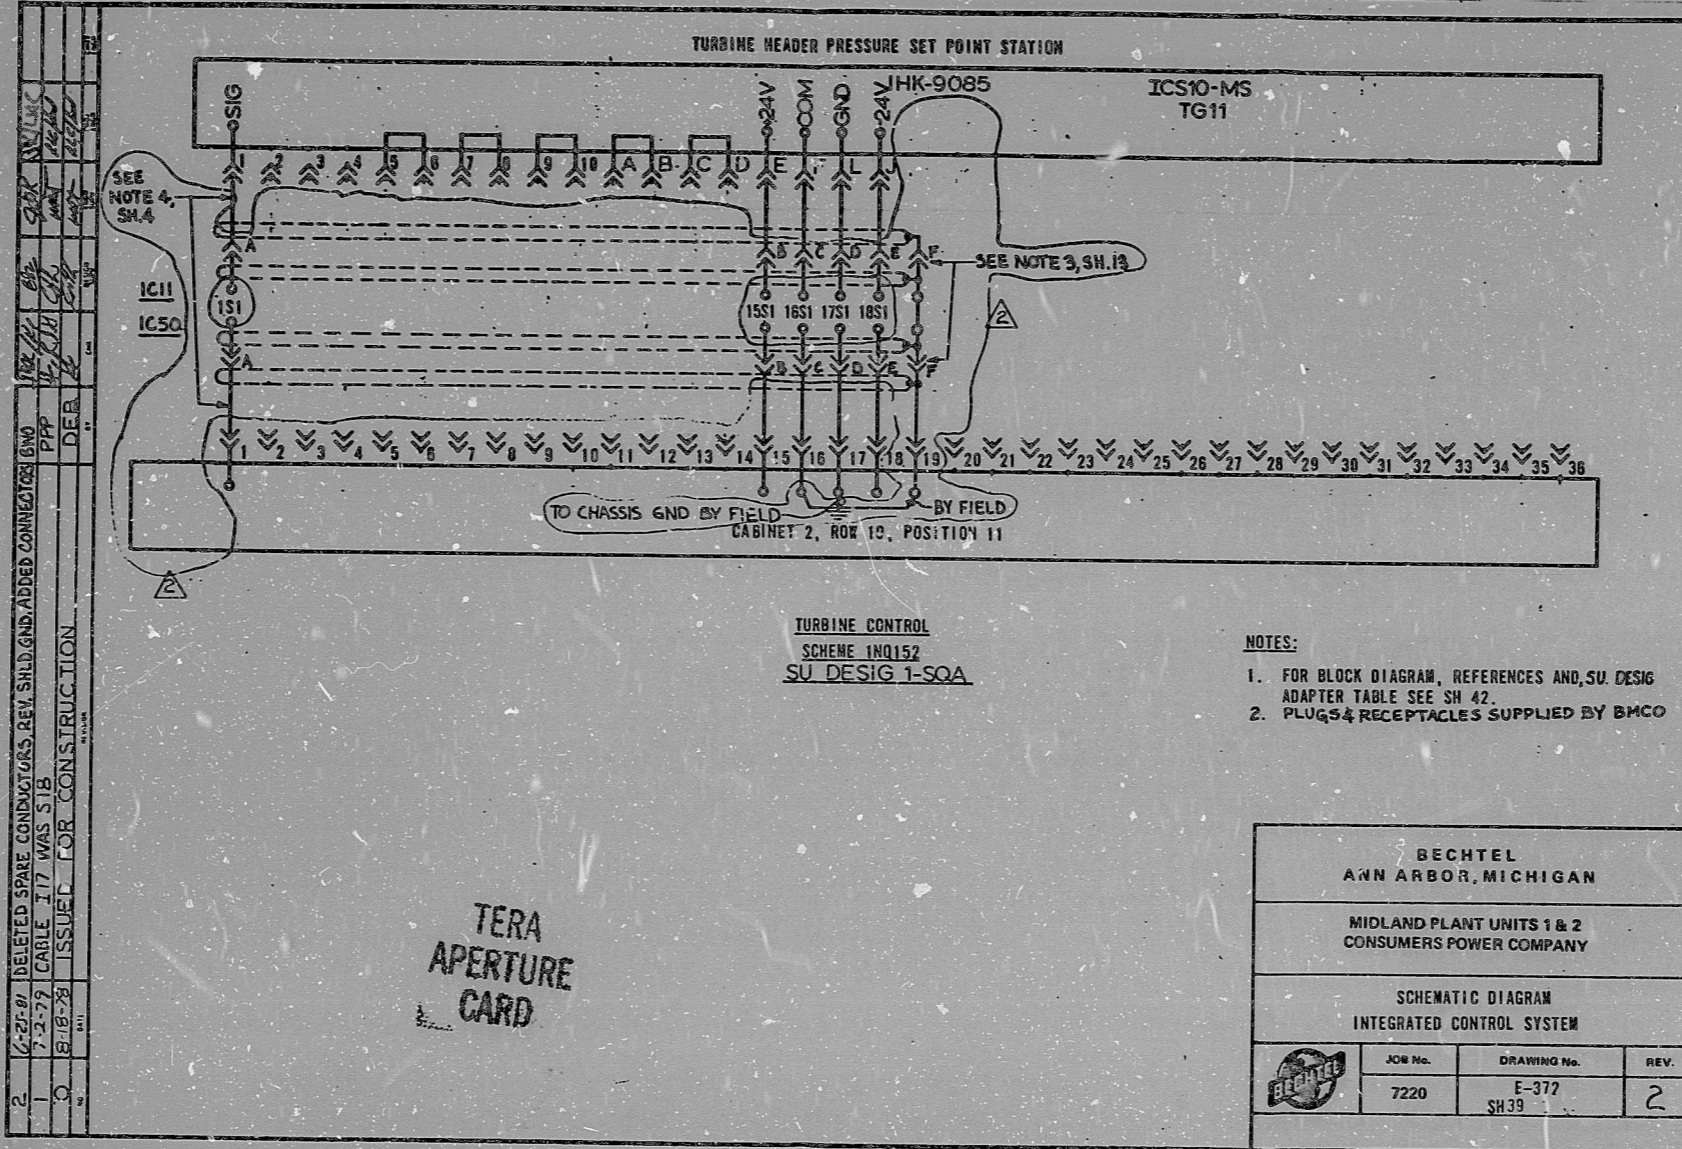

TERA  
APERTURE  
CARD

78

"I certify that the image contained on this frame was made in the normal and regular course of business, on the date stated below and that it is an accurate reproduction of the document submitted to the contractor for filing, by Bechtel Power Corporation.

**16X**

10-28-81 R. Lapelle J. Charnas  
DATE CAMERA OPERATOR CONTRACTOR'S SUPERVISOR OR MANAGER



RIDS

8112280143

