


22"
17"
11"
8.5"
8.5"
11"
17"
22"

22"
17"
11"
8.5"
8.5"
11"
17"
22"

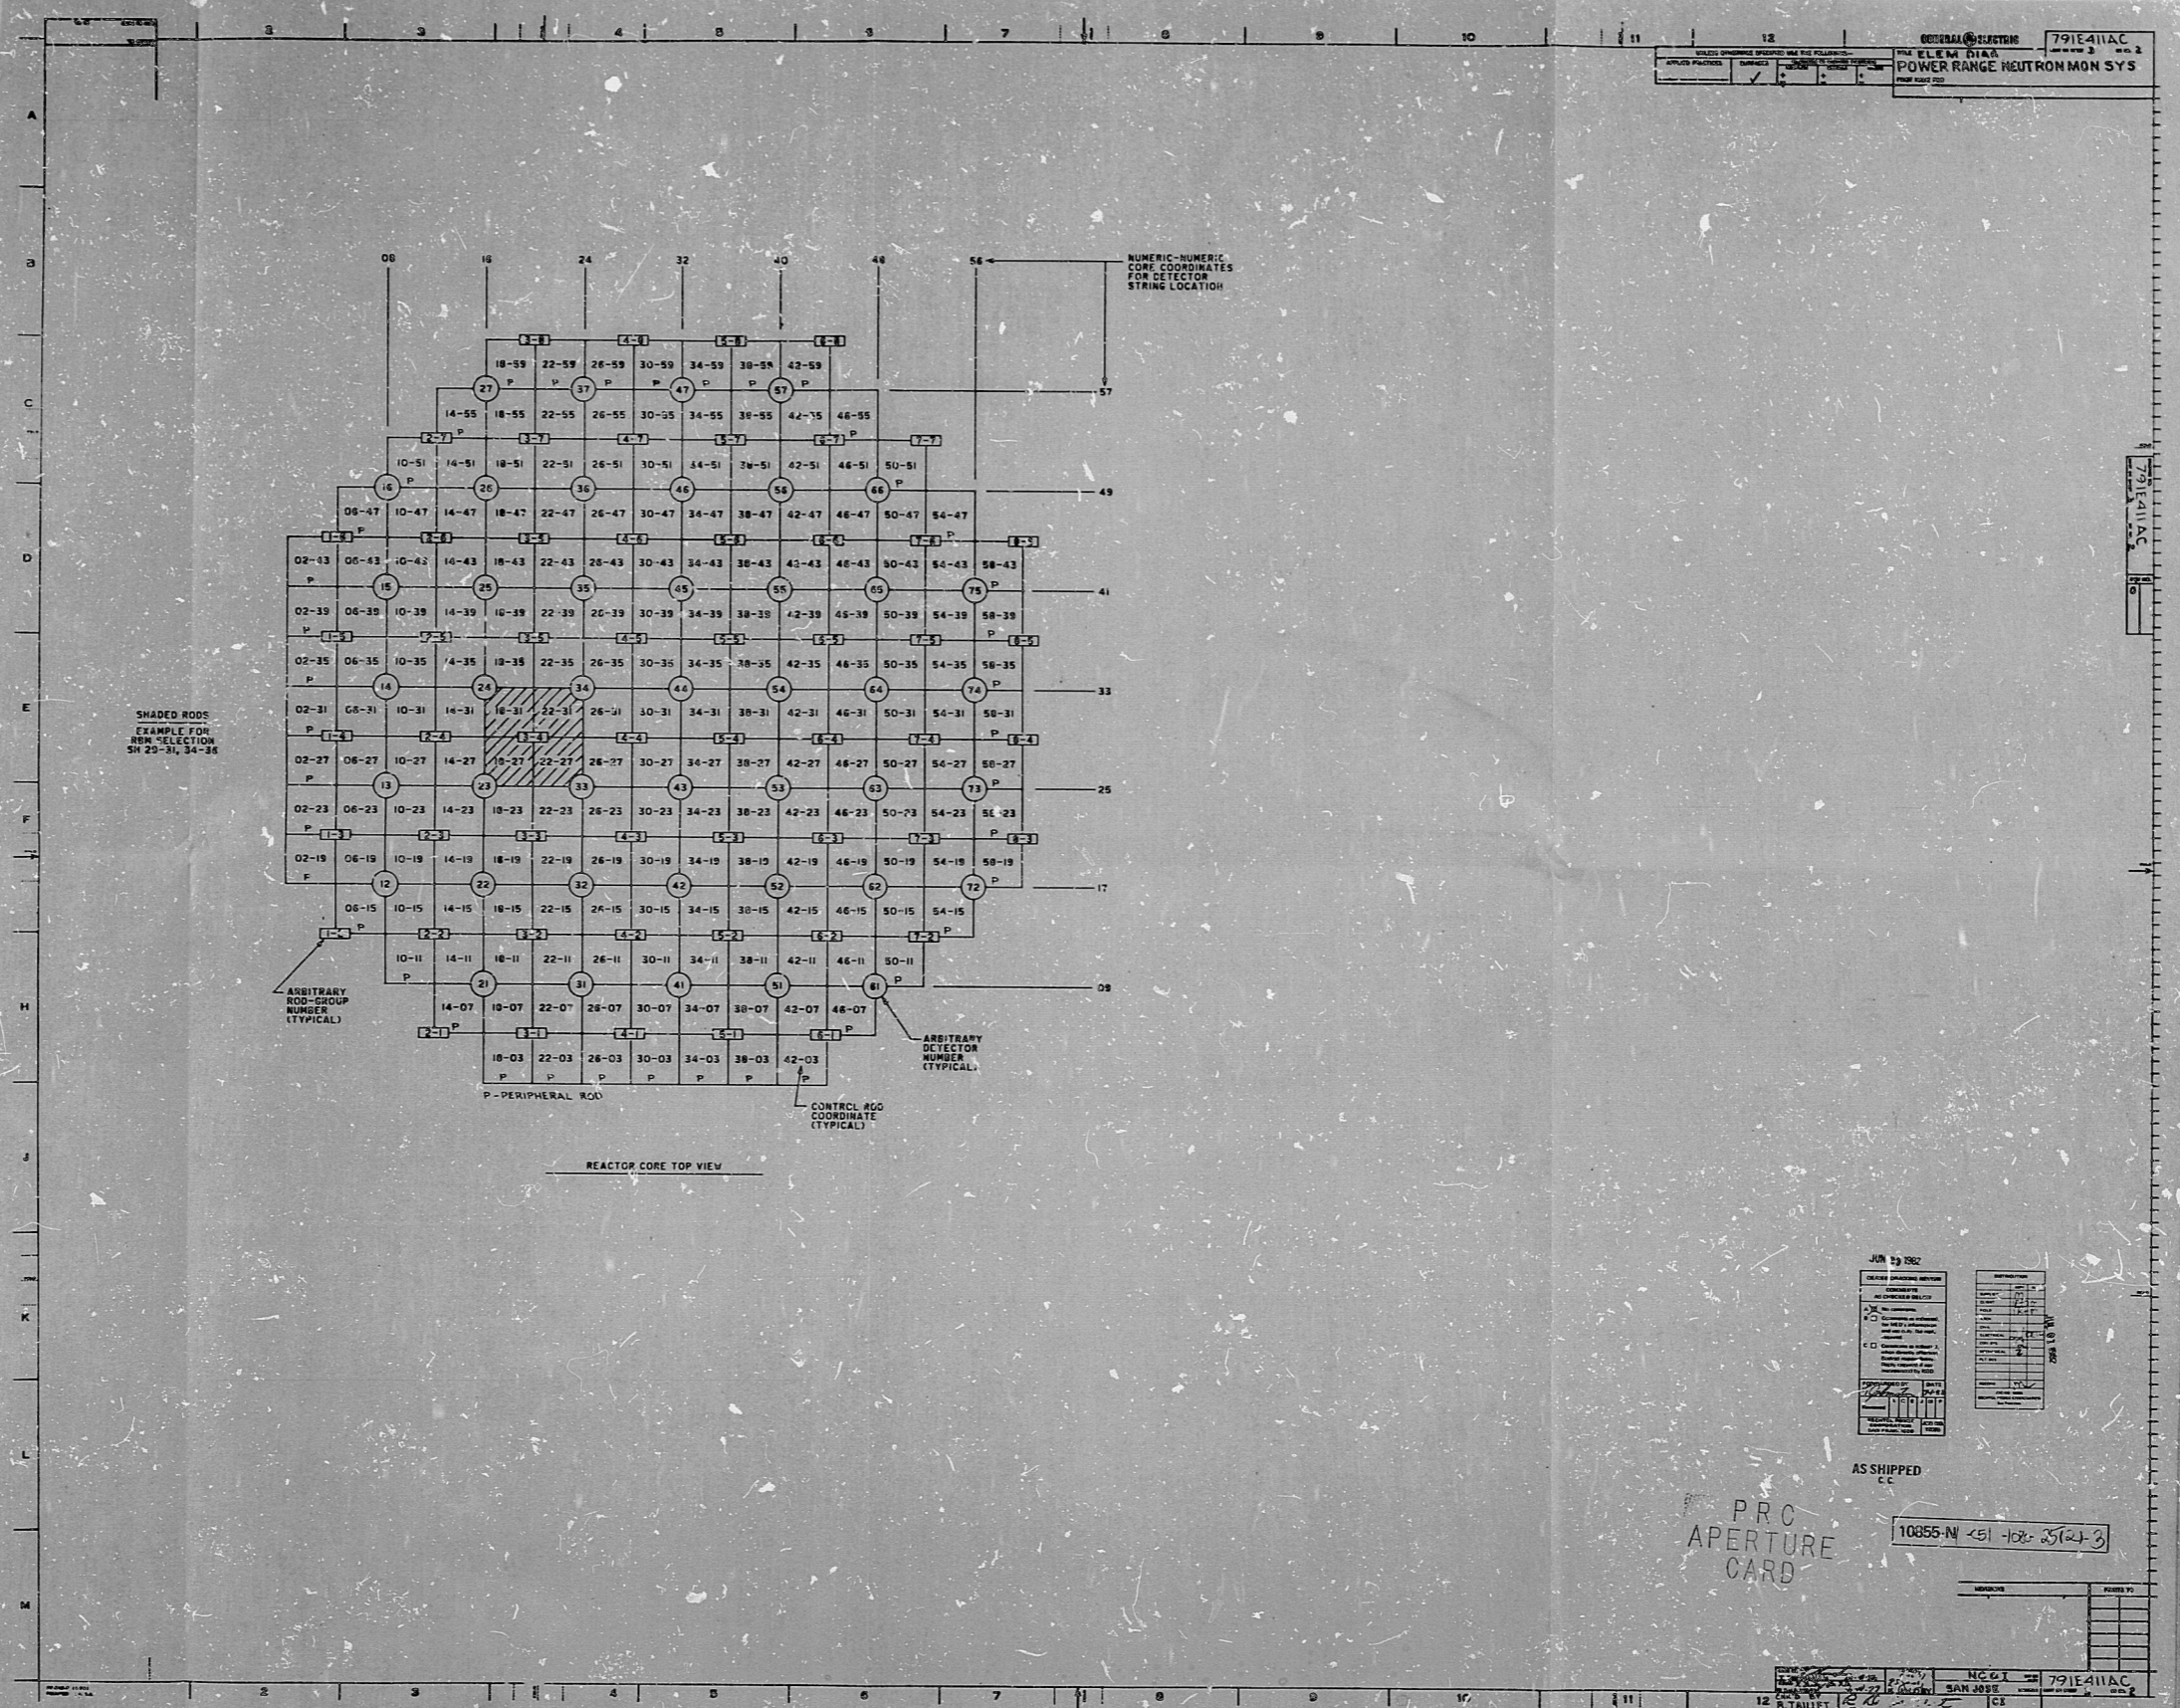

JUN 23 1960

AS SHIPPED

PRO APERTURE CARD

10855-NI <51-102-25(2)-3>

791E111AC

12 ATALLET

RIDS

83072900/0

