


This drawing and the design it covers are the property of BECHTEL. They are hereby loaned and on the borrower's express agreement that they will not be reproduced, copied, loaned, exhibited, or used except in the limited way and for the purpose intended by the lender to the borrower.

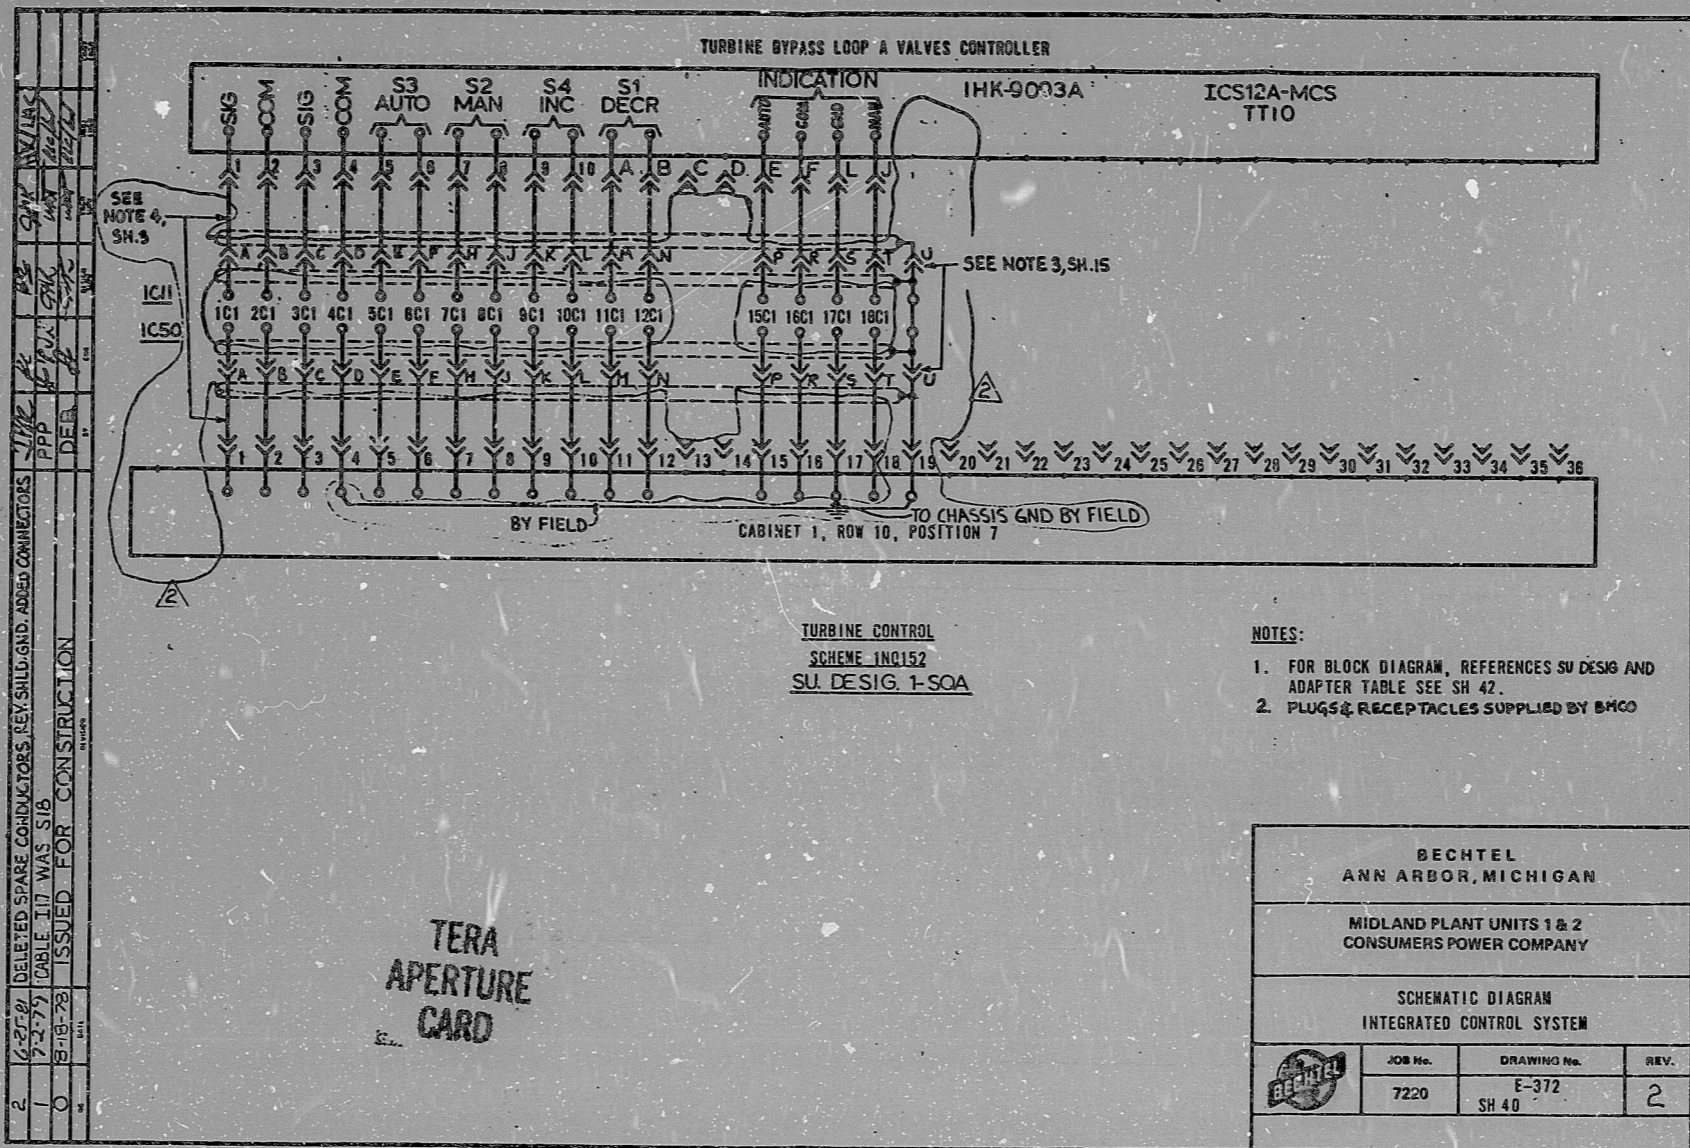

REV	DATE	BY	CHKD	APP'D	REASON
2	6-27-81				DELETED SPARE CONDUCTORS. REV. SHLD. GND. ADDED CONNECTORS
1	7-2-79				CABLE 117 WAS SIB
0	8-18-78				ISSUED FOR CONSTRUCTION

TERA APERTURE CARD

- NOTES:
1. FOR BLOCK DIAGRAM, REFERENCES SU DESIG AND ADAPTER TABLE SEE SH 42.
 2. PLUGS & RECEPTACLES SUPPLIED BY BMO

BECHTEL ANN ARBOR, MICHIGAN		
MIDLAND PLANT UNITS 1 & 2 CONSUMERS POWER COMPANY		
SCHEMATIC DIAGRAM INTEGRATED CONTROL SYSTEM		
JOB No.	DRAWING No.	REV.
7220	E-372 SH 40	2

"I certify that the image contained on this frame was made in the normal and regular course of business, on the date stated below and that it is an accurate reproduction of the document submitted to the contractor for filing, by Bechtel Power Corporation.

10-28-81 R. Capella
DATE CAMERA OPERATOR

[Signature]
CONTRACTOR'S SUP'VR OR MANAGER

16X

8.5" 11"

11" 8.5"

8.5" 11"

8.5" 11"

17"

17"

RIDS

8112280148

