


This drawing and the design it covers are the property of BECHTEL. They are hereby loaned and on the borrower's express agreement that they will not be reproduced, copied, loaned, exhibited, or used except in the limited way and phrase use permitted by any written consent given by the lender to the borrower.

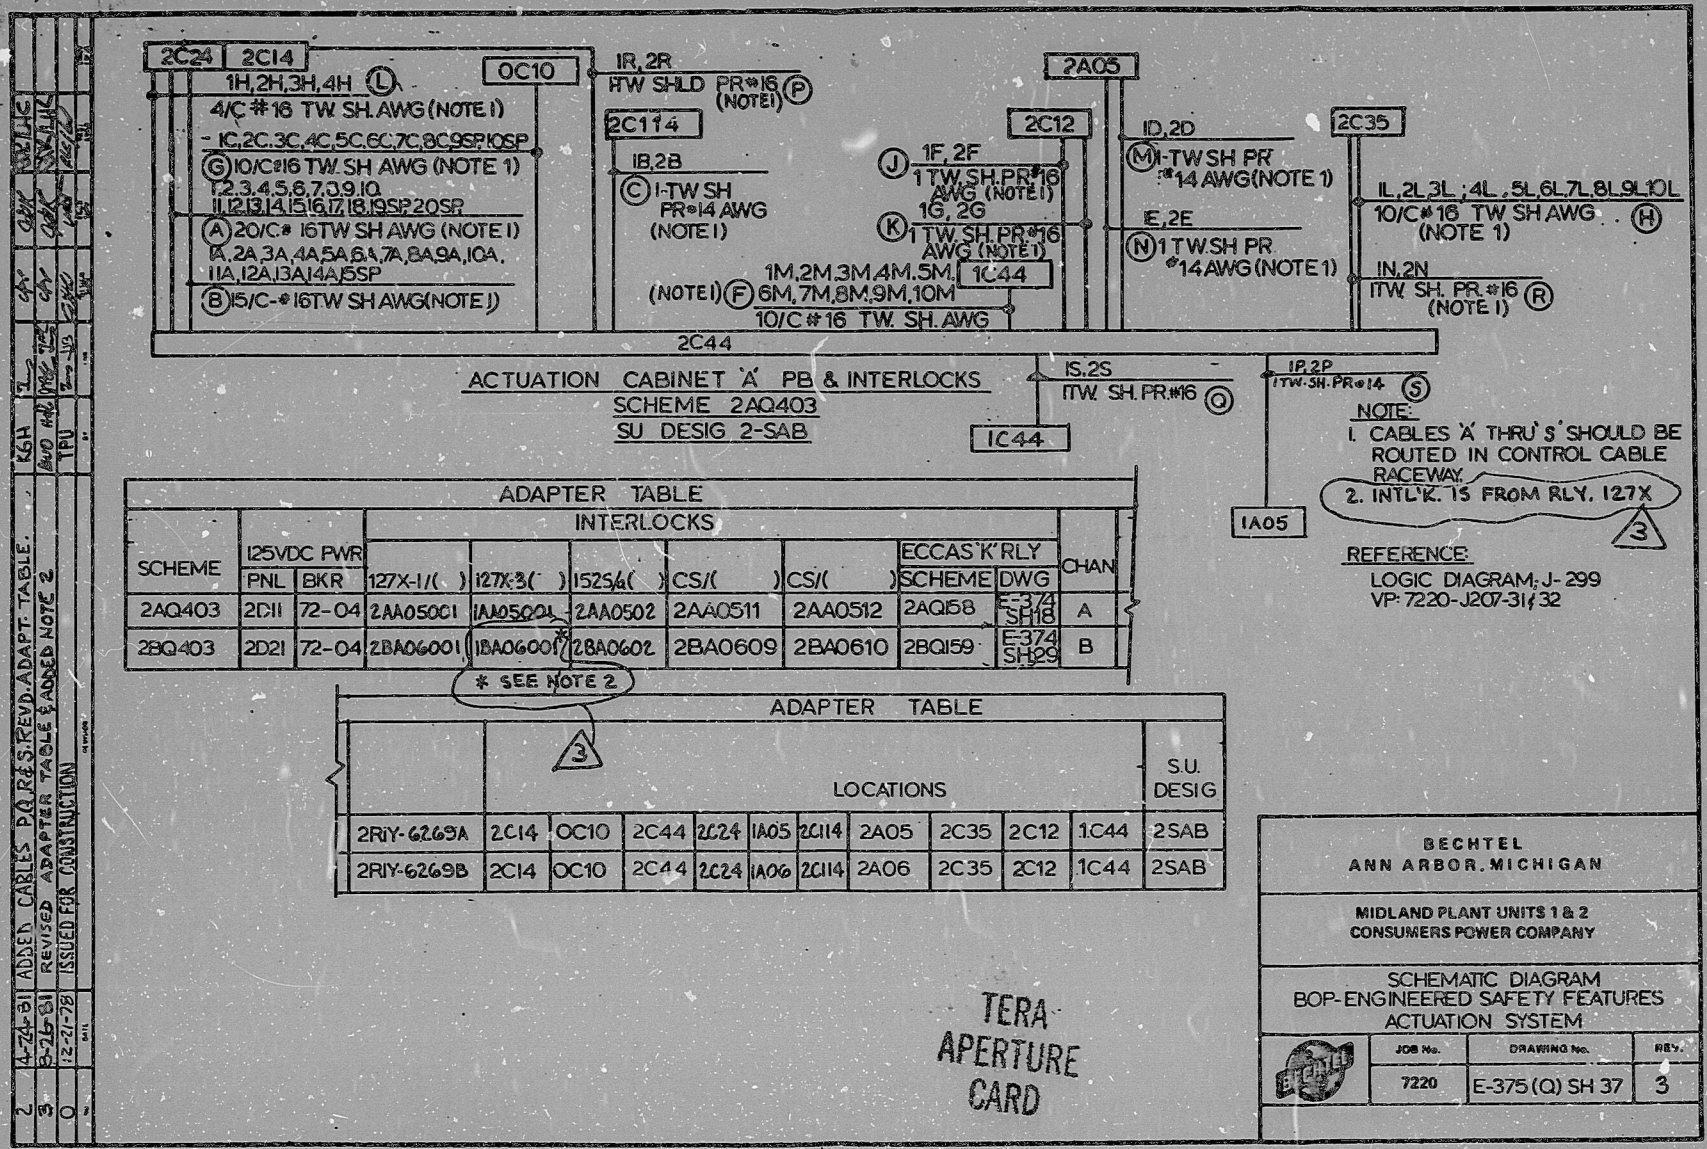

1	4-24-81	ADDED CABLES TO P&S, REV'D ADAPT. TABLE.
2	5-25-81	REVISED ADAPTER TABLE & PASSED NOTE 2.
3	12-27-79	ISSUED FOR CONSTRUCTION.

SCHEME	125VDC PWR		INTERLOCKS				ECCAS 'K' RLY		CHAN	
	PNL	BKR	127X-1(I)	127X-3(I)	15254(I)	CS(I)	CS(I)	SCHEME		DWG
2AQ403	2D11	72-04	2AA05001	1AA05001	2AA0502	2AA0511	2AA0512	2AQ158	E-374 SH18	A
2BQ403	2D21	72-04	2BA06001	1BA06001	2BA0602	2BA0609	2BA0610	2BQ159	E-374 SH29	B

	LOCATIONS								SU. DESIG		
	2RIY-6269A	2C14	OC10	2C44	2C24	1A05	2C114	2A05		2C35	2C12
2RIY-6269A	2C14	OC10	2C44	2C24	1A05	2C114	2A05	2C35	2C12	1C44	2SAB
2RIY-6269B	2C14	OC10	2C44	2C24	1A06	2C114	2A06	2C35	2C12	1C44	2SAB

BECHTEL  
ANN ARBOR, MICHIGAN

MIDLAND PLANT UNITS 1 & 2  
CONSUMERS POWER COMPANY

SCHEMATIC DIAGRAM  
BOP-ENGINEERED SAFETY FEATURES  
ACTUATION SYSTEM

JOB No.	DRAWING No.	REV.
7220	E-375 (Q) SH 37	3

TERRA  
APERTURE  
CARD

16X

"I certify that the image contained on this frame was made in the normal and regular course of business, on the data stated below and that it is an accurate reproduction of the document submitted to the contractor for filing, by Bechtel Power Corporation."

10-28-81 DATE  
 R. Capelle CAMERA OPERATOR  
 J. Williams CONTRACTOR'S SUP'VR OR MANAGER



RIDS

81/2280/89

