


22  
17  
11  
8.5  
8.5  
11  
17  
22

22  
17  
11  
8.5  
8.5  
11  
17  
22

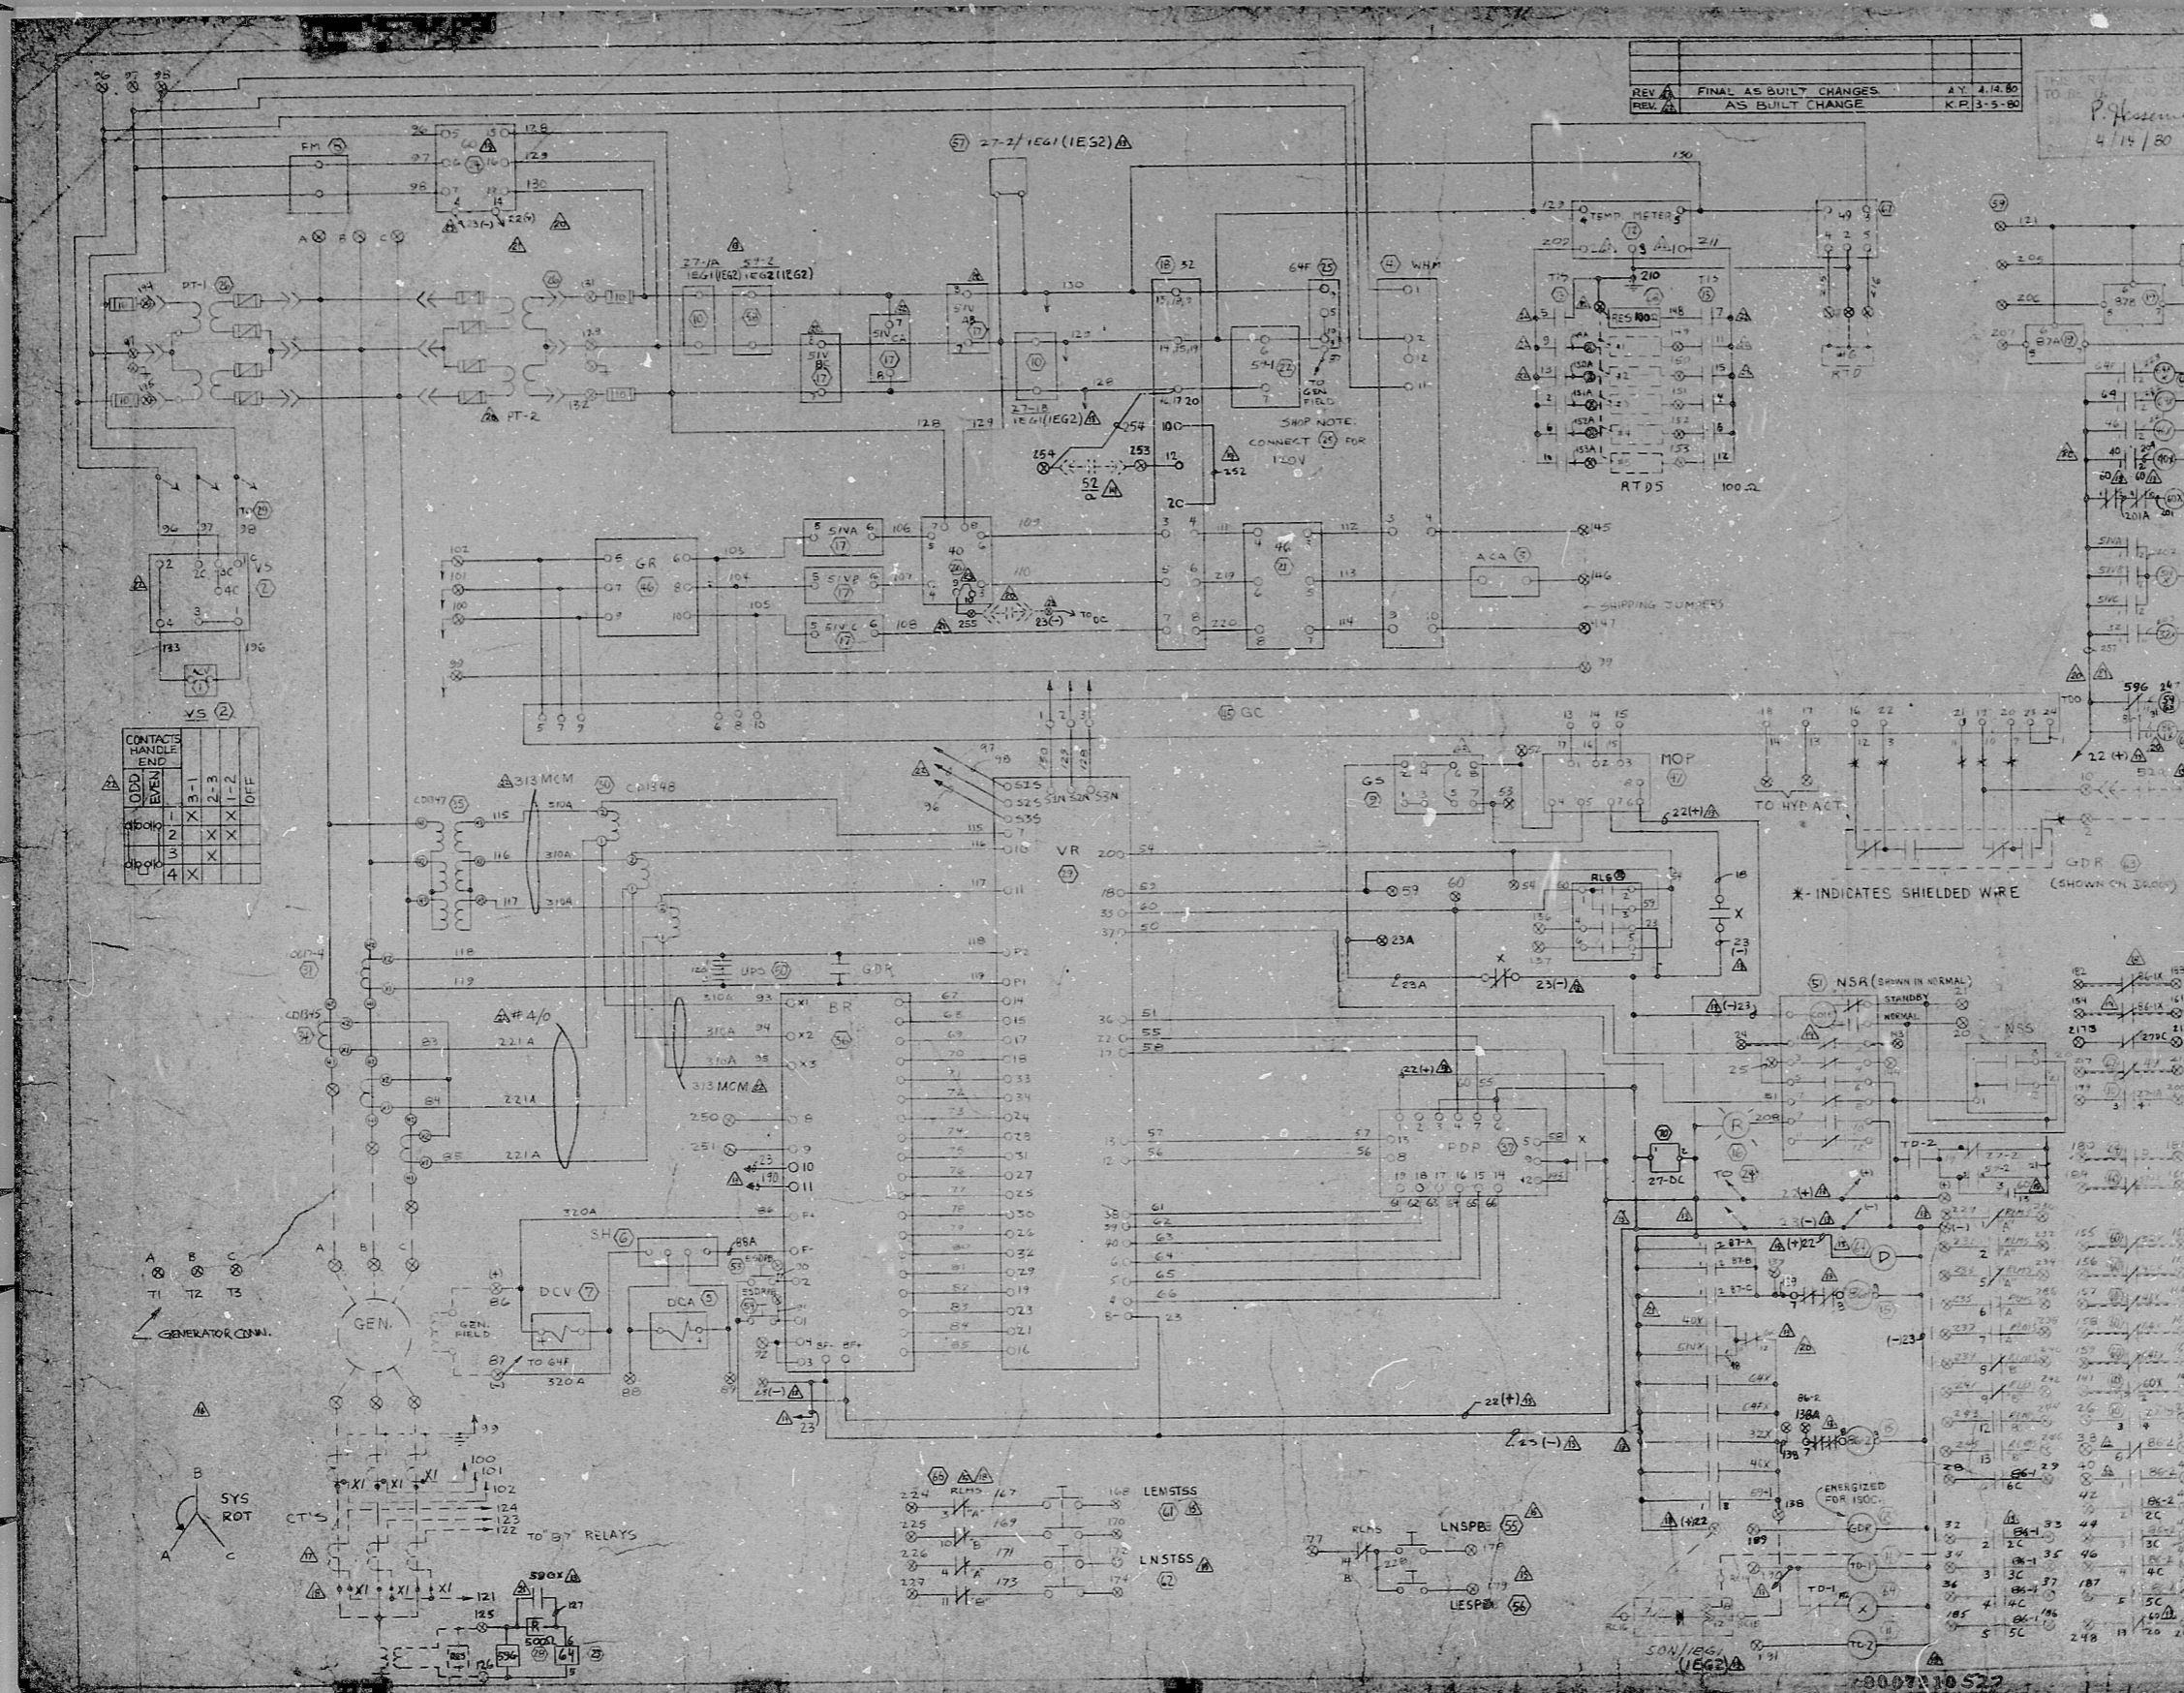

REV	DESCRIPTION	DATE
REV 1	FINAL AS BUILT CHANGES	AY 4/14/80
REV 2	AS BUILT CHANGE	KP 3-5-80

- REVISIONS**
- INDICATES TERMINAL FOR EXTERNAL CONNECTION
  - INDICATES BILL OF MATERIAL ITEM NUMBER
  - 1. DOTTED WIRING IS EXTERNAL BY OTHERS
  - 2. ALL WIRING FROM 'A' BANK OF RLMS MUST BE SEPARATED FROM 'B' BANK (INCLUDING TERM BLK.)
  - 3. --- INDICATES NON-IE SIGNALS, RUN THROUGH SEPARATE CONDUIT AND TERMINAL BLOCKS
  - 4. TAG NOS \*TRAIN 'A' - 1DG-01B \*TRAIN 'B' - 1DG-02B

\* INDICATES SHIELDED WIRE (SHOWN ON 3800)

REV	DESCRIPTION	DATE
REV 17	REVISED '87' RELAY CT CONN.	JAE 2-3-79
REV 16	DWG POLARITY DIAG REMOVED	J.E. 12-15-78
REV 15	REV. PER LTR DTD 11-6-78	J.E. 11-22-78
REV 14	CONT. 52/4 & WIRE #'S 252, 253 & 254 ADDED	J.E. 7-24-78
REV 13	REV. PER MARKED UP PRINT 3-5-78	J.E. 5-15-78
REV 12	REV. PER LETTER DTD 11-16-78	J.E. 2-27-79
REV 11	AS BUILT DWG	J.E. 11-22-78
REV 10	REV. PER LETTER DTD 11-01-77	H.S. 10-19-77
REV 9	CORRECTLY CALL-OUTS	D.E.S. 10-26-77
REV 8	REV. PER LETTER DTD 10-10-77	D.E.S. 10-26-77
REV 7	MISC. REV.	H.S. 9-22-77
REV 6	MISC. REV.	H.S. 8-23-77
REV 5	MISC. REV.	H.S. 6-27-77
REV 4	REV. PER MARKED UP DWG	TH 5-8-77
REV 3	REV. PER MARKED UP DWG	TH 4-7-77
REV 2	GENERAL REVISION	TH 2-6-77
REV 1	REVISED PHYSICAL ARRANGEMENT	TH 2-2-77

**SCHEMATICS**  
DIESEL GENERATOR LOCAL CONTROL SYSTEM  
100% NOCHIE PBAK NUN LEAR SYSTEM UNITS 1 & 2  
TERA APERTURE CARD

TECHNICAL SERVICES, INC.

GIBSON HILL, INC.  
DELAVAL 9051615

Post Office Box 1905  
705 N. Cowden  
Tel: 909-468-2021  
Long Beach, California 90801

DWG No. D54925-3  
REV 3

PDR

8007210527

