


SECTION "C-C"
SCALE: 1/4" = 1'-0"

SEE NF-39357-8 FOR ADDITIONAL PIPING, ELECTRICAL AND H.V.V. IN THIS AREA

THIS DWG. MAY NOT REFLECT ALL THE AS BUILT CONDITIONS AND NO FURTHER CHANGES WILL BE MADE ON IT

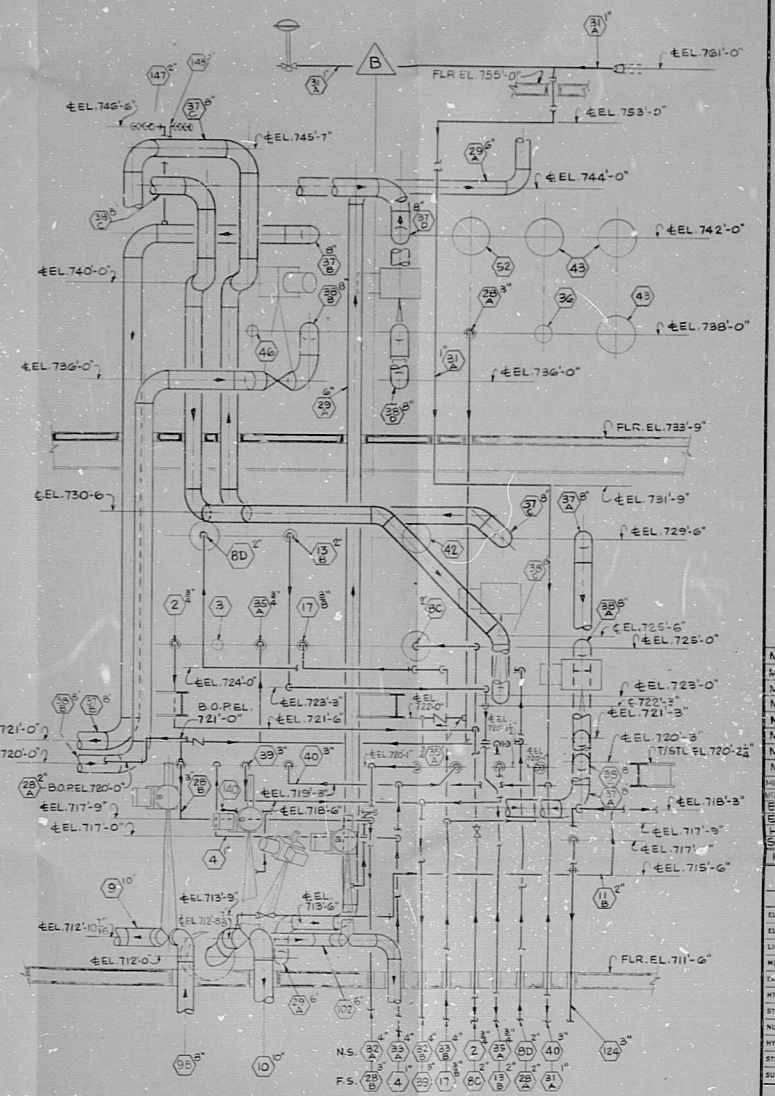

SECTION "D-D"
SCALE: 1/4" = 1'-0"

FOR NOTES AND LEGEND SEE DWG. NF-39357-1

TERA APERTURE CARD



REVISIONS	
1	RELEASED FOR REF. INFORMATION 7-14-72 FILMED 7-17-72
2	UPDATED WITH LATEST PHYSICAL PIPING ELECT. & H.V.V. CHANGES RELEASED FOR CONSTRUCTION DATE: 7-14-73 APPROVED: [Signature] FILMED 7-17-73
3	FINAL ISSUE

ITEM	DATE
MECH 305-1E	8-11-73
MECH 305-1E	8-11-73
ELECT 451-2	8-11-73
ELECT 451-3	8-11-73
H.V.V. 612-2010-217	8-11-73
STRUCT 305-1E	8-11-73

DESIGN SECTION APPROVALS		
SECTION	INITIALS	DATE
ELECTRICAL	[Initials]	8-11-73
ELEC CONTROL	[Initials]	8-11-73
LIGHTING	[Initials]	8-11-73
Mechanical	[Initials]	8-11-73
Structural	[Initials]	8-11-73

I HEREBY CERTIFY THAT THIS PLAN WAS PREPARED BY ME OR UNDER MY DIRECT SUPERVISION AND THAT I AM A DULY REGISTERED PROFESSIONAL ENGINEER UNDER THE LAWS OF THE STATE OF MINNESOTA.

DATE: 2-14-73
REV. NO. 12293

DESIGNER	J.A.G.	SCALE	AS SHOWN
CHECKED	[Initials]		
APPROVED	[Signature]		
DATE	7-14-72		
PROJECT NO. & DWG. NO.	21 6197	SHEET	7 OF 9

PRAIRIE ISLAND NUCLEAR GENERATING PLANT
UNIT 1 & 2 - RED WING, MINN. SOTA
**REACTOR BUILDING PIPING - UNIT 2
COMPOSITE; SECTIONS C-C & D-D**

Designed By
Pioneer Service & Engineering Co.
Chicago

NORTHERN STATES POWER COMPANY
ENGINEERING DEPARTMENT
MINNEAPOLIS

PROJECT NO. & DWG. NO. 21 6197 SHEET 7 OF 9
NF-39357-7B

12

11

10

9

8.5

8

7

6

5

4

3

2

RDS-PDR

8102040643

