




991-W

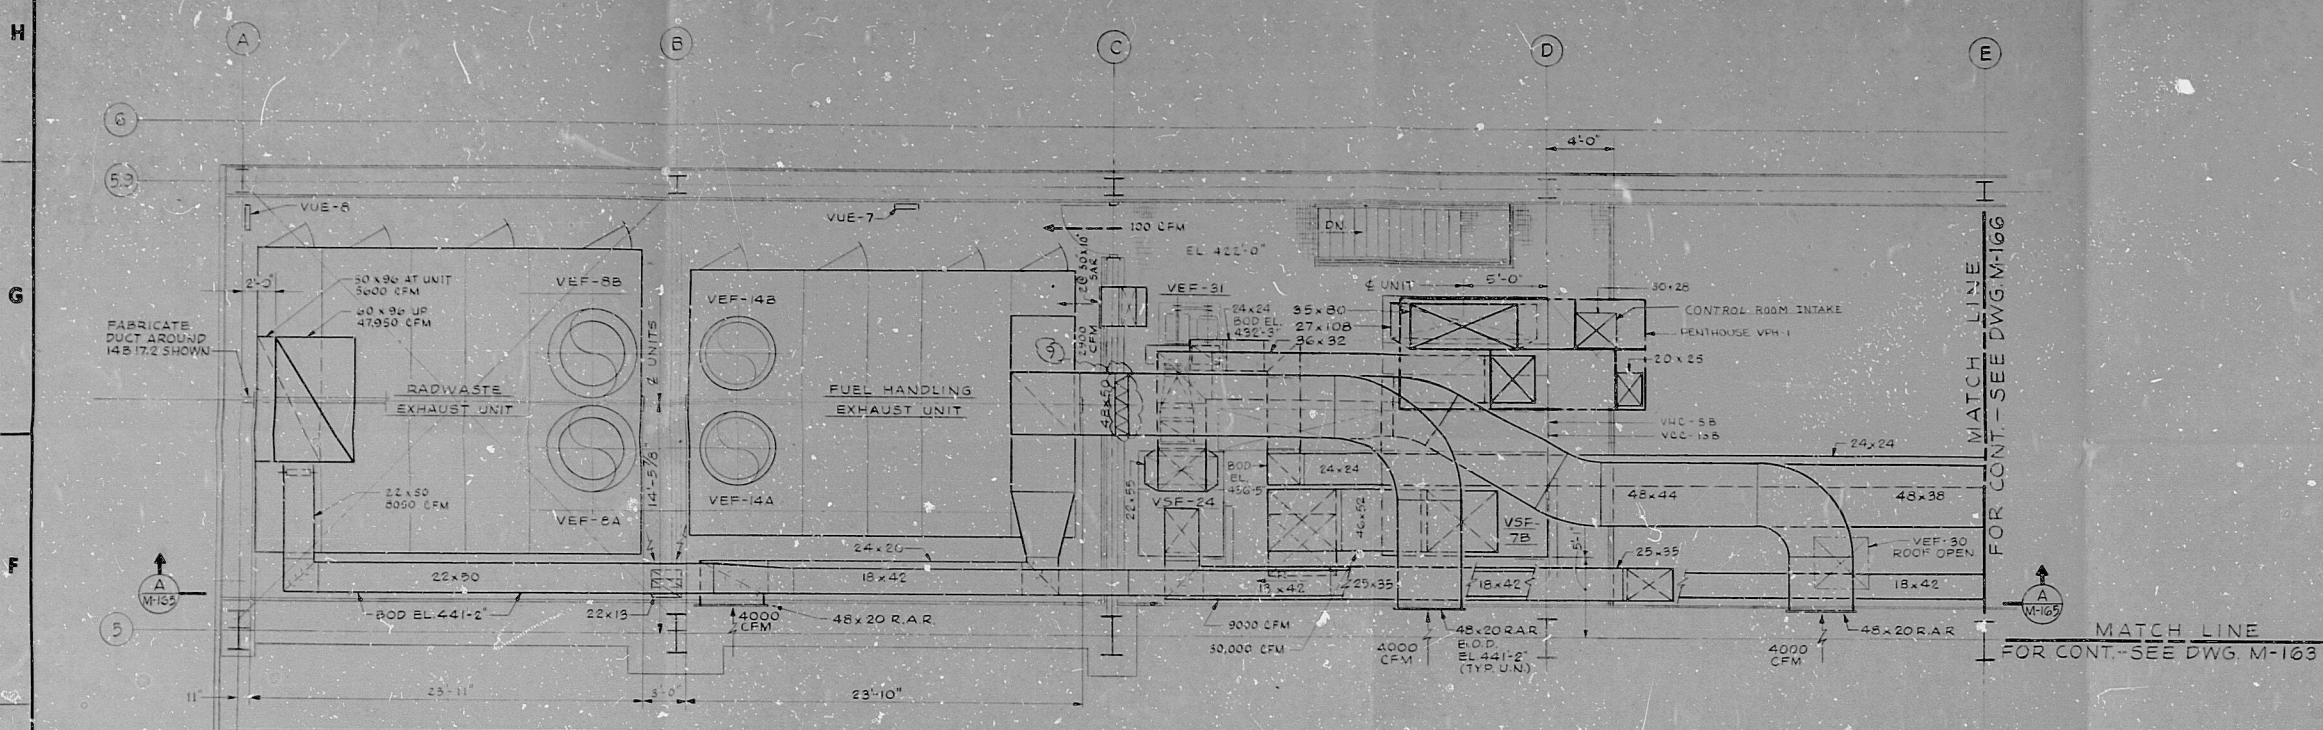


PLAN

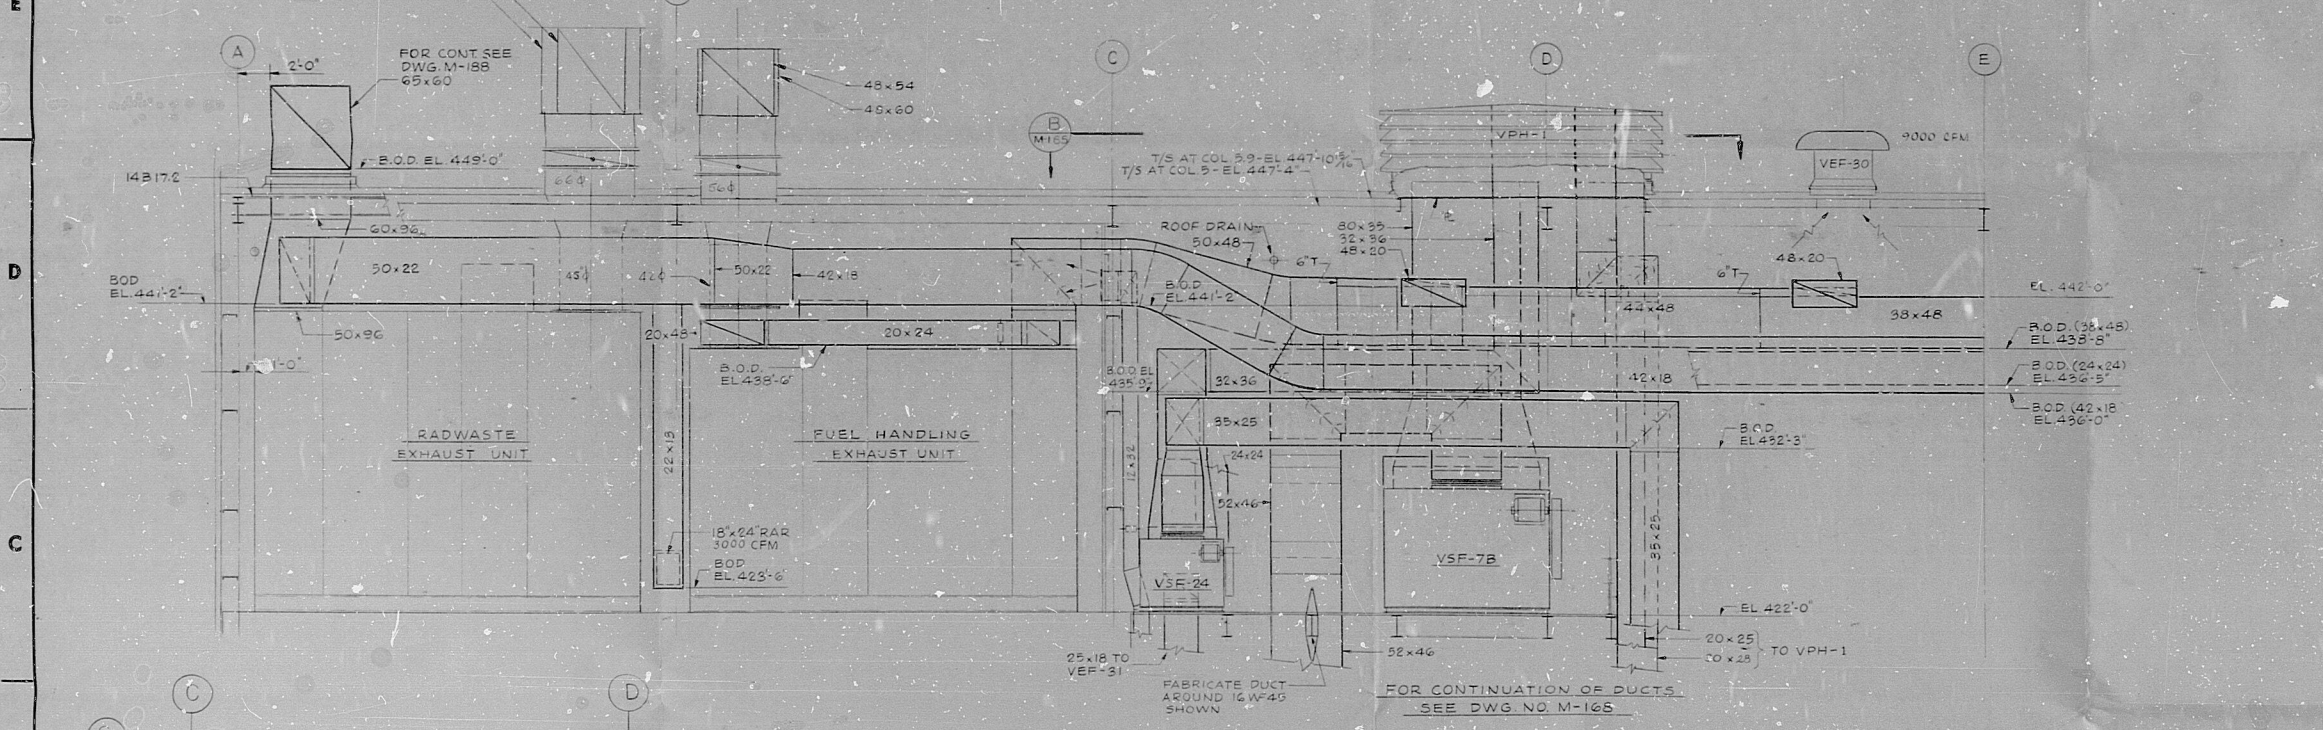

SECTION A

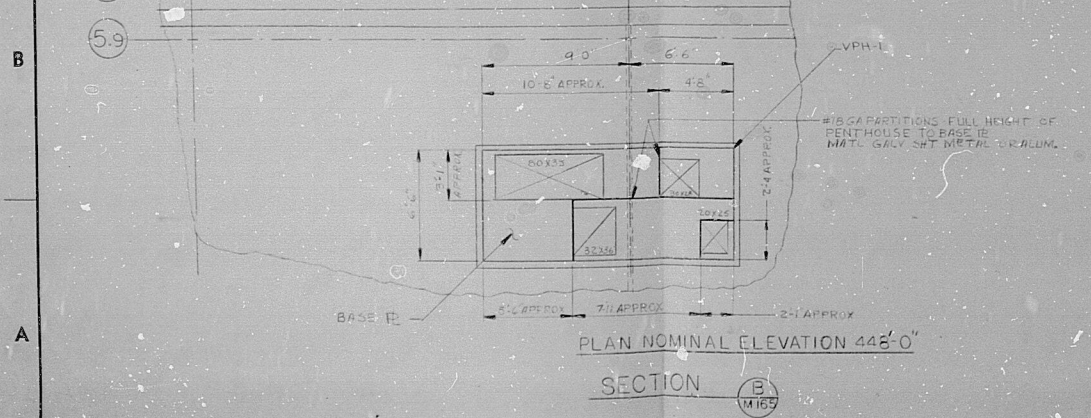

SECTION B

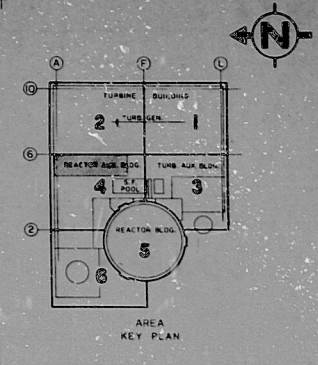

NOTES

1. FOR GENERAL NOTES AND DRAWING INDEX, SEE DWG. NO. M-178.
2. ALL ELECTRIC UNIT HEATERS (VUE) TO BE MOUNTED 6' ABOVE FLOOR.
3. FOR BUILT-UP UNITS VEF-8A, VEF-8B, VEF-14A & VEF-14B, SEE DWG. NO. SA-M-330. UNITS TO BE SUPPLIED BY EQUIPMENT MANUFACTURER.
4. ALL SUPPLY AIR REGISTER DESIGNS ARE BASED ON CONNOR ENGINEERING CORP. TYPE SAHO OR TYPE SAHO.
5. ALL RETURN AIR OR EXHAUST REGISTER DESIGNS ARE BASED ON CONNOR ENGINEERING CORP. TYPE RPHO.
6. FOR FOUNDATION DETAIL FOR RADWASTE EXHAUST AND FUEL HANDLING EXHAUST UNITS SEE CIVIL DWG. # C-107.
7. AT ALL KEYS METAL TAG TO FUEL HANDLING FLOOR EXHAUST SHUT-OFF DAMPER, MARKED "DO NOT CLOSE DAMPER UNLESS FUEL LOADING SHUTT DAMPERS ARE OPEN".

TERA
APERTURE
CARD

FOR INFORMATION ONLY
THIS DOCUMENT IS NOT TO BE USED FOR
CONSTRUCTION OR FOR ANY OTHER PURPOSE

1/5/76	AS BUILT ISSUED TO AFSL	BR	SG	RE	2	1/5/76
4/17/79	REVISED TO AS BUILT PER ADD'D PARTITIONS TO VPH-1 & SECTION B	HB	SG	RE	3	4/17/79
7/17/79	REVISED AND RELOCATED DUCT AS SHOWN	HB	SG	RE	4	7/17/79
4/10/80	REVISED AS SHOWN & ADDED NOTE 2	HB	SG	RE	5	4/10/80
1/5/81	RADWASTE DUCT REVISED TO SUIT UNIT DESIGN	HB	SG	RE	6	1/5/81
7/17/80	REVISED AS SHOWN	HB	SG	RE	7	7/17/80
1/4/81	ADDED UNIT HEATERS	HB	SG	RE	8	1/4/81
1/5/81	AS-BUILT PER DEN #1	HB	SG	RE	9	1/5/81
TOTAL 1/4" x 1/4" SHEETS 36TH/BRYAN DRAWN H.BRYAN BECHTEL CORPORATION SAN FRANCISCO ARKANSAS POWER & LIGHT COMPANY ARKANSAS NUCLEAR ONE HEATING, VENTILATING & AIR CONDITIONING AUXILIARY BUILDING EQUIPMENT RM. PLAN 4 SECT 4 UPPER LEVEL NORTH						
6600	M-165	1				

RIDS -RDR

8103180521

