


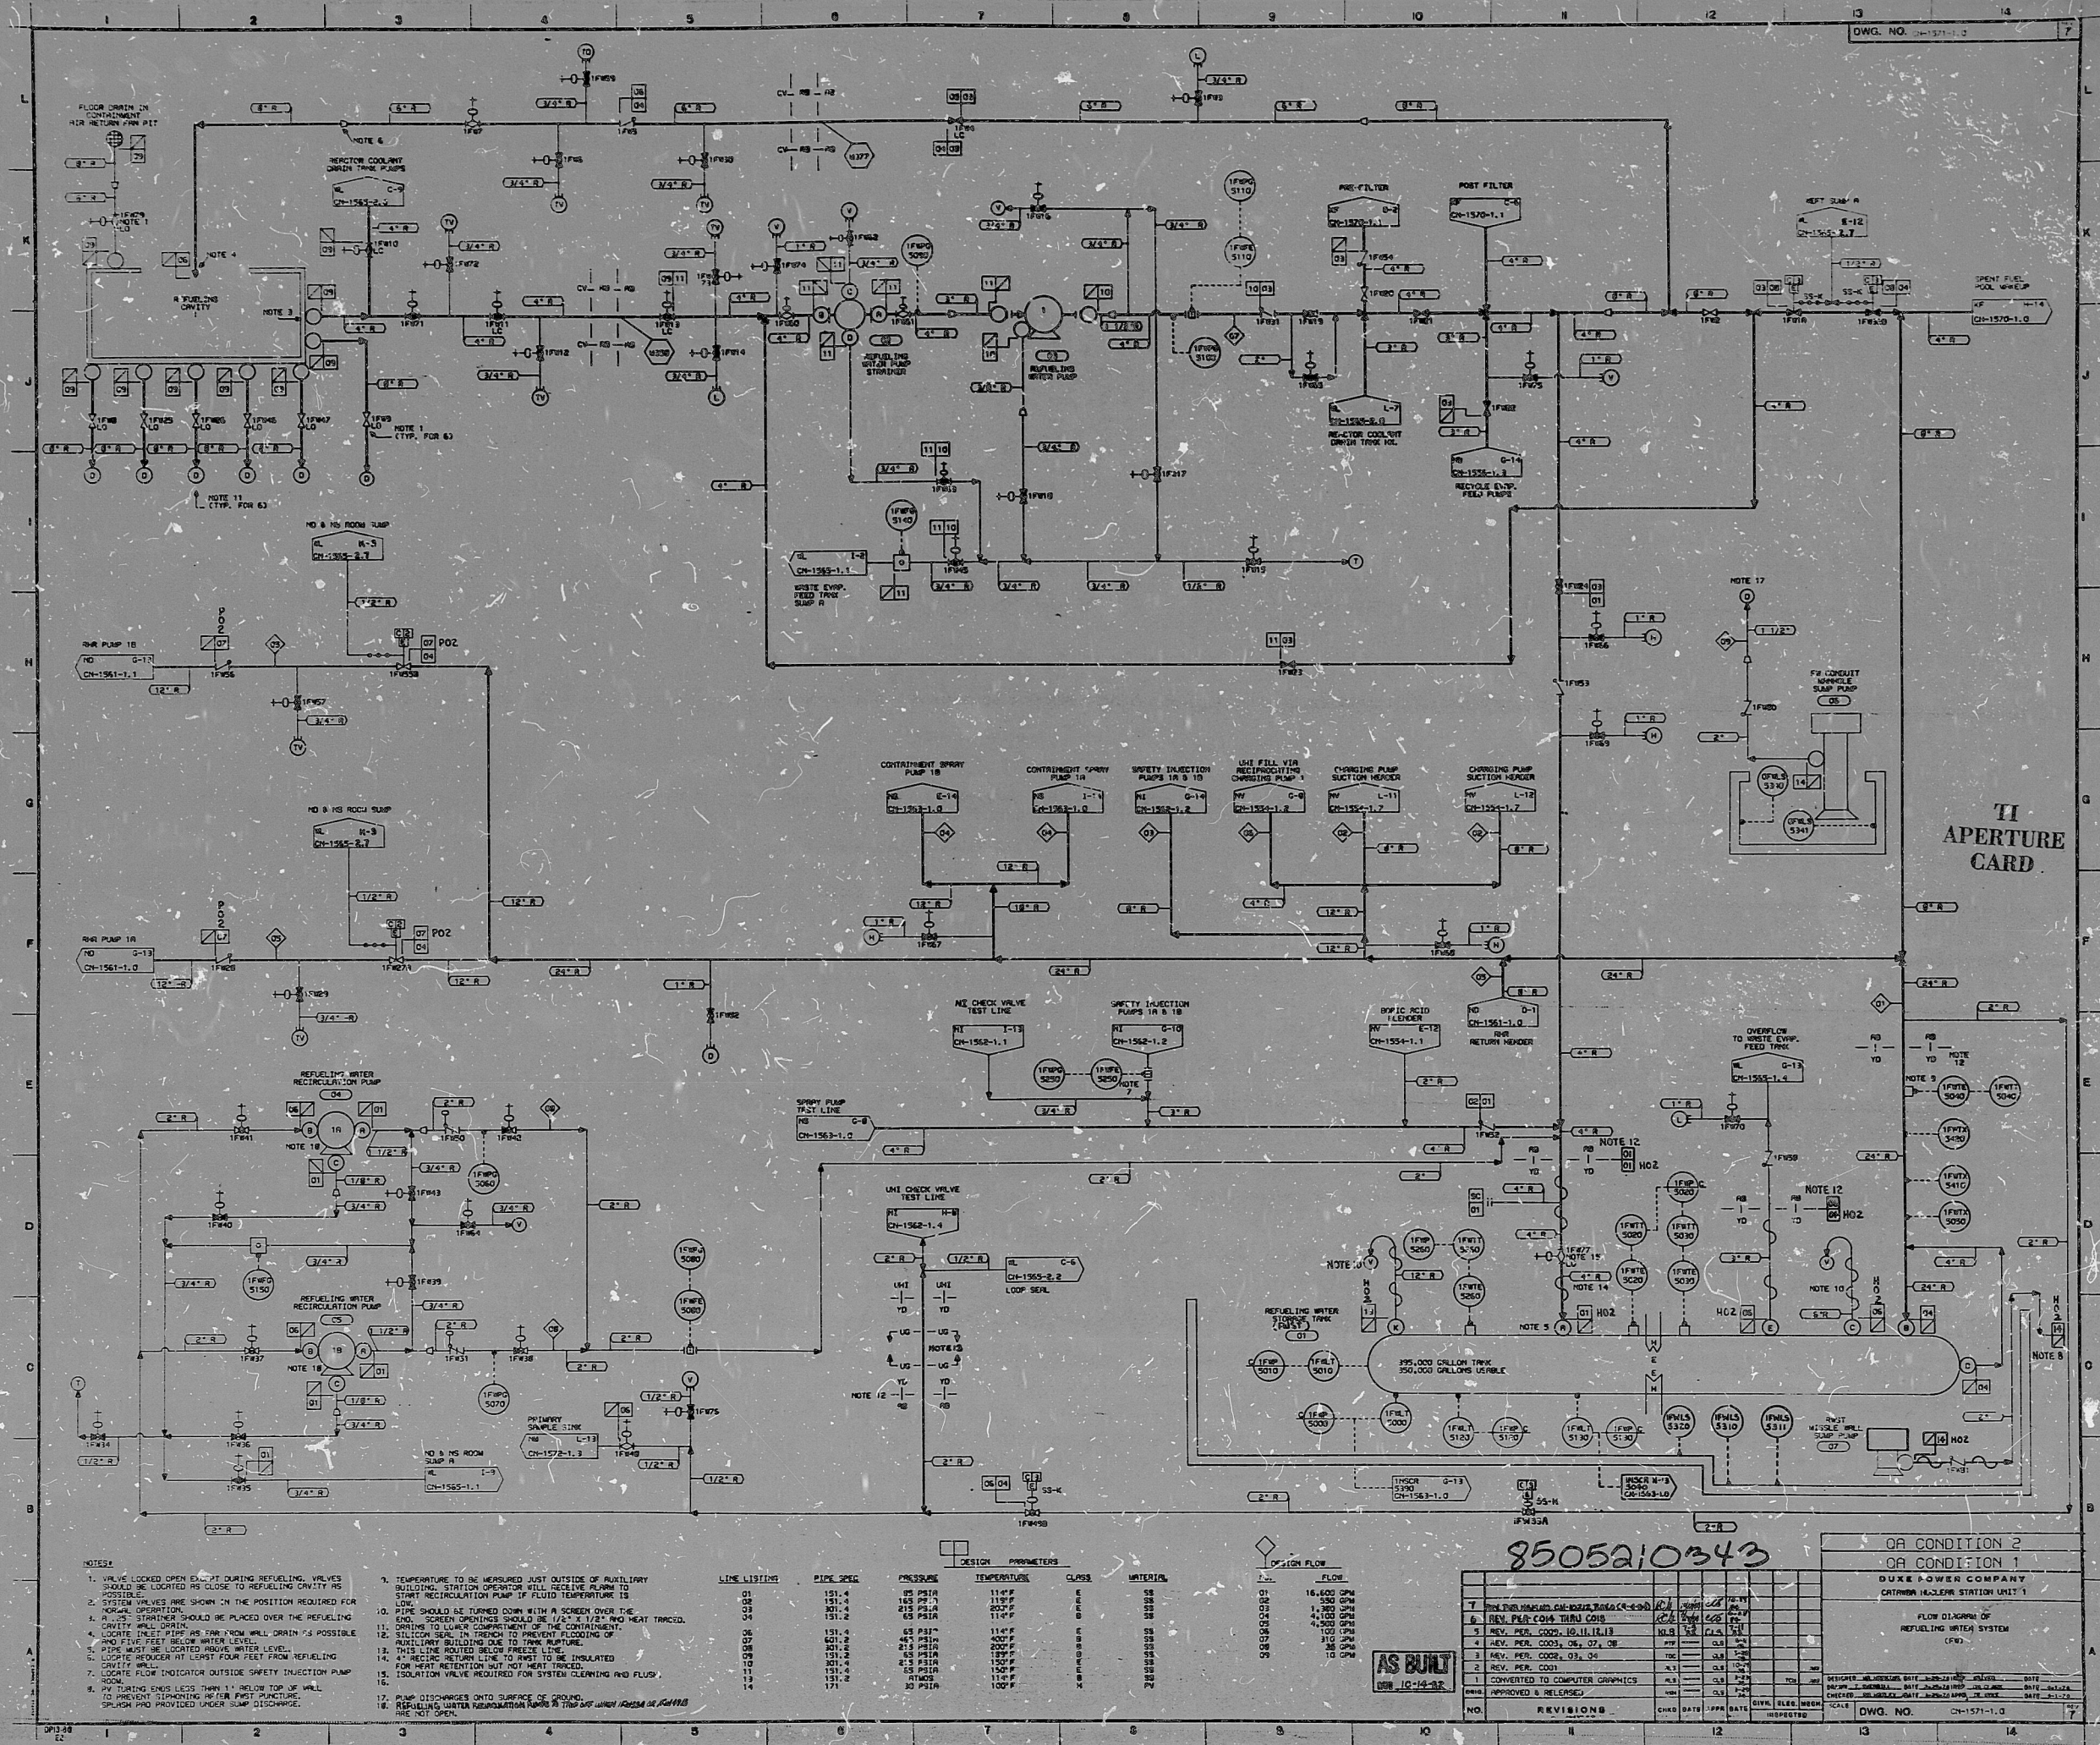

TI
APERTURE
CARD

8505210343

AS BUILT
REV. 10-14-82

QA CONDITION 2			
QA CONDITION 1			
DUKE POWER COMPANY			
CATHERINE HOLLER STATION UNIT 1			
FLOW DIAGRAM OF REFUELING WATER SYSTEM (FWS)			
A			
REVISION	DESCRIPTION	DATE	BY
1	AS BUILT	10-14-82	AS BUILT
2	AS BUILT	10-14-82	AS BUILT
3	AS BUILT	10-14-82	AS BUILT
PDR RIDS

8505210343

