
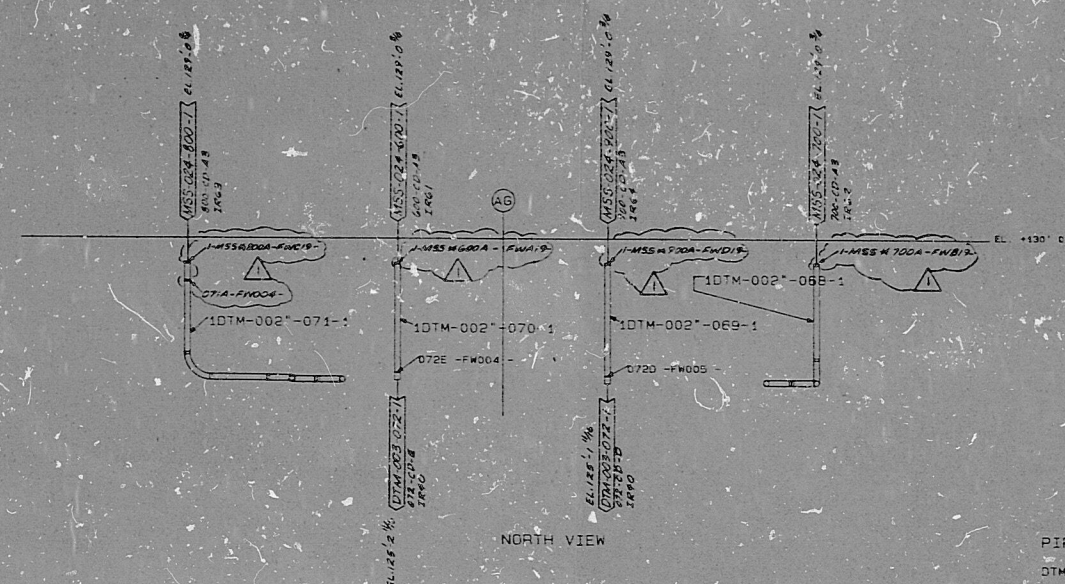


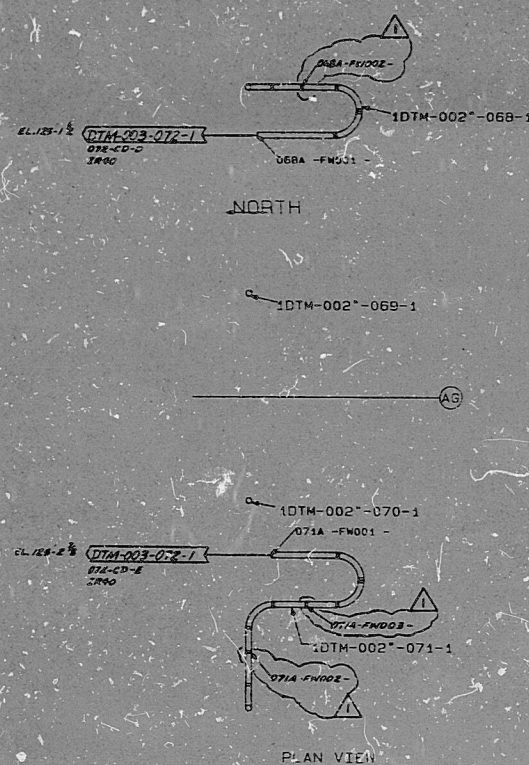

PIPELINES INCLUDED
 DTM-002-068-1
 DTM-002-069-1
 DTM-002-070-1
 DTM-002-071-1

TI
 APERTURE
 CARD

NOTES:
 1. ALL WELDS PREPARED BY DTM UNLESS OTHERWISE NOTED
 2. CONTAINERS FOR WELDING, FOR AS-BUILT SEE NOTE 2

REACTOR BUILDING
 DTM SYSTEM
 WELD LOCATION DRAWING

SCALE: 1/2" = 1'-0"
 FOR INFORMATION ONLY

REV	DATE	OWN	CHKD	APPR	DATE
1	12-1-85	MCP	1	155	8-8-85
PROJECT: RIVER BEND NUCLEAR PLANT					
BUILDING: REACTOR BUILDING					
DRAWING: 1483 REV. 1					
DATE: SEPT. 25, 1984					

PDR RIDS

85Q6Q7Q15Q

