


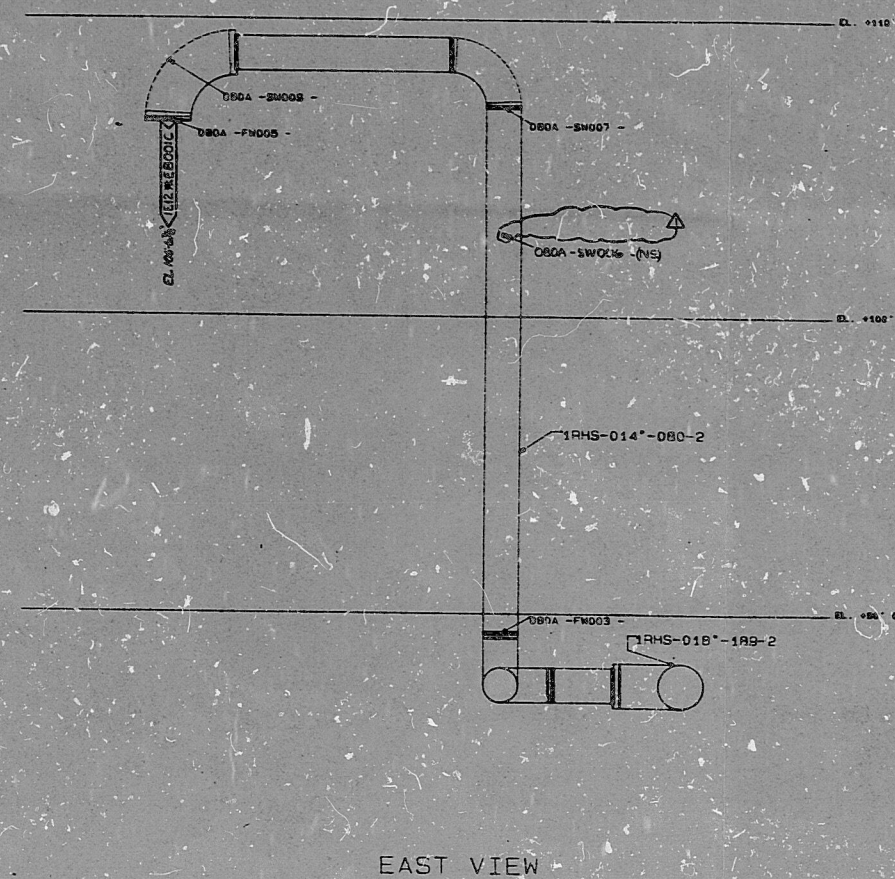

PIPELINES INCLUDED
1RHS-014-080-2
1RHS-018-199-2

TI
APERTURA
CARD

NOTES: 1. ALL WELDS PREFIXED BY IRHS &
2. CONTAINS FOR INFO ONLY, FOR AS-BUILTS SEE
ASME CD DRAWINGS

FOR INFORMATION ONLY

AUXILIARY BUILDING
RHS SYSTEM

WELD LOCATION DRAWING
SCALE: 1/2"=1'-0"

REV DATE DRAWN CHKD APPR DATE
1 04-23-85 RAW SWB JEB 50-SE
DESIGNED SCW 2-22-85 ON ALL FWS
DRA- RWGCT 7. ASSIGNED 2. CONTINUATION INFO.

CONSTRUCTION SYSTEMS ASSOCIATES, INC
PROJECT: RIVER BEND NUCLEAR PLANT
BUILDING: AUXILIARY BUILDING
DRAWING: 2-20- REV J DATE: NOV. 13, 1985

PDR RIDS

8506070270

