

This drawing and the design it covers is the property of the Utilities which are participating in the SHUPPS Project. It is loaned on the borrower's express agreement that it will not be reproduced, copied, loaned, exhibited, or used except in the limited way and private use permitted by written consent given by the SHUPPS Utilities to the borrower.

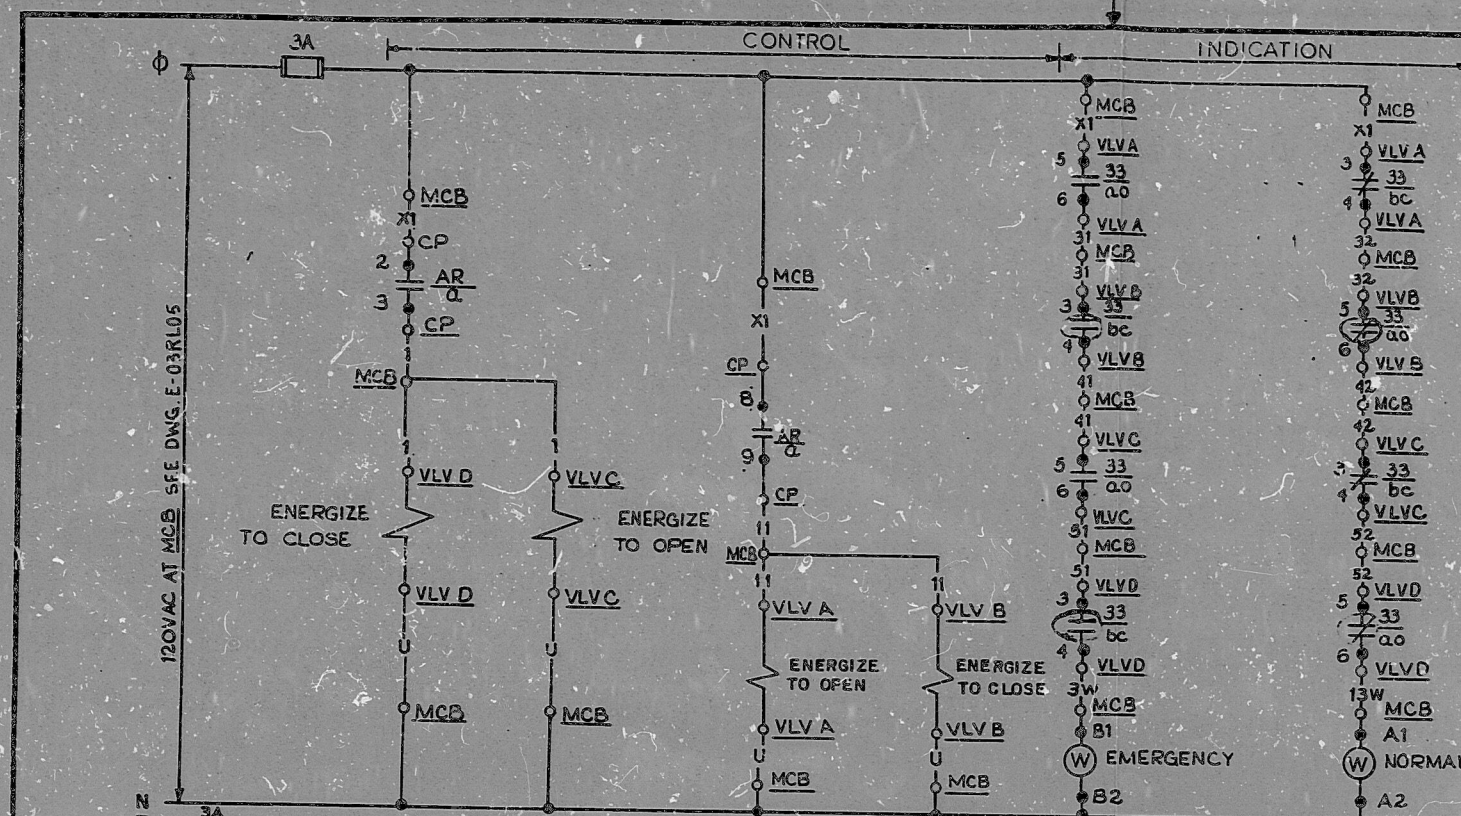


TABLE A

AUX. RELAY NO.	3XGG3	3XGG4
AUX. RELAY LOCATION-CP	RP139	RP140
HIS LOCATION-MCB	RL020	RL020
HIS NUMBER	GQHIS27	GQHIS28
SCHEME NO.	1GGK17A	4GGK17B

TABLE B

MCB LOC. - MCB	RL020	RL020
AR LOC. - CP	RP139	RP140
AR NO.	3XGG3	3XGG4
VLV LOC. - VLV D	GGRV27D	GGRV28D
VLV LOC. - VLV C	GGRV27C	GGRV28C
VLV LOC. - VLV B	GGRV27B	GGRV28B
VLV LOC. - VLV A	GGRV27A	GGRV28A
SCHEME NO.	1GGY17A	4GGY17B

I certify that the image contained on this frame was made in the normal and regular course of business, on the date stated below and that it is an accurate reproduction of the document(s) submitted to Micrographics.
DATE 1/4/84 OPERATOR Mark Barand

EMERGENCY EMER/NORM W W	POSITION	
	CONTACT	NOTE 2 NORM EMER
NORMAL	1-11-01T	X X
	3-11-03T	X X
	2-11-02B	X X
	4-11-04B	X X
CUTLER HAMMER TYPE E30 JY9 WITH TWO KLA3 CONTACT BLOCKS		
HAND INDICATING SWITCH HIS-SEE TABLE MOMENTARY CONTACT		

DEVICE 33 POSITION SWITCHES			
CONTACT	VALVE POSITION		FUNCTION
	CLOSED	OPEN	
3-4 bc			IND. LIGHT THIS DWG.
5-6 ao			IND. LIGHT THIS DWG.

SOLID BAR INDICATES CONTACT CLOSED

REF. DWGS

1. J-02GG14A
2. M-02GG01
3. J-02GG14B

TI
APERTURE
CARD

3. SOLENOID COIL IS D.C. OPERATED VIA A VENDOR SUPPLIED RECTIFIER AND ZENER DIODE CIRCUIT. SEE BECHTEL V.P. NO. J-603A-0036 & J-603A-0038.
2. CONTACT POSITION WHEN SWITCH IS IN ITS UNDEPRESSED OR "SHELF" STATE.
1. VALVE SHOWN IN NORMAL POSITION. (DEENERGIZED)

NOTES:

REVISED NOTE 3	REVISED	REVISED	REVISED	REVISED
REMOVED GROUND	REVISED	REVISED	REVISED	REVISED
REVISED WIRE NO. 33	REVISED	REVISED	REVISED	REVISED
REVISED SCHEMATIC	REVISED	REVISED	REVISED	REVISED
DCNE-03GG17(A)-A	REVISED	REVISED	REVISED	REVISED
COLAS BUILT CONDITION	REVISED	REVISED	REVISED	REVISED
ISSUED FOR CONSTRUCTION	REVISED	REVISED	REVISED	REVISED
DATE	REVISIONS	BY	CHK	DESIGN
DATE	REVISIONS	BY	CHK	DESIGN

BECHTEL			
GAITHERSBURG, MARYLAND			
SHUPPS			
SCHEMATIC DIAGRAM			
SPENT FUEL POOL NORMAL/EMERGENCY			
EXHAUST RADIOACTIVITY SAMPLE VALVES			
UTILITY DRAWING NO.		REV	
JOB NO.		REV	
10466		5-036617 (Q)	
DRAWING APPLICABLE TO UNITS		1 2 3 4 5 6 7 8 9 10	

REVIEW LEVEL 3

16X

PDR RIDS

850626006

