


5613-M-3030 SH.5

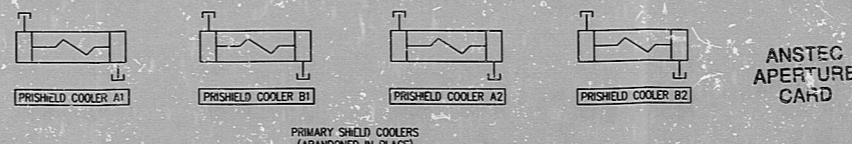

**INFORMATION ONLY**

NOTES:

- FOR GENERAL NOTES & REFERENCE DWGS SEE DWG NO. 5613-M-3030 SH. 1.
- ALL PIPING INSIDE CONTAINMENT IS SAFETY RELATED AND IS WITHIN THE SAFETY/O BOUNDARIES.

NOTE: THIS DWG IS MADE FROM:  
 FPL PWD 5610-T-E-4512 SH. 1 REV. 85  
 5610-T-E-4512 SH. 2 REV. 32

NO.	DATE	REVISION	BY	CH	APP	APP	REV	LATE	REVISION	BY	CH	APP	APP
6	4-1-92	ISSUED AS-BUILT FOR PC/M 92-135	240	KV	1/2	FZ	2	3-4-92	THIS DRAWING SUPERSEDES DWGS 5610-M-450-57 SH. 3, 5610-M-372, 5610-M-371 & 5610-M-450-92 SH.3 FOR DCR-TPM-91-136 AND 5610-M-343 FOR DCR-TPM-91-532. ISSUED AS-BUILT FOR PC/M 92-075.	MW	LTB	FTH	
5	3-6-93	ISSUED AS-BUILT FOR DCR-TPM-93-075.	DO				1	9-12-91	ISSUED AS-BUILT FOR PC/M 88-154.	SUN	HLC	GEA	RFR
4	2-11-93	ISSUED AS-BUILT FOR PC/M 92-090 & DCR-TPM-90-468.	SP				0	4-23-91	THIS DWG CREATED PER THE P & ID RECONSTRUCTION PROJECT SCOPE AND ISSUED INTO THE FPL DWG SYSTEM PER DCR-TPM-91-136.	GFH	MD	RSM	LRB
3	12-22-92	ISSUED AS-BUILT FOR PC/M 89-542 AND ORN-M-5567 WITH EXTENSIVE CHANGES TO BOUNDARY FLAGS - NO FLAG REVISION CLOUDS USED.	SMH										

THIS DRAWING SUPERSEDES DRAWINGS:  
 5610-M-450-57 SH. 3 REV. 12  
 5610-M-372 REV. 3  
 5610-M-371 REV. 2  
 5610-M-450-92 SH. 3 REV. 3  
 5610-M-343 REV. 8

TURKEY POINT NUCLEAR UNIT 3		STONE & WEBSTER ENGINEERING CORP. FT. LAUDERDALE, FLORIDA	
P & ID		DRAWING NUMBER	
COMPONENT COOLING WATER		5613-M-3030	
SYSTEM		SYS	
		REV	
		6	
		SHEET 5	

11/14/93/101 DWG

9406210159

PDR RIDS

