


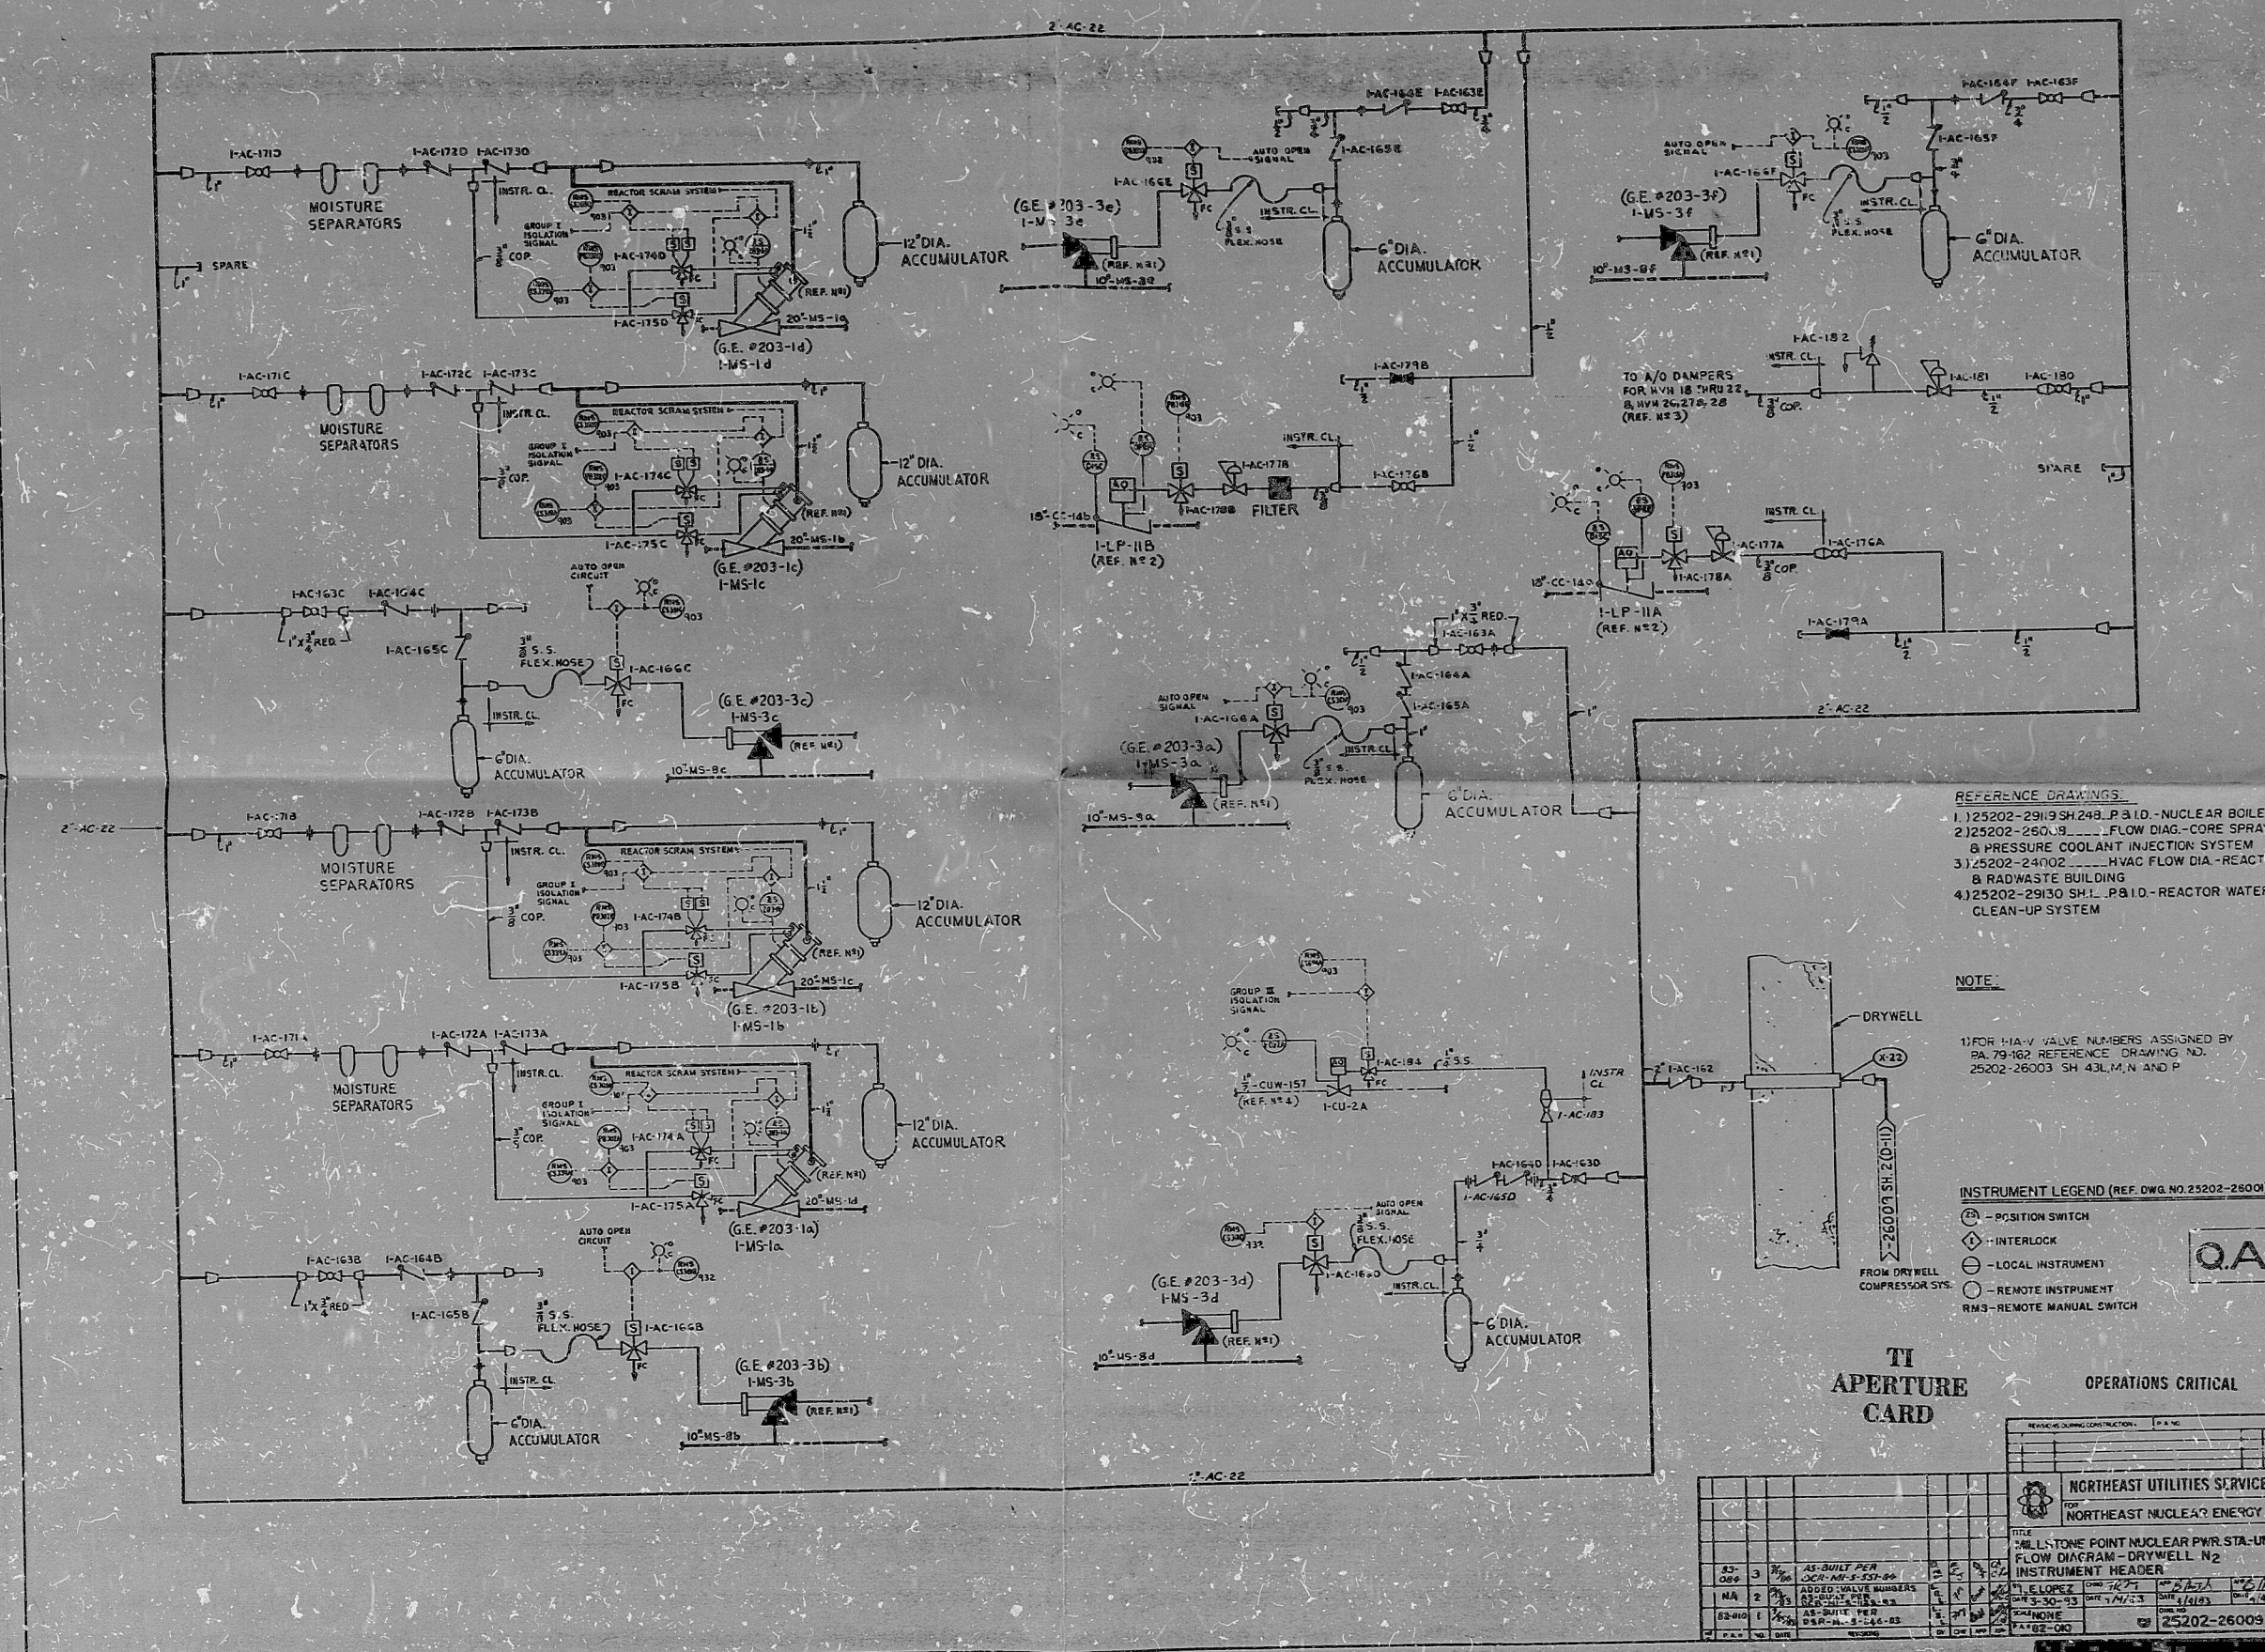

- REFERENCE DRAWINGS:
- 1) 25202-2919 SH.248, P.310 - NUCLEAR BOILER
 - 2) 25202-2600 SH.248, P.310 - FLOW DIAG - CORE SPRAY
 - 3) 25202-2400 SH.248, P.310 - PRESSURE COOLANT INJECTION SYSTEM
 - 4) 25202-2400 SH.248, P.310 - HVAC FLOW DIA - REACTOR
 - 5) 25202-2400 SH.248, P.310 - RADWASTE BUILDING
 - 6) 25202-29130 SH.1, P.810 - REACTOR WATER CLEAN-UP SYSTEM

NOTE:

1) FOR H-A-V VALVE NUMBERS ASSIGNED BY PAL 79-102, REFERENCE DRAWING NO. 25202-26003 SH.43, M, N AND P

- INSTRUMENT LEGEND (REF. DWG. NO. 25202-26003)
- ⊖ - POSITION SWITCH
 - ⊕ - INTERLOCK
 - ⊖ - LOCAL INSTRUMENT
 - ⊕ - REMOTE INSTRUMENT
 - RMS - REMOTE MANUAL SWITCH

TI APERTURE CARD

OPERATIONS CRITICAL

REV.	DATE	DESCRIPTION	BY	CHKD.
1	10/1/73	AS-BUILT PER JCR-M-5-557-86	W. J. C.	W. J. C.
2	10/1/73	ADDED VALVE NUMBERS	W. J. C.	W. J. C.
3	10/1/73	ADDED VALVE NUMBERS	W. J. C.	W. J. C.
4	10/1/73	ADDED VALVE NUMBERS	W. J. C.	W. J. C.
5	10/1/73	ADDED VALVE NUMBERS	W. J. C.	W. J. C.
6	10/1/73	ADDED VALVE NUMBERS	W. J. C.	W. J. C.
7	10/1/73	ADDED VALVE NUMBERS	W. J. C.	W. J. C.
8	10/1/73	ADDED VALVE NUMBERS	W. J. C.	W. J. C.
9	10/1/73	ADDED VALVE NUMBERS	W. J. C.	W. J. C.
10	10/1/73	ADDED VALVE NUMBERS	W. J. C.	W. J. C.

8510070473

PDR RIDS

8510070473

