


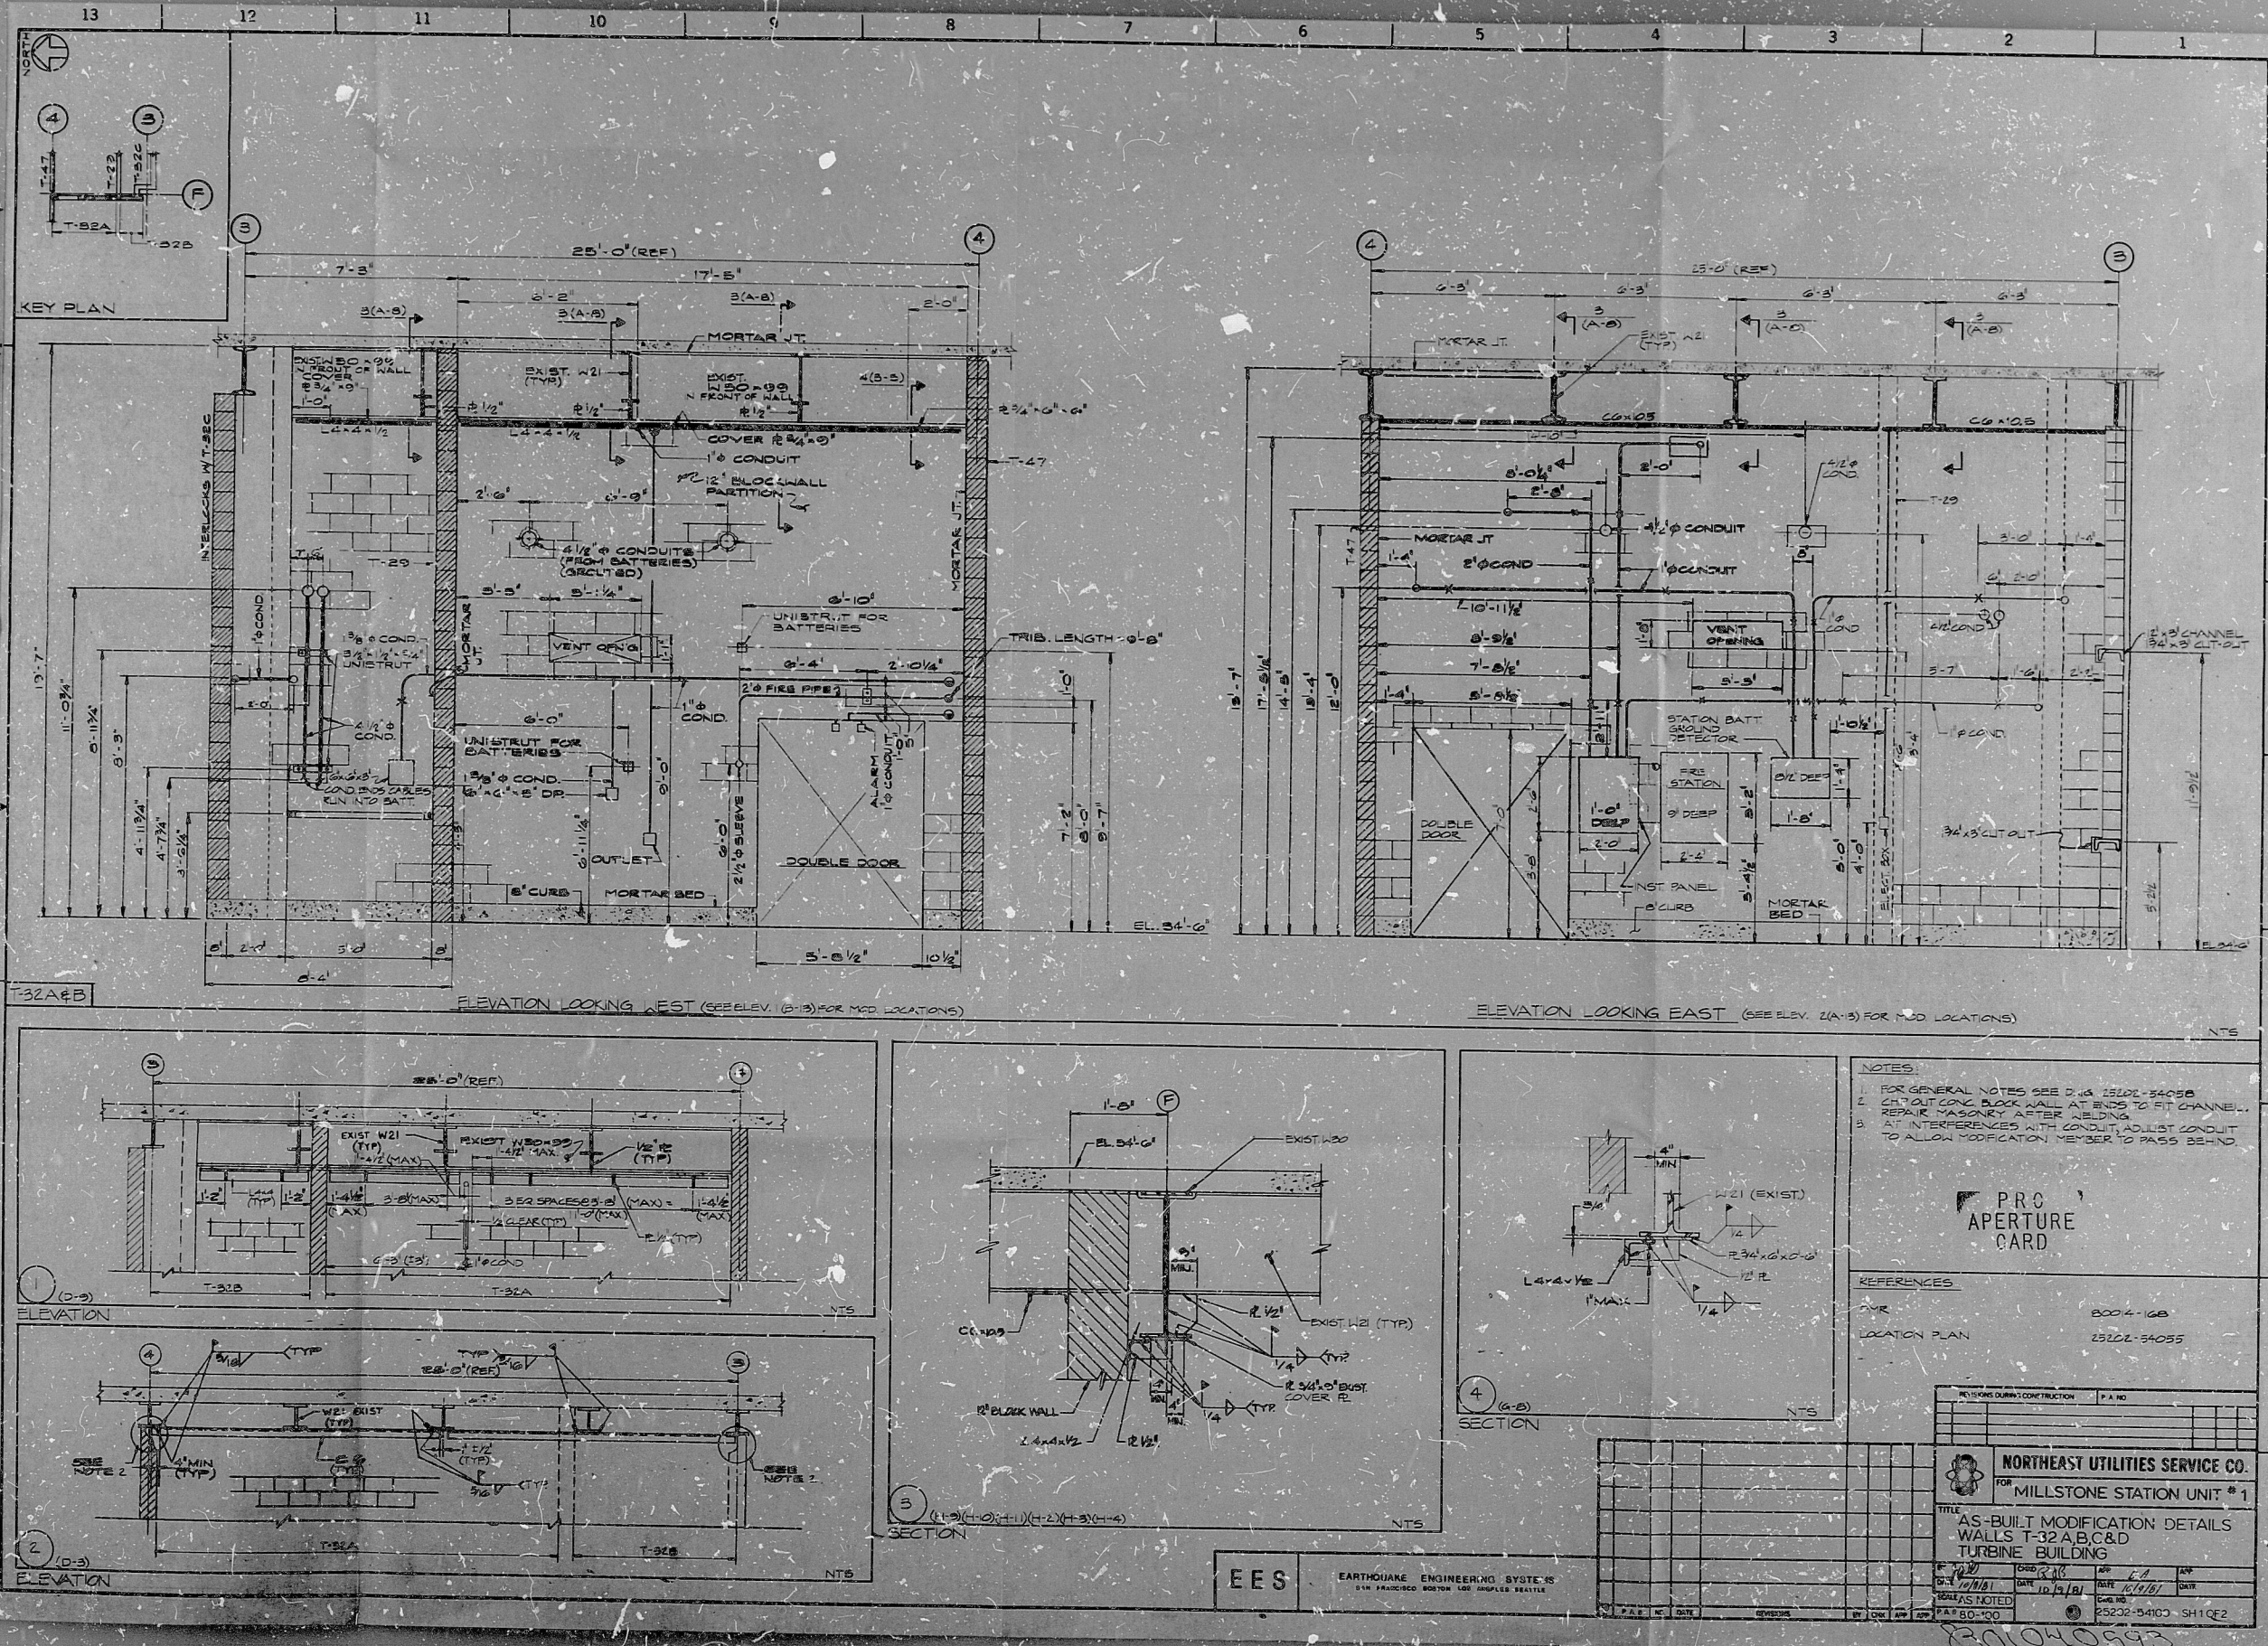

EES

EARTHQUAKE ENGINEERING SYSTEMS
3141 FRANCISCO BOULEVARD, SUITE 100, SAN FRANCISCO, CA 94134

NORTHEAST UTILITIES SERVICE CO.

FOR MILLSTONE STATION UNIT #1

AS-BUILT MODIFICATION DETAILS
WALLS T-32A,B,C&D
TURBINE BUILDING

DATE: 10/15/01
BY: [signature]
CHECKED: 10/15/01
DATE: 10/15/01

PROJECT NO.: 23022-B4103-SH1022

301040593

RIDS

8301040593

