


WPPSS 35-100-1087 SHEET 2 OF 4

NO	DATE	REVISION	BY	CHK	APPROVED
6	1/5/81		LK	DNA	

INCLUDES DCN-FD-26, FD-74
 REQUIRED (S-3) LOC. INSTN. (M1) LOC. VENT. (Q17) COORD.
 ALIGNED (M3) PIPING

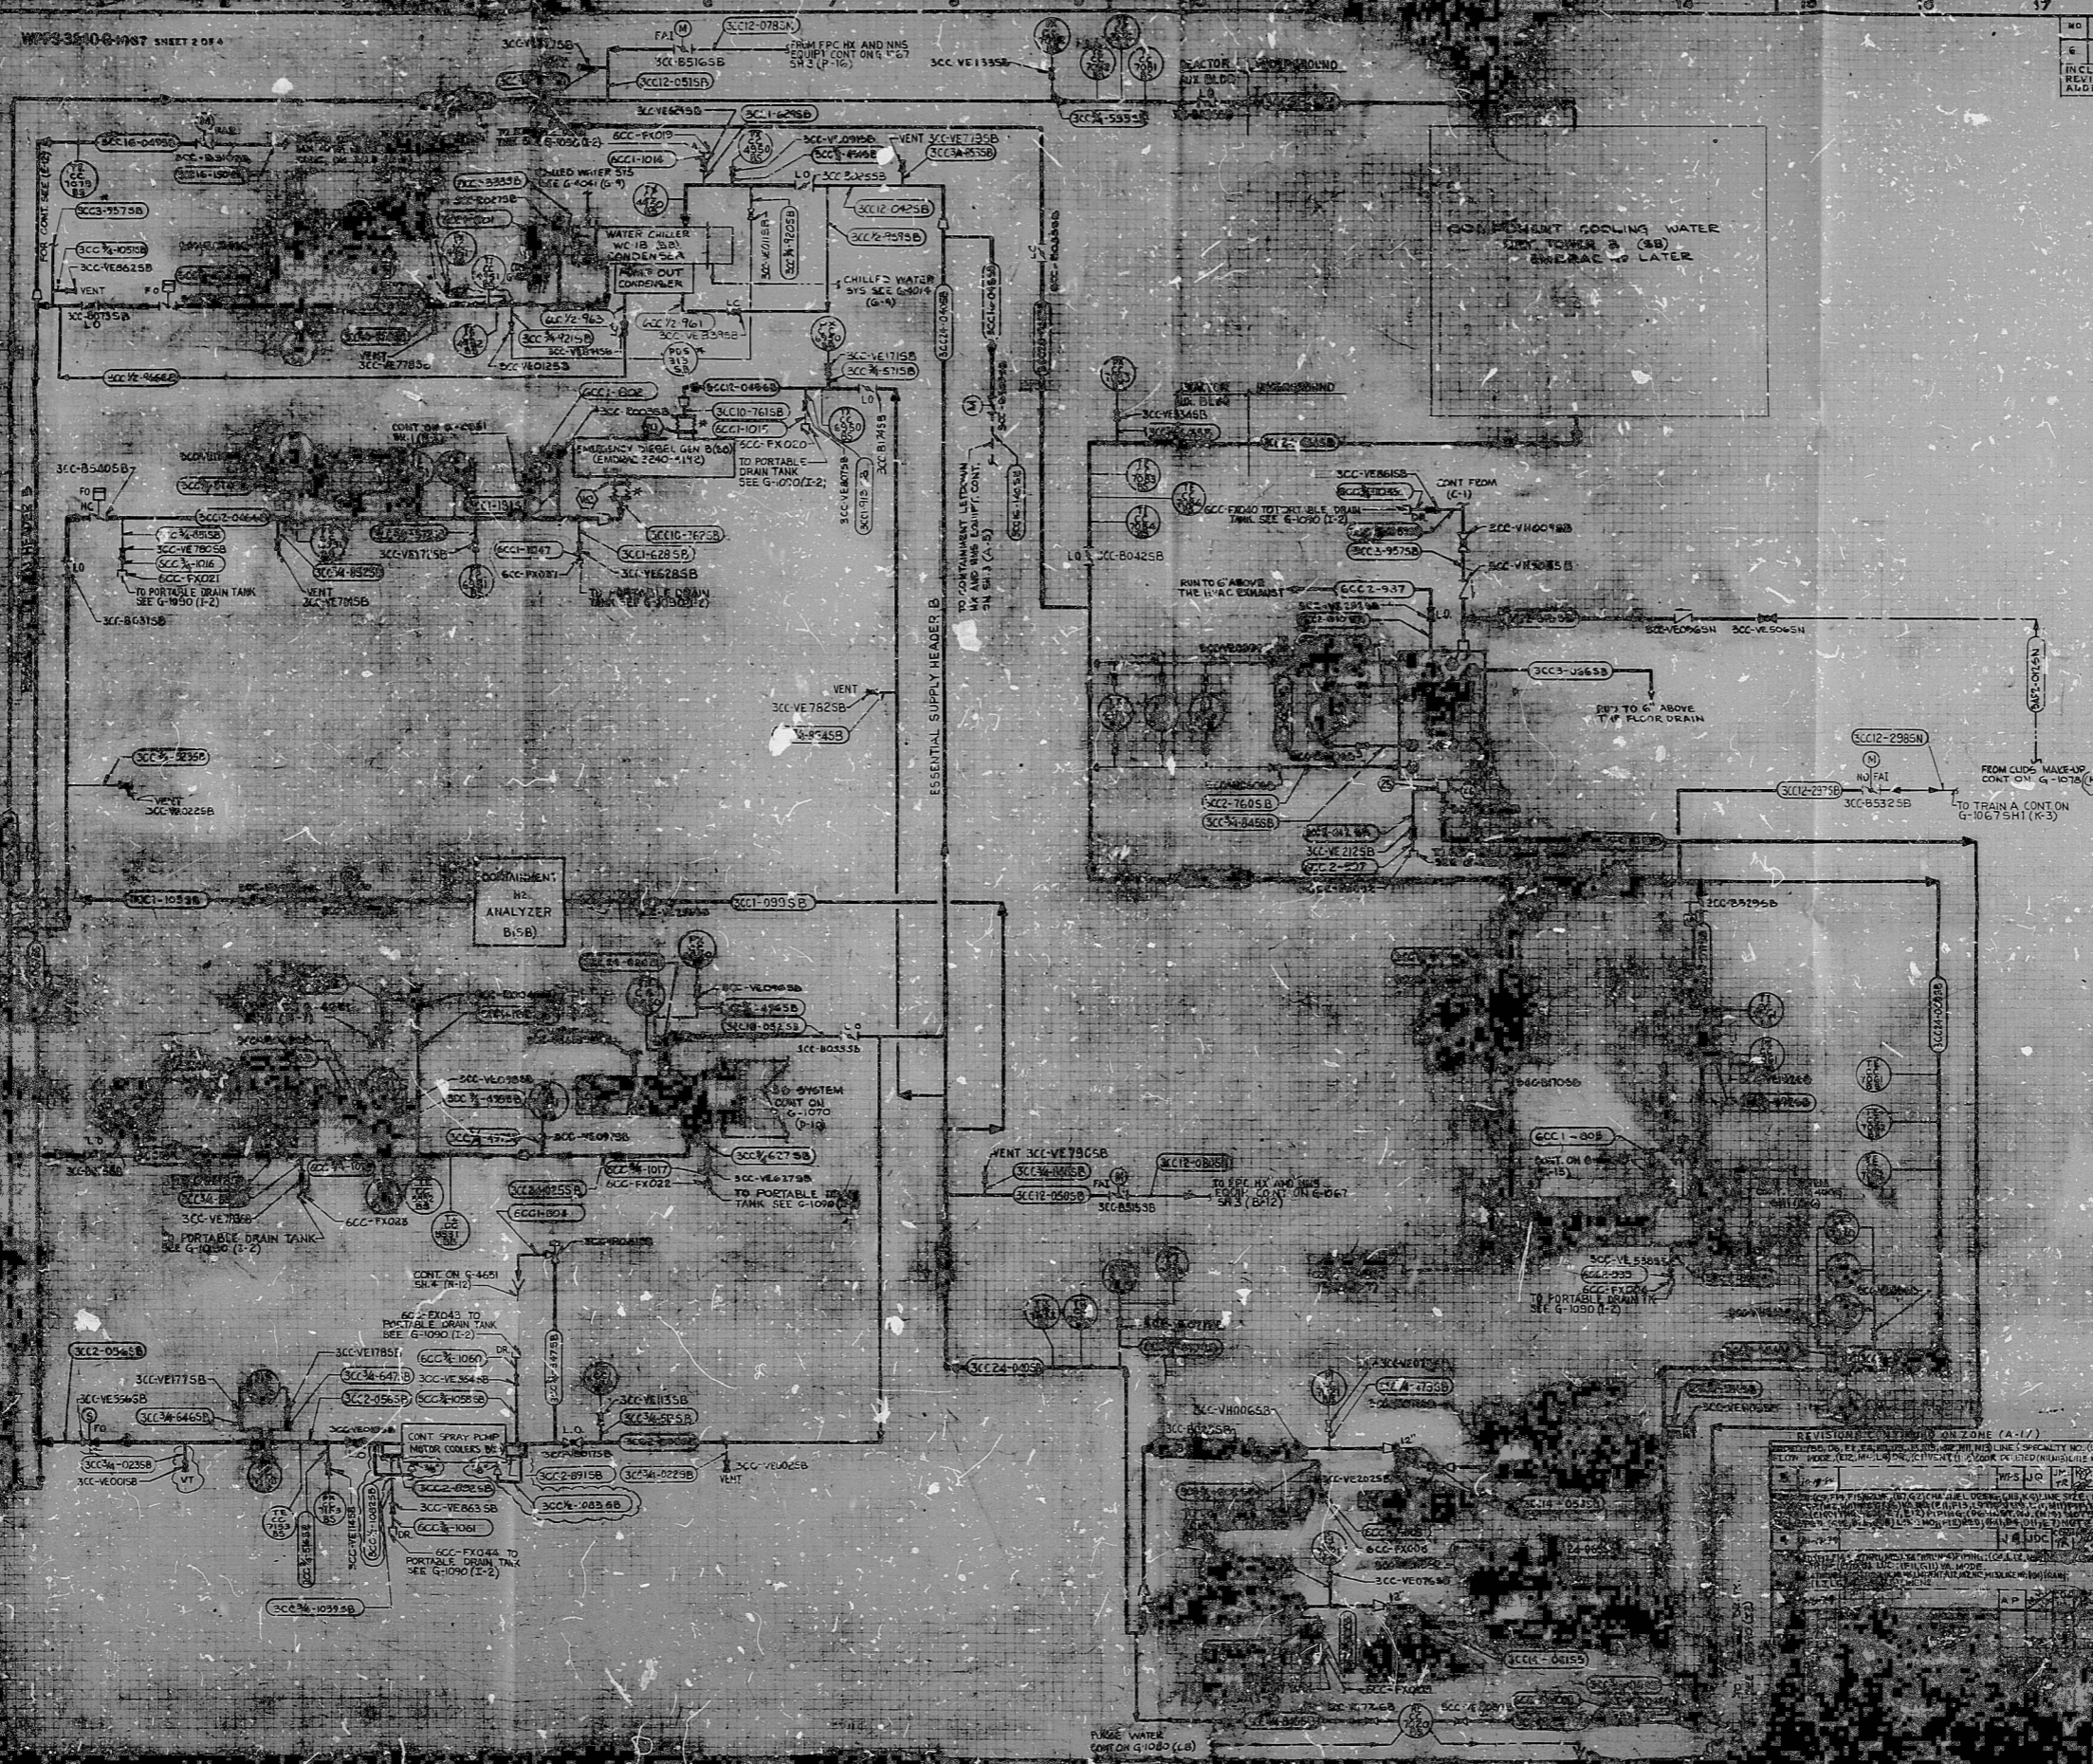

NOTE
FOR REFERENCE DRAWINGS SEE
G-1067 5H1.

WPPSS QUALITY CLASS I, II, G

REVISIONS LISTED ON ZONE (A-17)

NO.	DATE	DESCRIPTION
1	1/5/81	ISSUED FOR CONSTRUCTION
2	1/5/81	REVISED TO REFLECT AS-BUILT CONDITIONS
3	1/5/81	REVISED TO REFLECT AS-BUILT CONDITIONS
4	1/5/81	REVISED TO REFLECT AS-BUILT CONDITIONS
5	1/5/81	REVISED TO REFLECT AS-BUILT CONDITIONS

POOR ORIGINAL

PRC APERTURE GARD

SAFETY RELATED

WASHINGTON PUBLIC POWER SUPPLY SYSTEM
 CLEAR PROJECTS NO. 363
 1981-1982 NEW INSTALLATION
 1983-1985 NEW INSTALLATION

**FLOW DIAGRAM
 COMPONENT COOLING WATER
 SYSTEM**

WPPSS INCORPORATED

27"

17"

11"

8.5"

8.5"

11"

17"

22"

RIDS

8303010111

