

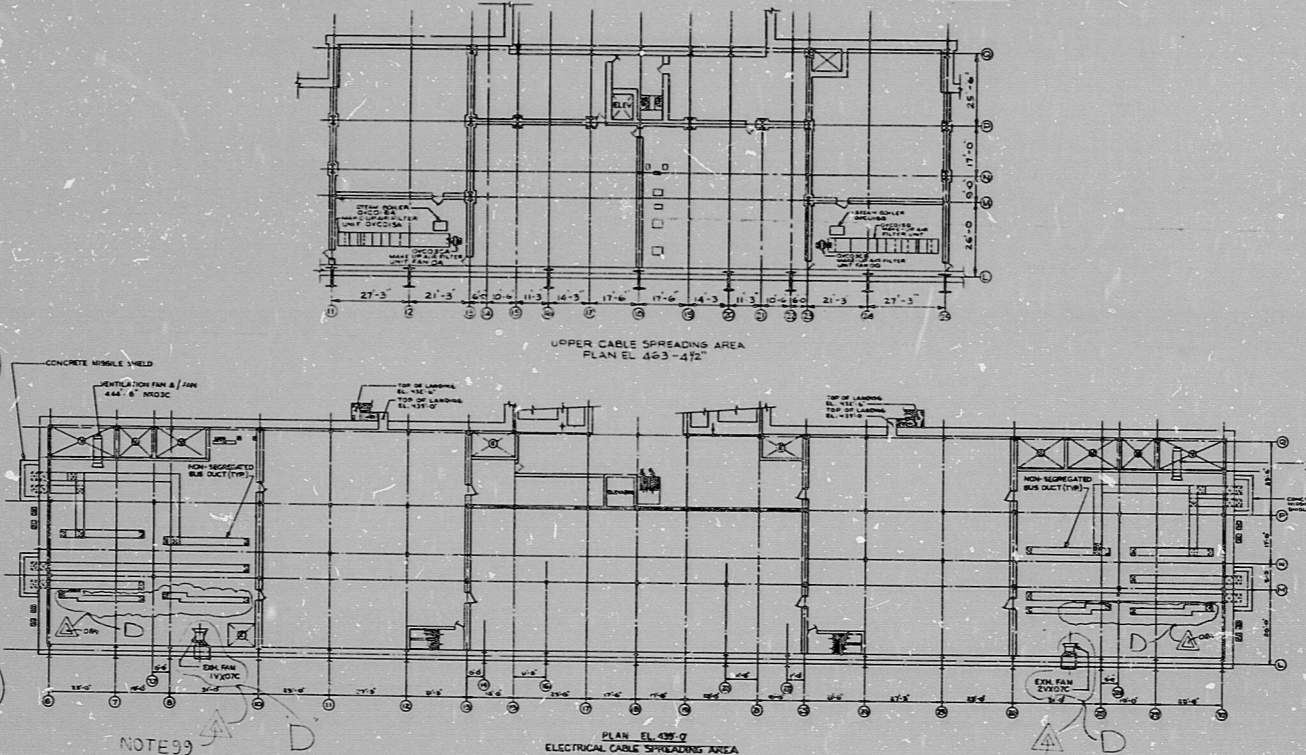
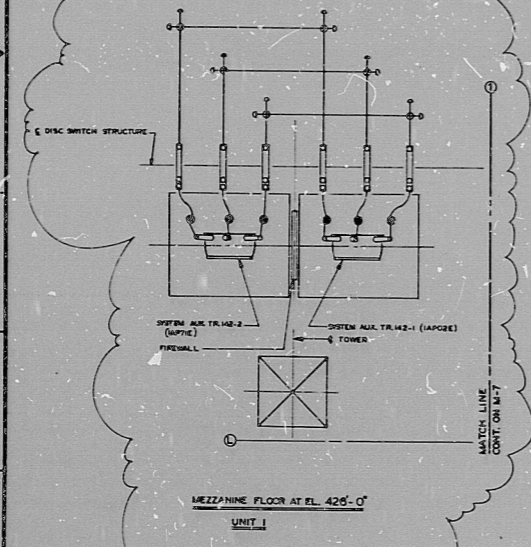


M-22-1

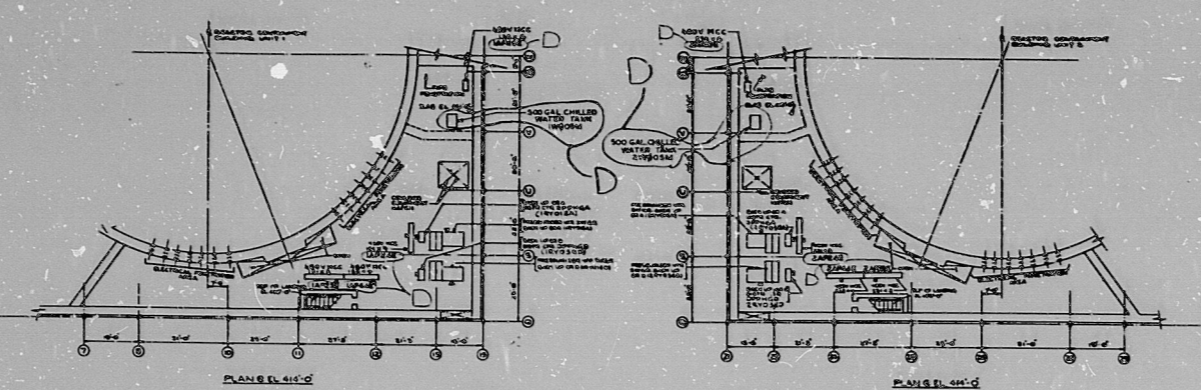

PRC APERTURE CARD

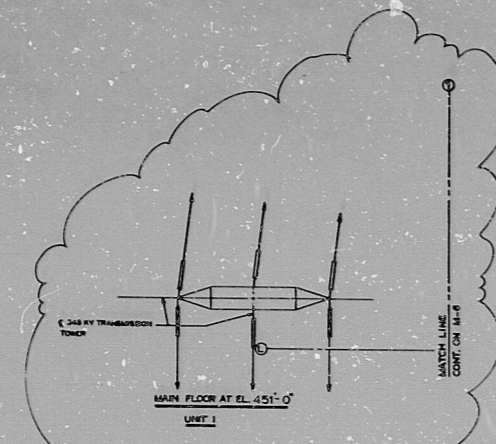

NUCLEAR SAFETY RELATED
ITEMS ARE SHOWN ON THIS DRAWING
FOR SAFETY CLASSIFICATION SEE CC, NE OF M-3

SCALE: 1/8" = 1'-0"

NO.	DATE	DESCRIPTION
1	7-30-78	ISSUED FOR INFORMATION
2	11-13-78	REVISION UPDATE RECORD DRAWING

GENERAL ARRANGEMENT
MISCELLANEOUS PLANS
MARBLE HILL NUCLEAR
GENERATING STATION UNITS 1 & 2
PUBLIC SERVICE INDIANA
PLAINFIELD, INDIANA

SARGENT & LUNDY
CHICAGO, ILLINOIS

REV.	DATE	BY	CHKD.	DESCRIPTION
1	11-16-78	J. Nichols	J. Nichols	GENERAL ARRANGEMENT
2	11-21-78	J. Nichols	J. Nichols	DWG. UPDATED FOR INFORMATION
3	11-21-78	J. Nichols	J. Nichols	REVISION UPDATE RECORD DRAWING
4	11-21-78	J. Nichols	J. Nichols	REVISION UPDATE RECORD DRAWING

REV.	DATE	BY	CHKD.	DESCRIPTION
1	11-16-78	J. Nichols	J. Nichols	GENERAL ARRANGEMENT
2	11-21-78	J. Nichols	J. Nichols	DWG. UPDATED FOR INFORMATION
3	11-21-78	J. Nichols	J. Nichols	REVISION UPDATE RECORD DRAWING
4	11-21-78	J. Nichols	J. Nichols	REVISION UPDATE RECORD DRAWING

REV.	DATE	PREPARED	REVIEWED	APPROVED	PURPOSE
1	11-16-78	J. Nichols	J. Nichols	J. Nichols	GENERAL ARRANGEMENT
2	11-21-78	J. Nichols	J. Nichols	J. Nichols	DWG. UPDATED FOR INFORMATION
3	11-21-78	J. Nichols	J. Nichols	J. Nichols	REVISION UPDATE RECORD DRAWING
4	11-21-78	J. Nichols	J. Nichols	J. Nichols	REVISION UPDATE RECORD DRAWING

SCALE: 1/8" = 1'-0"
PROJECT NUMBER: 4808-00
DATE: 11-16-78

GENERAL ARRANGEMENT
MISCELLANEOUS PLANS
MARBLE HILL NUCLEAR
GENERATING STATION UNITS 1 & 2
PUBLIC SERVICE INDIANA
PLAINFIELD, INDIANA

SARGENT & LUNDY
CHICAGO, ILLINOIS

DRAWING NO. M-22
SHEET 1 OF 5

8305050336

RIDS

