


PLAN EL 383'-0"

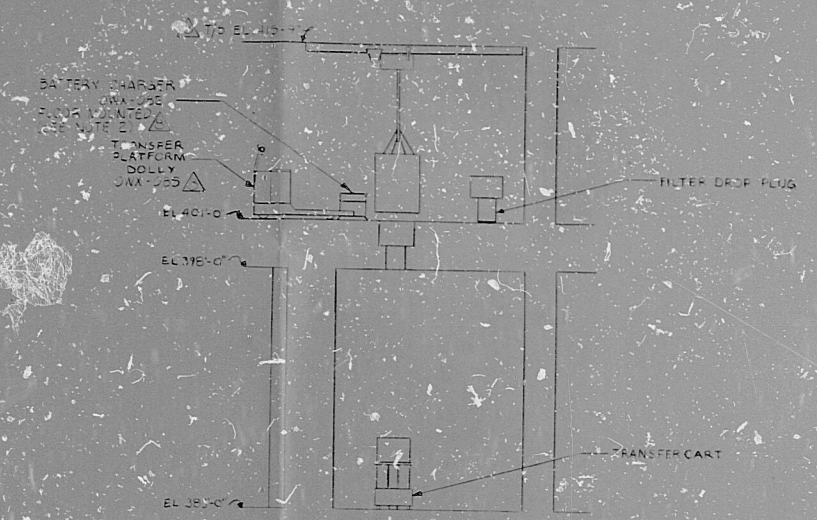

SECTION E-E


NOTE
 THIS DRAWING IS FOR EQUIPMENT LOCATION & IDENTIFICATION PURPOSES. FOR WEIGHTS, MOUNTING & INSTALLATION DETAILS REFER TO DETAIL DRAWINGS. SEE 77200 FOR DRAWING INDEX.
 REFER TO MANUFACTURER'S LITERATURE FOR MATERIALS, FINISHING, DWG'S, ELECTRICAL CONNECTIONS, MOUNTING DETAILS & WEIGHTS.
 FOR VALVE RACK MOUNTING HOLE PATTERN AND SIZE SEE DWG 77202.

AS BUILT

UNITED NUCLEAR INDUSTRIES, INC.
 2000 GERRARD ST. E. UNIT 100
 SCARBOROUGH, ONTARIO M1V 4Y7

CONTRACT INFORMATION

Customer: Public Service of Indiana
 Contract No.: 77200
 Project: Marble Hill
 Engineer: [Signature]
 Date: 11-11-81
 Approved by: [Signature]
 Date: [Signature]
 Submittal Date: [Signature]
 Comments: [Signature]

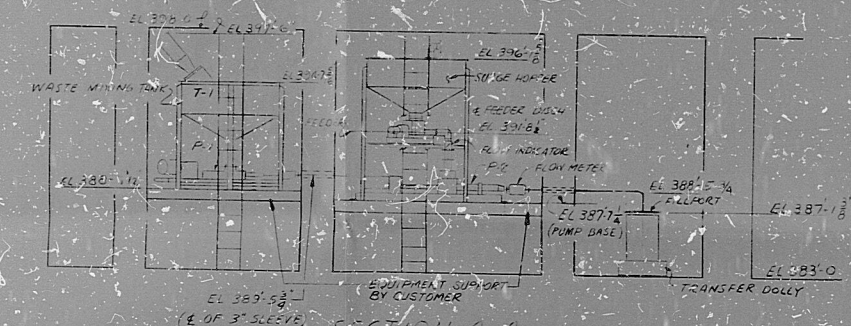


SECTION A-A



SECTION B-B

SECTION C-C

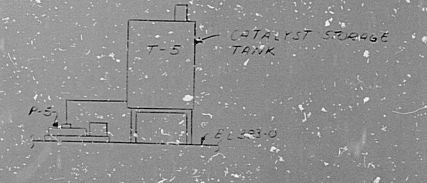

SECTION D-D

REVISIONS

NO.	DATE	DESCRIPTION	BY	CHKD.
1	11-11-81	REVISED PER IEN 2049	[Signature]	[Signature]

UNITED NUCLEAR INDUSTRIES, INC.
 A DIVISION OF UNITED NUCLEAR INDUSTRIES, INC.
 CHEMICAL DIVISION

GENERAL ARRANGEMENT
 PROCESS EQUIPMENT EL 383'-0"
 RADWASTE SOLIDIFICATION SYSTEM

CUSTOMER: MARBLE HILL WASTE TREATMENT PLANT
 PUBLIC SERVICE INDIANA

SCALE: 1/4" = 1'-0"
 PROJECT NO.: 77200
 CONTRACT NO.: 77204

8406060273

PDR RIDS

8406060273

