


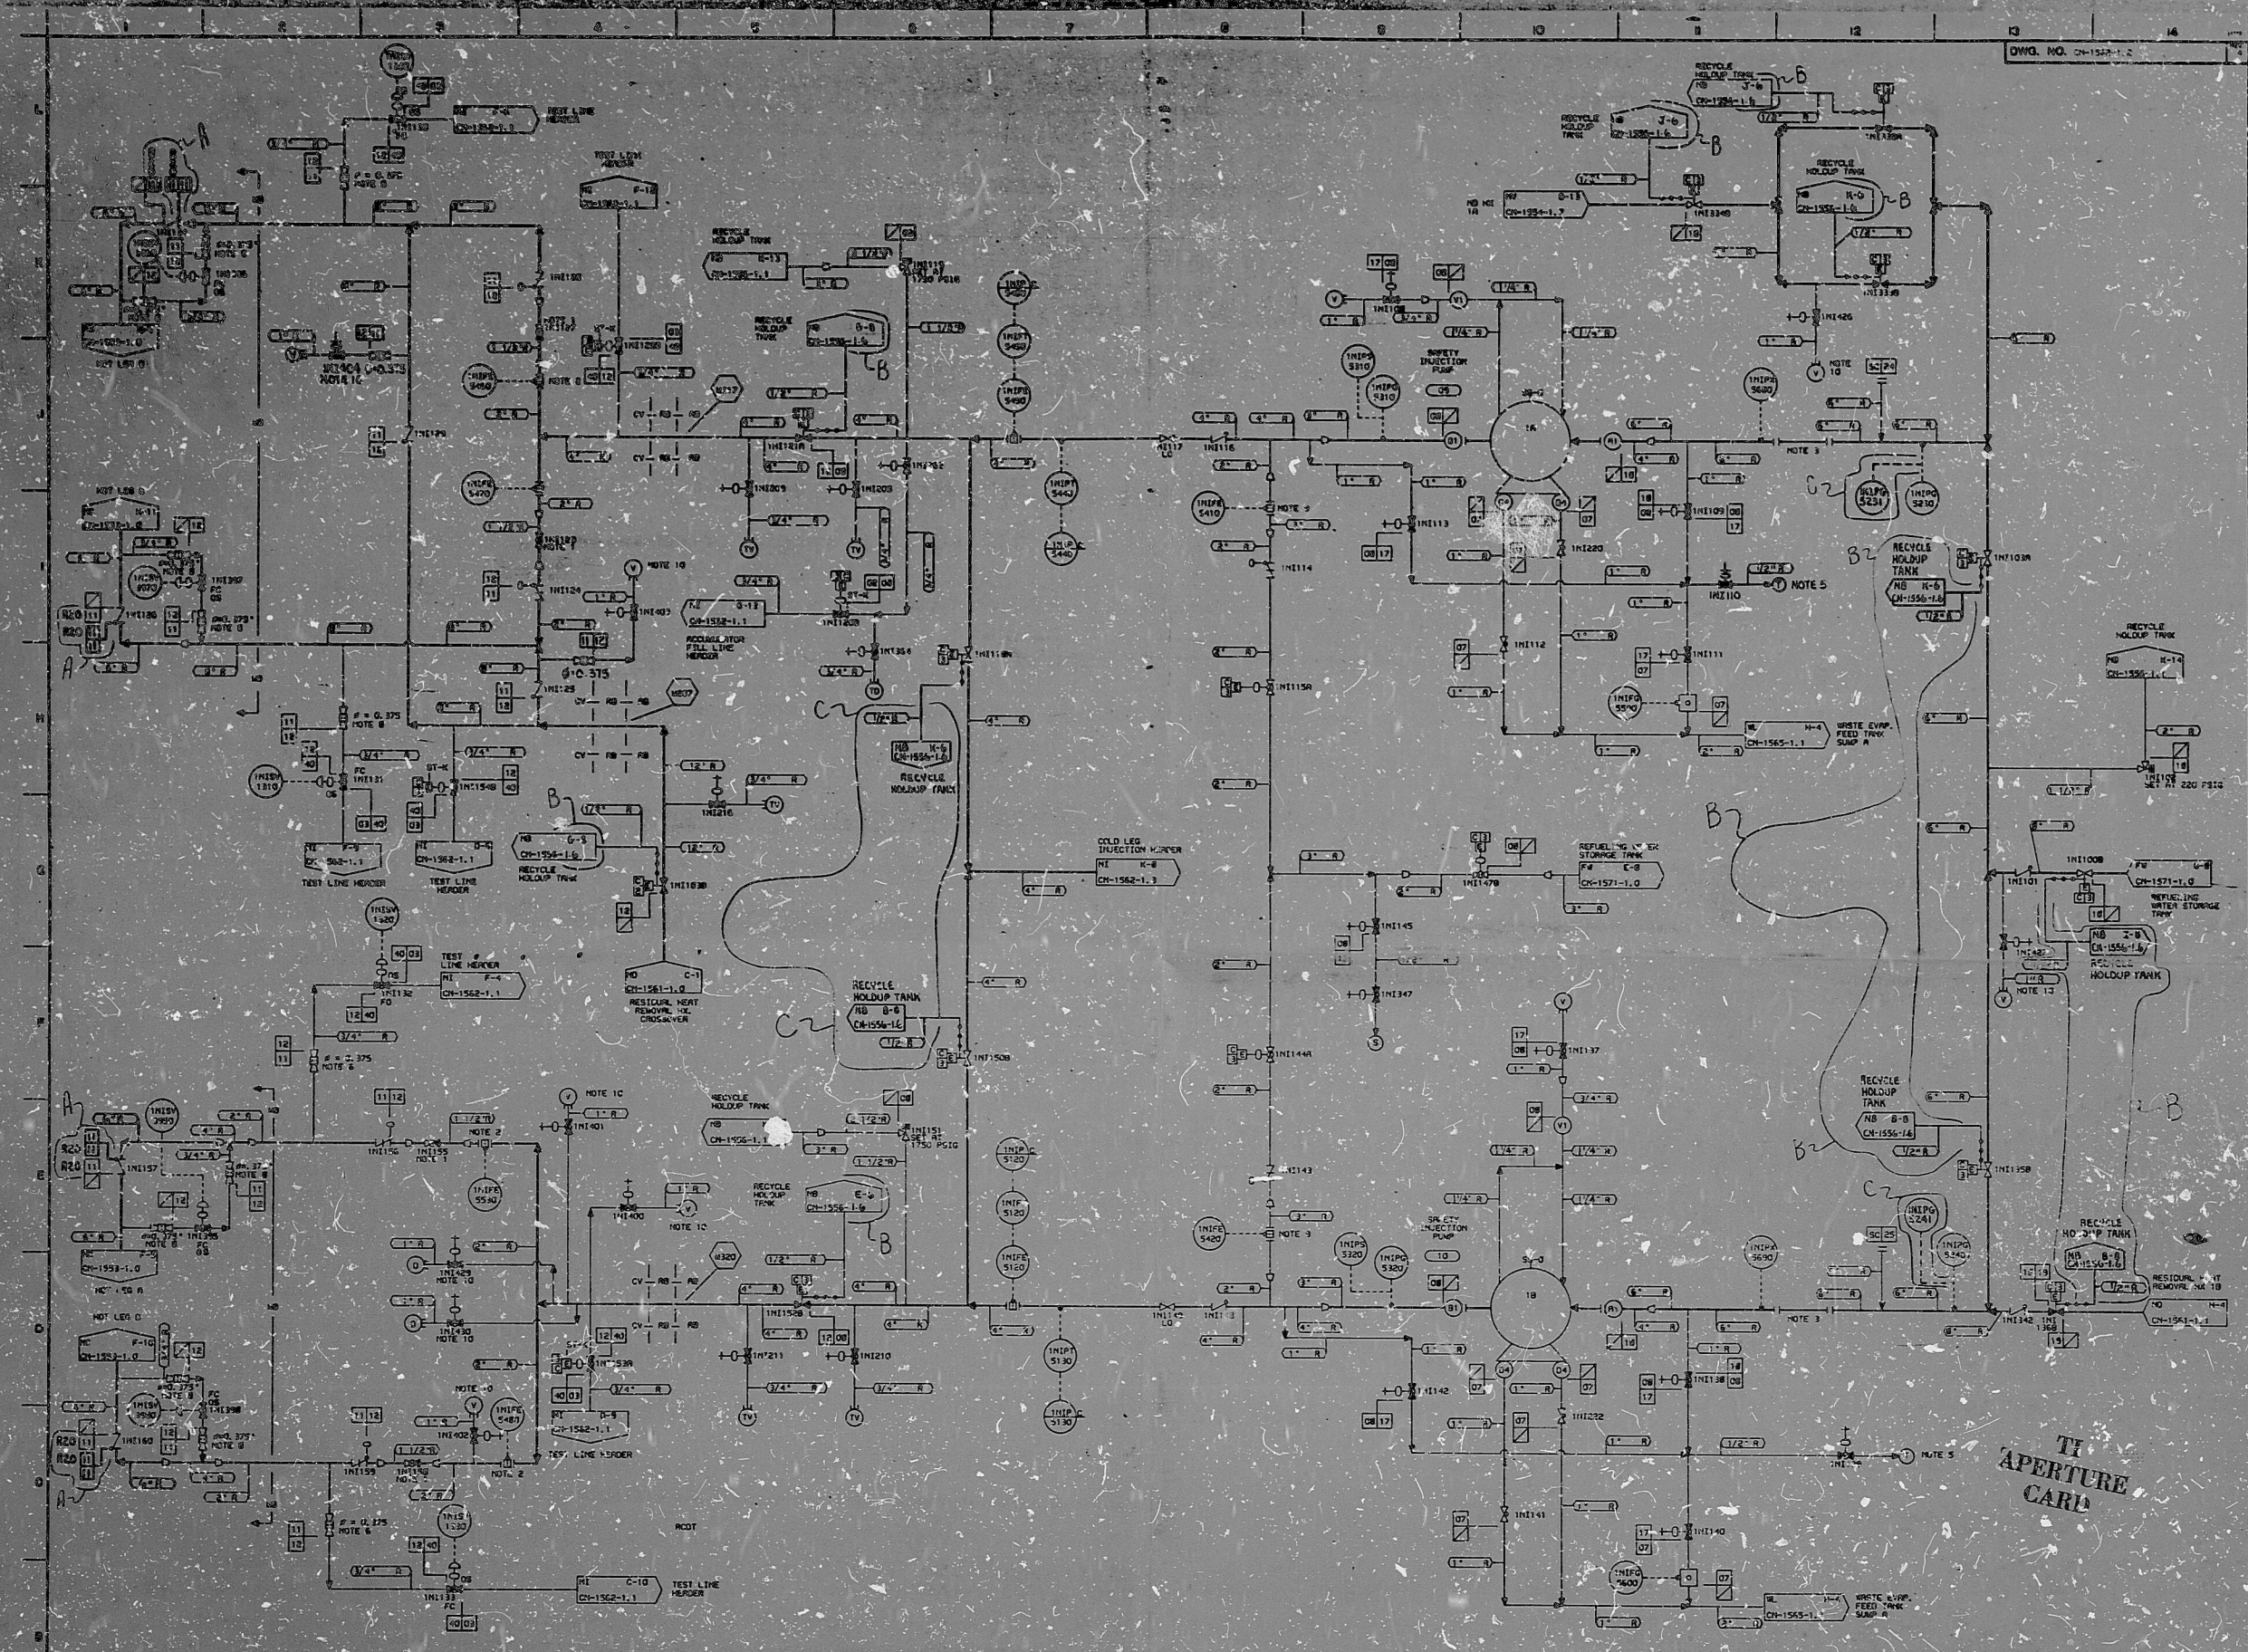

- NOTES:
1. REACTOR POWER IN FIELD TO UNIT 1 PUMP ROOMS THEN LOC. WITH POSITIVE LOCKING DEVICE.
 2. FLOW METERED TO UNIT 1 PUMP ROOMS DURING PRE-OPERATION TESTS.
 3. REACTOR POWER IN FIELD TO UNIT 1 PUMP ROOMS DURING PRE-OPERATION TESTS. DIVISION MUST BE REMOVED BEFORE REACTOR POWER IN FIELD TO UNIT 1 PUMP ROOMS DURING PRE-OPERATION TESTS.
 4. SEE TUBE 100000 CH-1552-1.1 & CH-1552-1.2 FOR COOLING WATER CONNECTIONS TO SAFETY VALVE PUMPS.
 5. DIVISION MUST BE REMOVED BEFORE REACTOR POWER IN FIELD TO UNIT 1 PUMP ROOMS DURING PRE-OPERATION TESTS.
 6. SEE REACTOR DETAIL ON REACTOR HOUSE DWG. CH-1552-1.1 AND REACTOR DETAIL ON REACTOR HOUSE DWG. CH-1552-1.2.
 7. MINIMUM FLOW OFFICE SUPPLIED WITH PUMP.
 8. CONSTRUCTION NOTES & DIMS.

ITEM	DESCRIPTION	QTY	UNIT
01	2501.2 2750 P10A	1	EA
02	2501.2 2750 P10A	1	EA
03	2501.2 2750 P10A	1	EA
04	2501.2 2750 P10A	1	EA
05	2501.2 2750 P10A	1	EA
06	2501.2 2750 P10A	1	EA
07	2501.2 2750 P10A	1	EA
08	2501.2 2750 P10A	1	EA
09	2501.2 2750 P10A	1	EA
10	2501.2 2750 P10A	1	EA

AS BUILT
DATE 1-25-65

AUTHORIZED PRESSURE BOUNDARY REVISION - REV. 4 (COP-1-10/7/62)
A. PLANNED FOR PRESSURE BOUNDARY REVISION - REV. 4 (COP-1-10/7/62)
SYSTEM CHANGE ORDER NUMBER CH-1552-1.2-0013

REVISION	DESCRIPTION	DATE	BY
1	REVISION 1	1-25-65	AS BUILT

OR CONDITION 2	OR CONDITION 1
DUKE POWER COMPANY	DUKE POWER COMPANY
CHINA HOLDING STATION UNIT 1	CHINA HOLDING STATION UNIT 1
PIPING DIAGRAM OF	PIPING DIAGRAM OF
SAFETY INJECTION SYSTEM	SAFETY INJECTION SYSTEM
(REV. 4)	(REV. 4)

PDR RIDS

~~dupes of~~ 8406070321

