


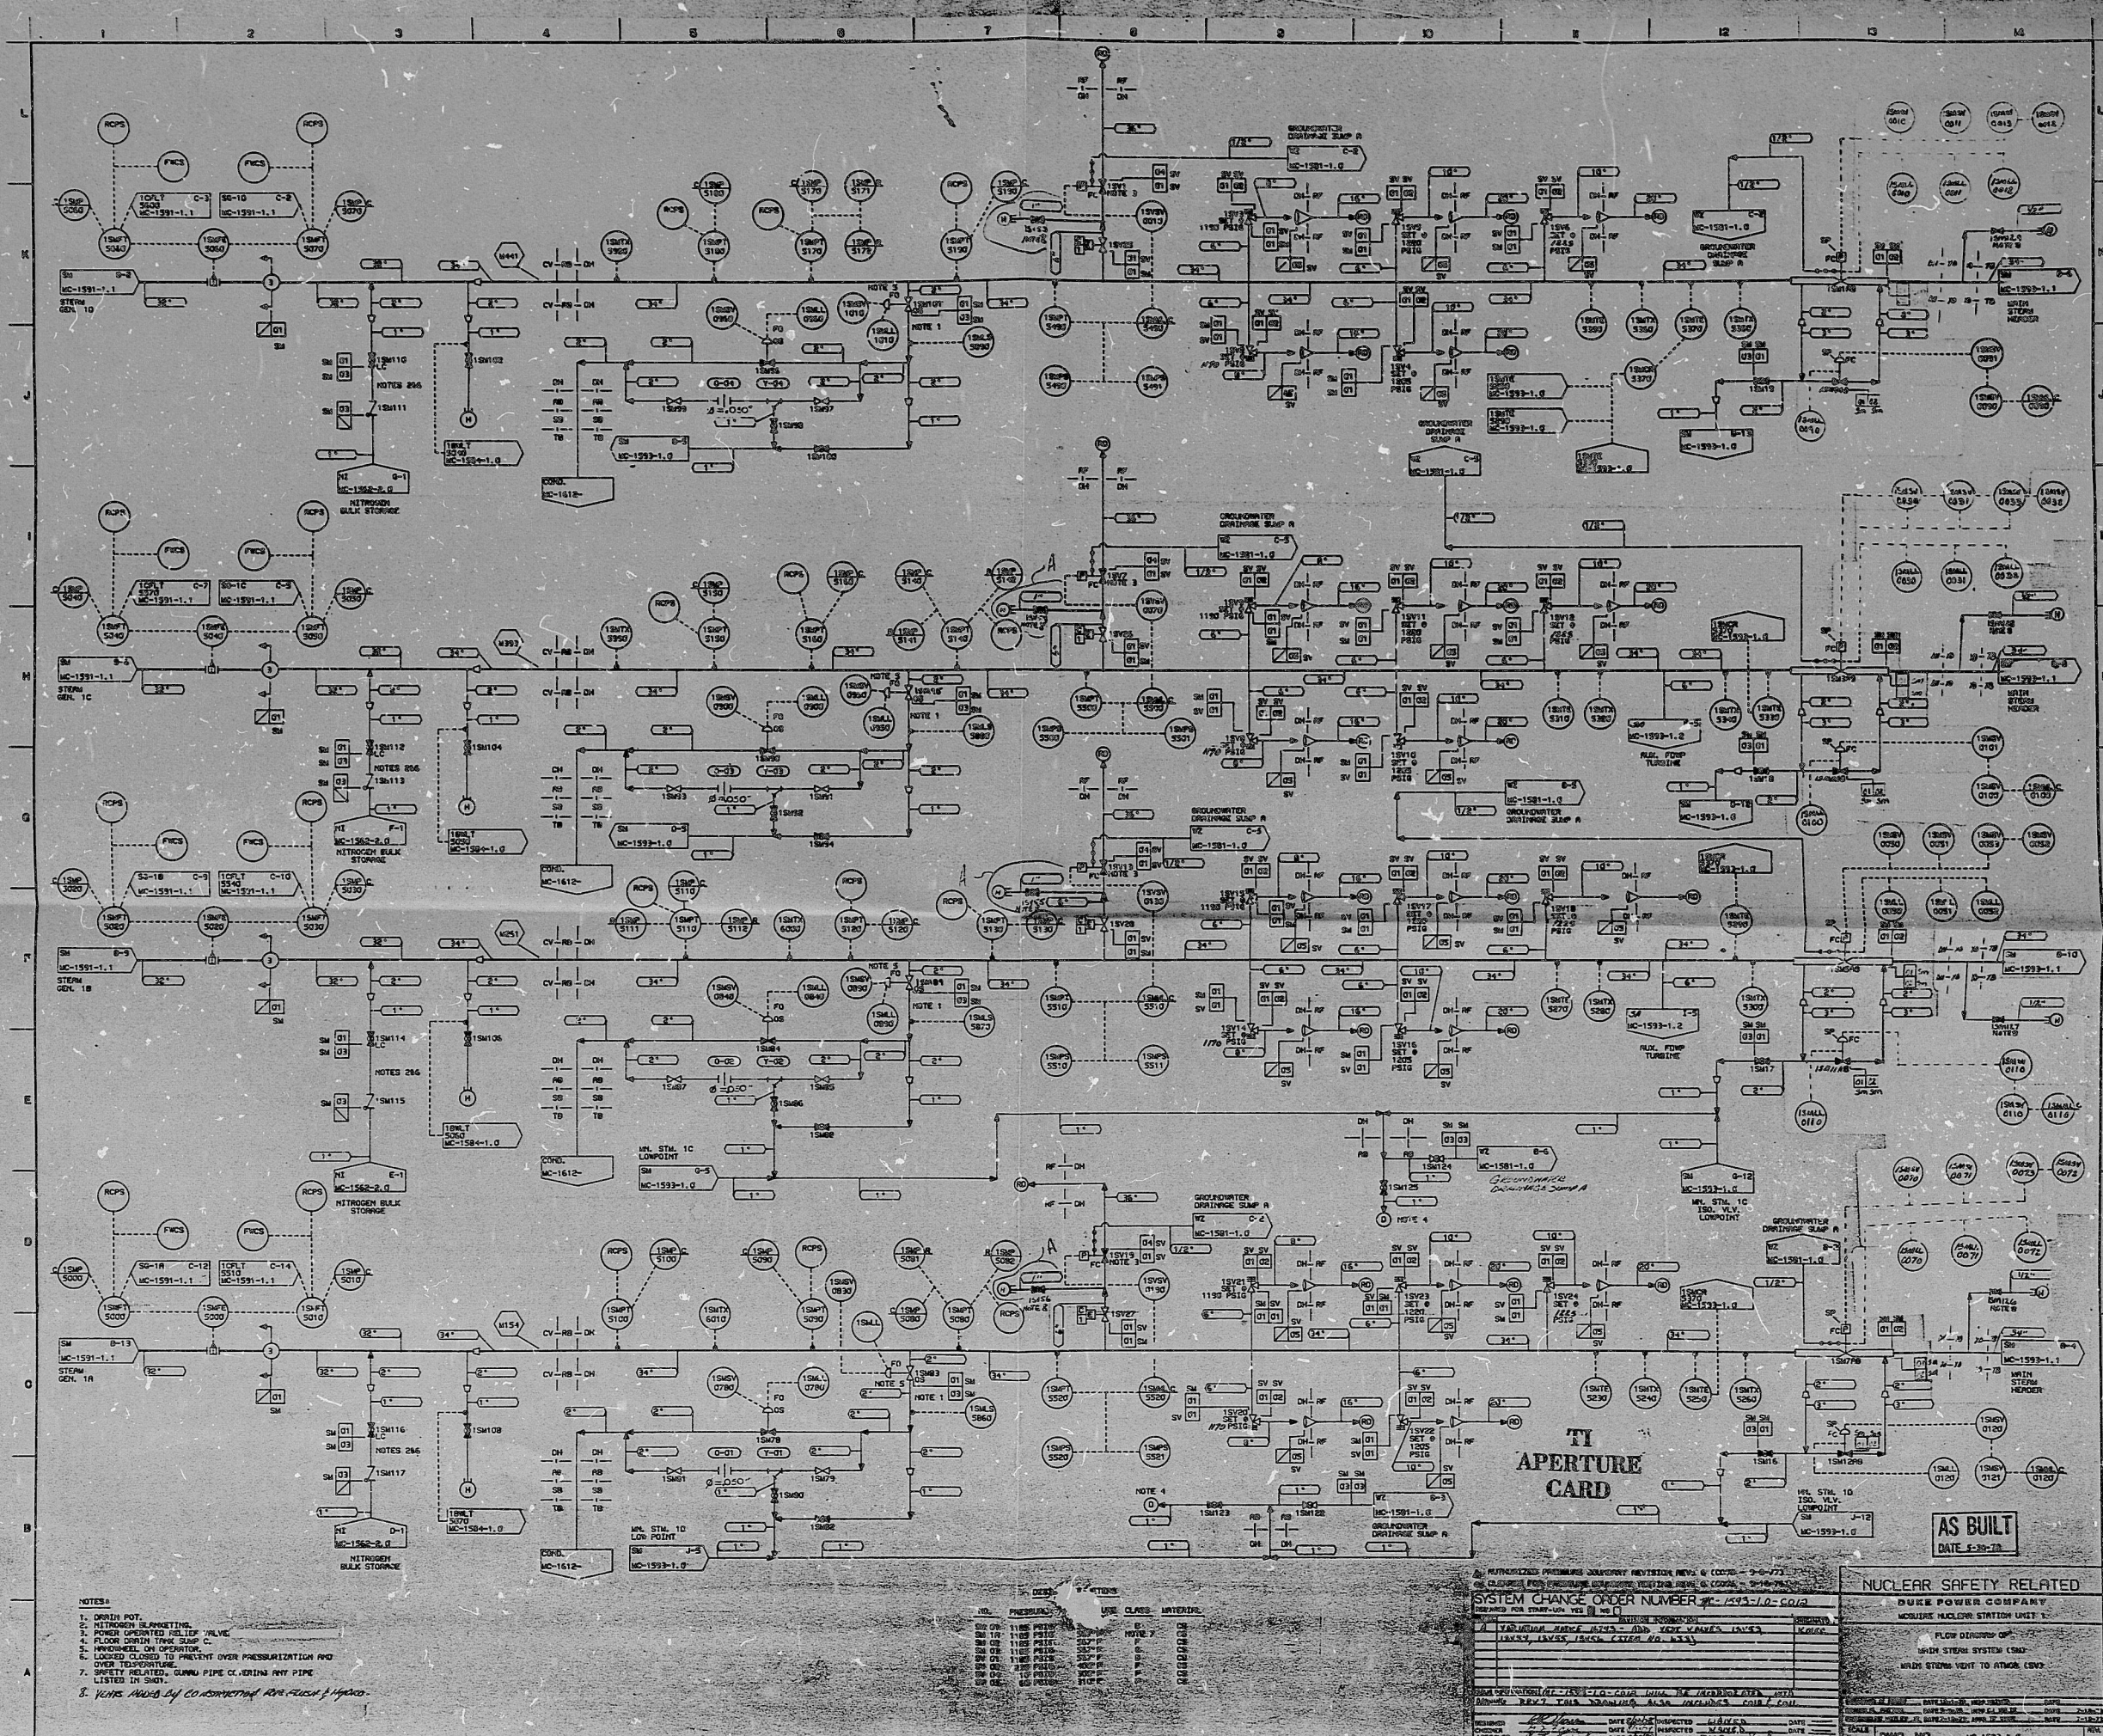

- NOTES:
- 1. DRAIN PPT.
 - 2. NITROGEN TRANSMITTER.
 - 3. POWER OPERATED RELAY VALVE.
 - 4. FLOOR DRAIN TANK SUMP C.
 - 5. INCHWATER ON OPERATOR.
 - 6. LOCKED CLOSED TO PREVENT OVER PRESSURIZATION AND OVER TEMPERATURE.
 - 7. SAFETY RELATED, GUNNAR PIPE C. DRAIN PPT PIPE LISTED IN SUMP.
 - 8. PUMP MOUNTED BY CONSTRUCTION AREA 1000.

TI
APERTURE
CARD

AS BUILT
DATE 8-30-70

NUCLEAR SAFETY RELATED	
DUKE POWER COMPANY	
MODULE: NUCLEAR SAFETY UNIT 1	
FLOW ORIGIN: ON	
MAIN STEAM: YES TO ATOM 1000	
DATE: 8-30-70	
DWG. NO. NC-1593-1.0	

8701060457

PDR

8701060457

