


NOTES:
 THE SPECIFICATIONS FOR DIESEL GENERATOR
 SKID MOUNTED PIPING PROVIDED BY VENDOR
 "FAIRBANKS MORSE" ARE FOUND IN CRO
 INSTRUCTION MANUAL 37.

LEGEND	
	MAIN SYSTEM
	STANDBY
	VENT & DRAIN

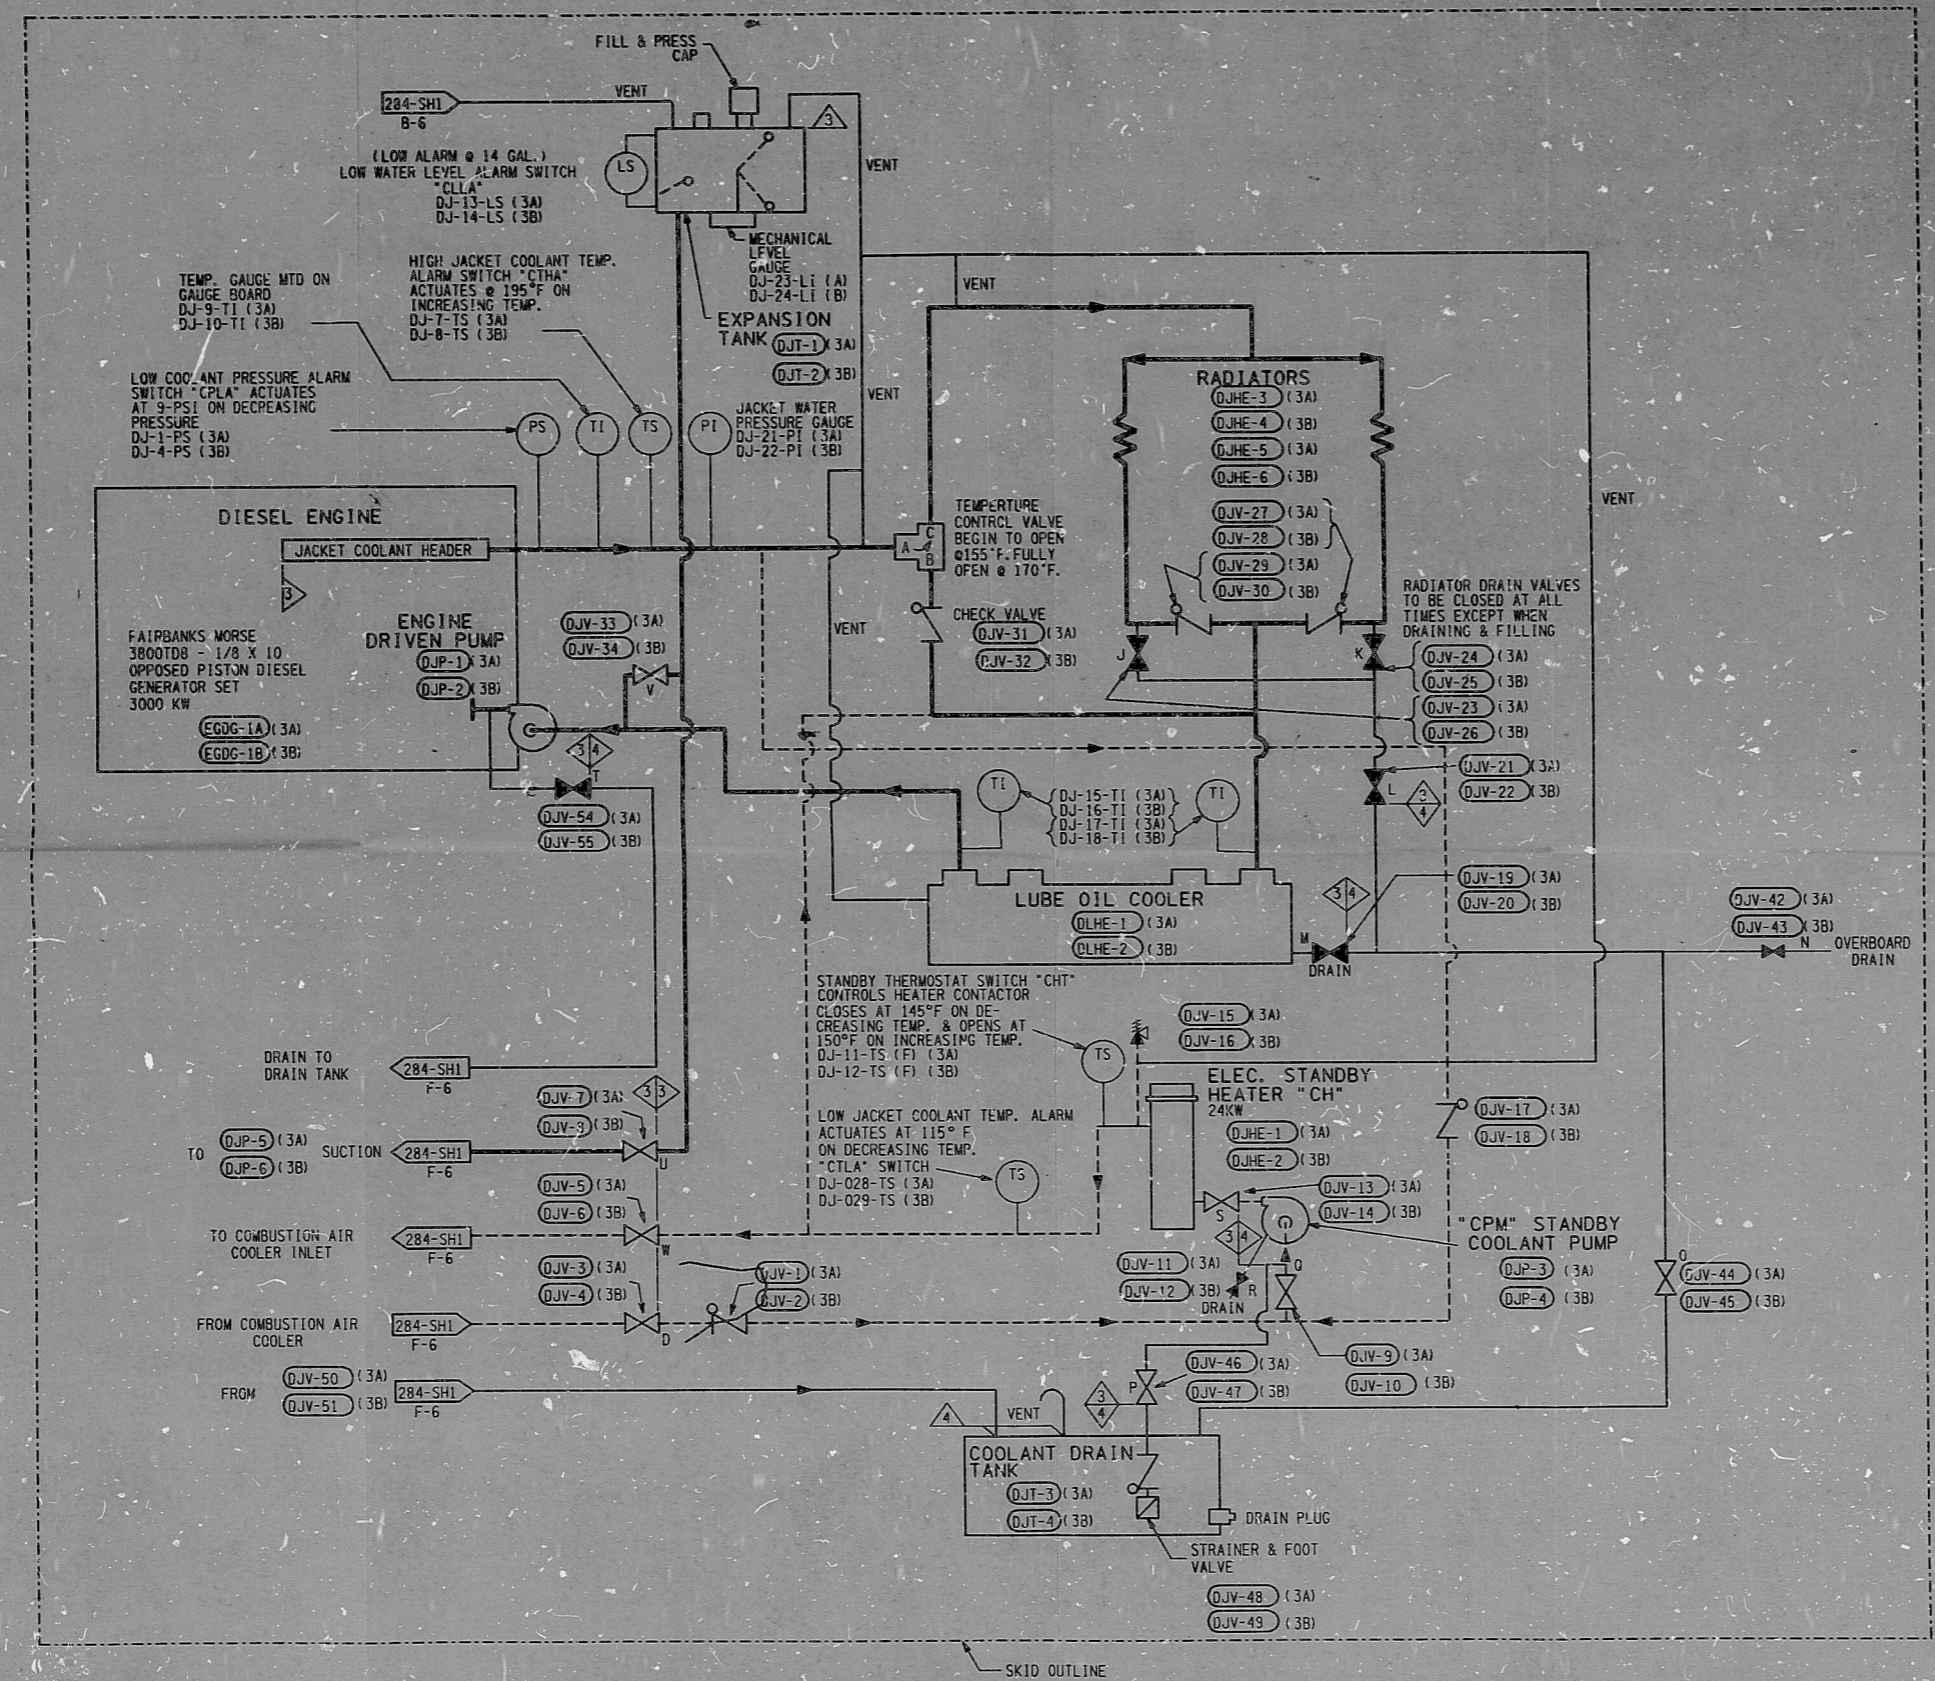

MAR IN PROGRESS

REVISION INFORMATION

TI APERTURE CARD

NO.	REVISIONS	BY	CHECKED	APPROVED	DATE
11	REVISED PER DCN 87-189	SWM	DAW	EMA	4-21-87
10	REVISED PER DCN 87-074	MLG	DAW	EMM	4-21-87
09	REVISED PER DCN 86-293	SWM	RWK	JRM	1-13-87
08	REVISED PER DCN 85-101	CLW	SUR	TVA	7-23-85
07	REVISED PER DCN 85-025	NAC	JRM	GAB	3-15-85
06	AS-BUILT PER MAR 83-12 12-01	JPG	RK	LBT	1-6-84
05	CAD REDRAWN, SYSTEM WALKDOWN, AND AS-BUILT PER MAR 80-11-28-1	JPG	DAW	GAB	8-1-83

FLORIDA POWER CORPORATION
 ST. PETERSBURG, FLORIDA

UNIT NO. 3
 DIESEL
 855,000 KW
 D. J. SYSTEM

JACKET COOLANT FLOW DIAGRAM

IS1 AND ORIGINAL DESIGN BASIS CODE CLASSES FSAR FIG. B-12
 REDRAWN ON CAD SYSTEM
 DRAWN BY: JYM
 CHECKED BY: R.F.L.
 CHECK VERIFIED: R.F.L.
 DATE: 02-29-83
 DATE: 03-23-83
 DATE: 03-23-83

BAYMONT ENGINEERING COMPANY
 FD-302-283
 SHEET 01 OF 01
 SCALE
 DRAWING NUMBER
 REV.

PDR RIDS

8801070456

