




SECTION AA
SCALE: 1"=1'-0"

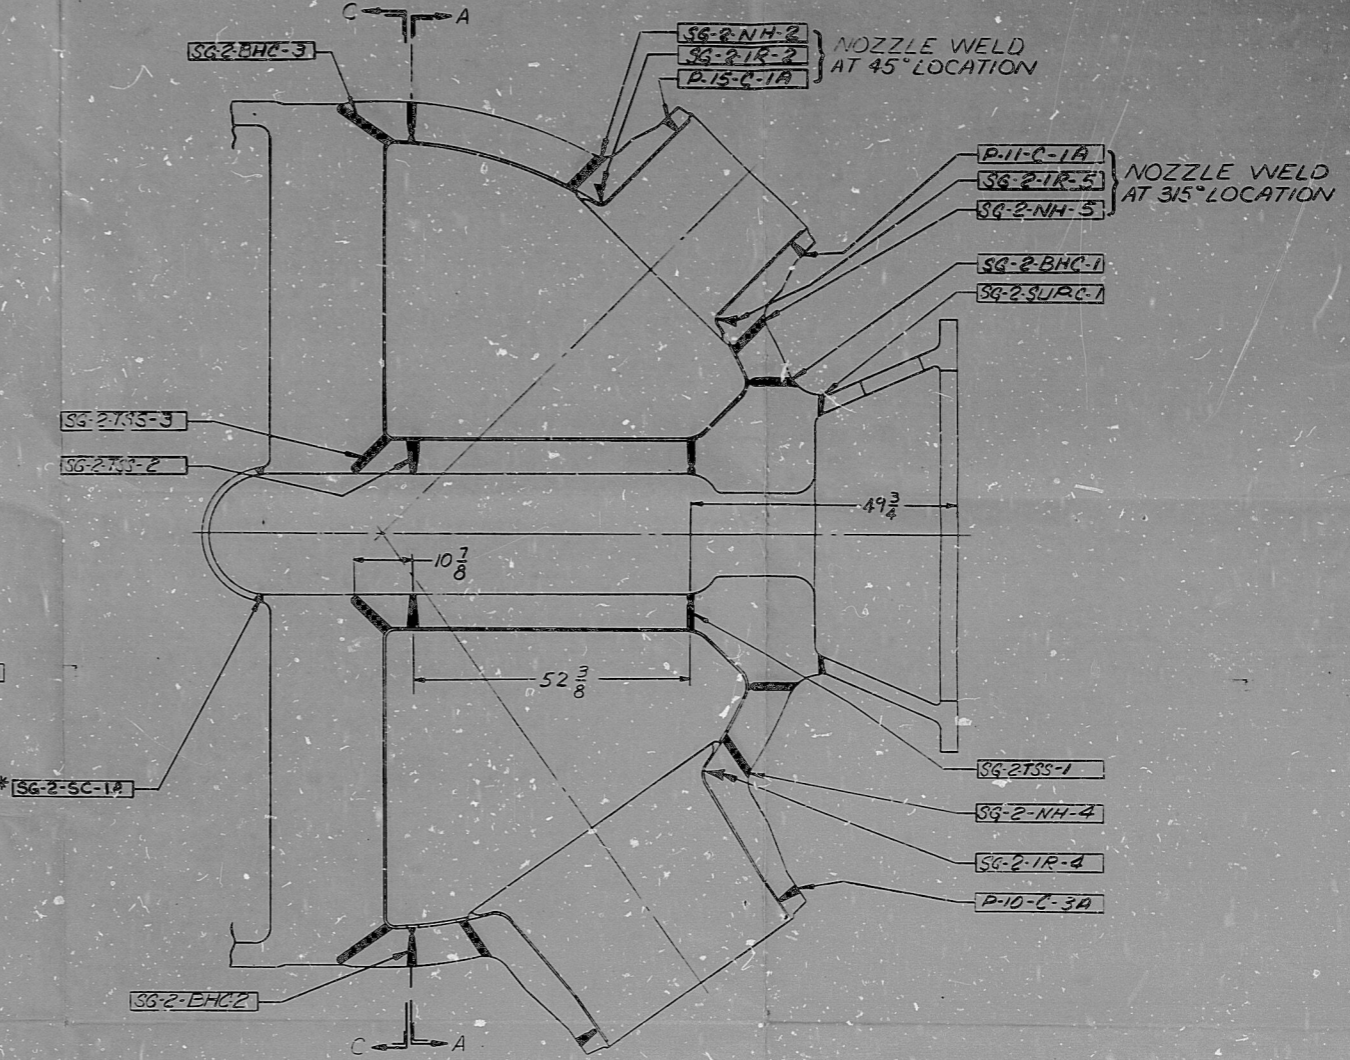

SECTIONAL ELEVATION
SCALE: 1"=1'-0"

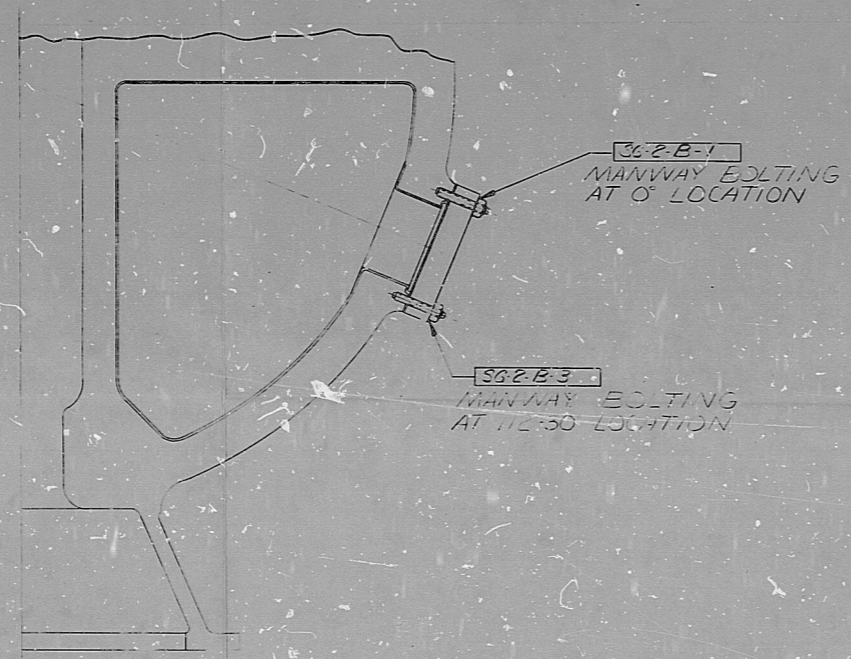

SECTION BB
SCALE: 1"=1'-0"

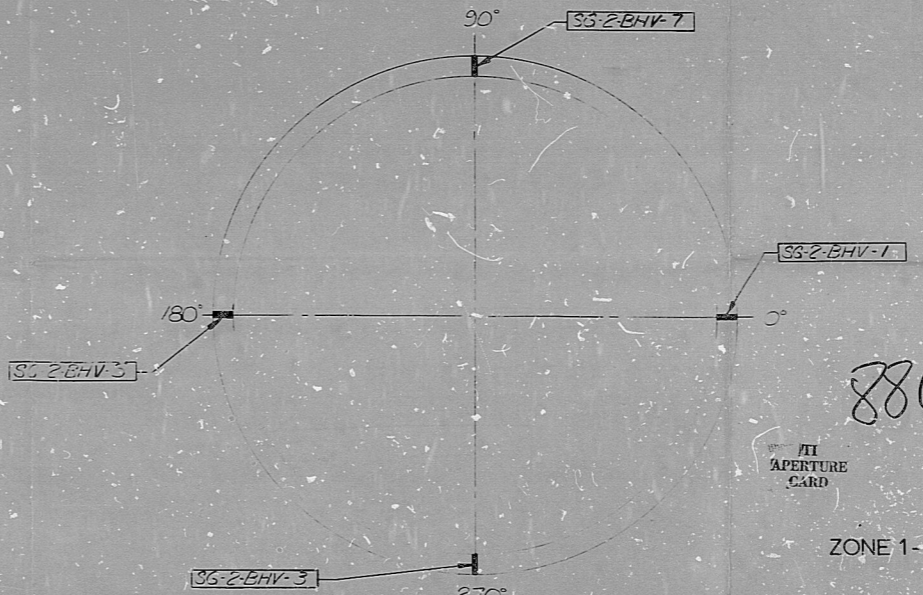

SECTION CC
LOWER EXTENSION RING
SCALE: NONE

* NOTE: THIS IS A CLASS 2 CATEGORY C-A WELD

REVISIONS DURING CONSTRUCTION	PA NO.

8805230069

DATE: APRIL 20, 1974
REVISION: 0

ZONE 1-4 25203-29527 SH. 4

DO NOT SCALE D'WG.	CALC. WT.
SCALE:	ACT. WT.

NEXT ASSY:	CONTRACT NO. 661003
FINAL ASSY:	DATE: APRIL 20, 1974
SUPERSEDED:	APPROVAL: K. HANCOCK
SUPERSEDED:	

NO.	BY	DATE	REVISION
1/4	3/1	12/13	AS-BUILT PER DCR-713-403-80
1/4	2/1	12/13	AS-BUILT PER DCR-713-403-86
034	1/1	12/13	AS-BUILT PER DSR-713-1304-84

RELEASED FROM GFR CONTROL
E-NEU-661-003

QA

STEAM GENERATOR WELD DESIGNATIONS
SG #2
E-NEU-661-003

PDR RIDS

8805230069

