

REACTOR VESSEL WATER LEVEL SYS 'B'


NEW YORK POWER AUTHORITY
 FITZPATRICK STATION UNIT 1
 IEC LOOP DIAGRAM
 REACTOR VESSEL
 WATER LEVEL SYSTEM 'B'

GAI DWG. NO. 5256 1 733 808-046-2

DATE	DRWN	DRAWING NO.	REV. NO.	REV.
03/21/85	IEC	11825-LP-023-3D	3B	
DESIGNED BY	ENGINEER	GILBERT ASSOCIATES, INC. ENGINEERS AND CONSULTANTS READING, PA.		
SCALE	DATE	09/23/80		
REVISIONS	NO.	DATE	BY	REASON
1	3A	09/23/80	IEC	REVISED AS NOTED
2	3B	03/21/85	IEC	REVISED AS NOTED

ISSUED WITH PACKAGE FI-85-053
 FOR REFERENCE ONLY.

CONSTRUCTION	ENGR
PRELIMINARY	
RELEASED FOR	
DATE	

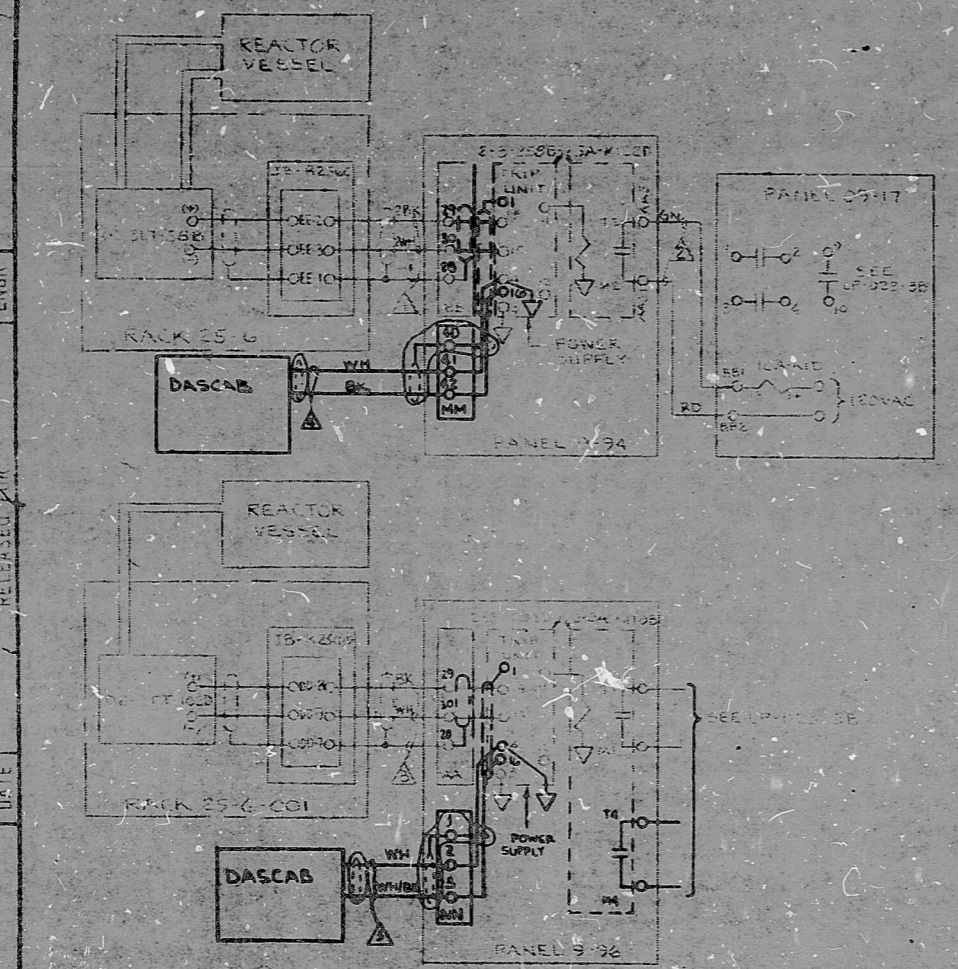

REFERENCE DWG.

1. FE-3CY 300 444 375 370 444
2. 731E400 104 344 170 29 32 77
3. 731E 305
4. 307E 237
5. 305E 124
6. 115E 612, 115 701E
7. ELEMENTARY DIAG. 055E 458 445
8. CONNECTION DIAG. 071E 115 432 74 343
9. INTERCONN. DIAG. 014E 100 341 2 384
10. CALIBRATION 115E 505E 05 01 10 11

3B	REVISED	AS NOTED
3A	REVISED	AS NOTED

CABLE NO.

- ▲ IAPSDLX70
- ▲ IAPSDLCT11
- ▲ IAWABENT00
- ▲ IEPICLX084
- ▲ IEPICLX085

8806200073

THE DRAWING NUMBER OF THIS REPRODUCIBLE
 IS 11825-LP-023-3D-3A REV.

THIS DRAWING IS A REPRODUCIBLE REVISED
 FOR MODIFICATION ATTS

MODIFICATION NO. FI-85-053. ORIGINAL
 WILL BE REVISED UPON COMPLETION AND
 VERIFICATION OF MODIFICATION.

TI
 APERTURE
 CARD

3	AS-BUILT FER MOD NO FI-82-053	DRWN BY	ENG VERIF	APPR. DATE
REV.	DESCRIPTION	DRWN BY	ENG VERIF	APPR. DATE

REVISION BY NYPA

JAMES A FITZPATRICK NUCLEAR POWER PLANT
 POWER AUTHORITY OF THE STATE OF NEW YORK

TITLE: REACTOR VESSEL WATER LEVEL SYS. "B"

COMPONENT I.D. NO.

VENDOR: GILBERT ASSOCIATES, INC.

VENDOR DWG. NO. 5256 1 733 808-046-1

FILE NO. 11825-LP-023-3D

REV. 3B

PDR RIDS

8806200073

