
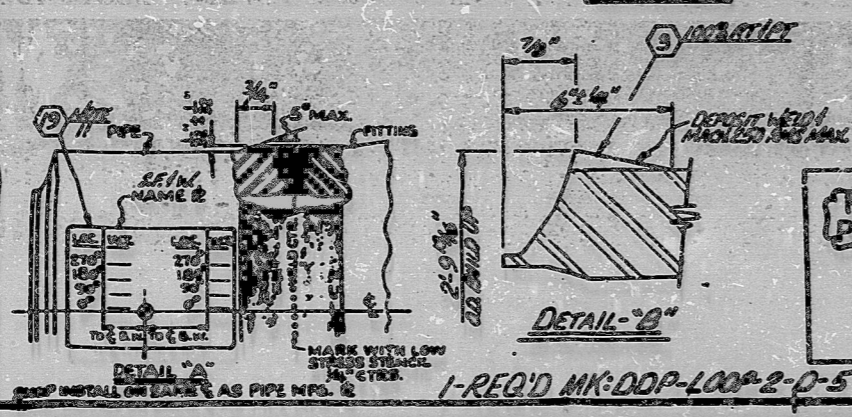


WELD END DIMENSIONAL CHECK		WALL THICKNESS AND WELD JOINT LOCATION	
①	C=22.700 ACTUAL=21.627	LIP THICKNESS=.080 ACTUAL=.072	WALL THICKNESS
②	C=2.853 ACTUAL=2.853	LIP THICKNESS=.053 ACTUAL=.053	WALL THICKNESS
③	C=2.853 ACTUAL=2.853	LIP THICKNESS=.053 ACTUAL=.053	WALL THICKNESS
④	C=1.367 ACTUAL=1.366	LIP THICKNESS=.061 ACTUAL=.061	WALL THICKNESS
⑤	C=1.367 ACTUAL=1.366	LIP THICKNESS=.063 ACTUAL=.063	WALL THICKNESS

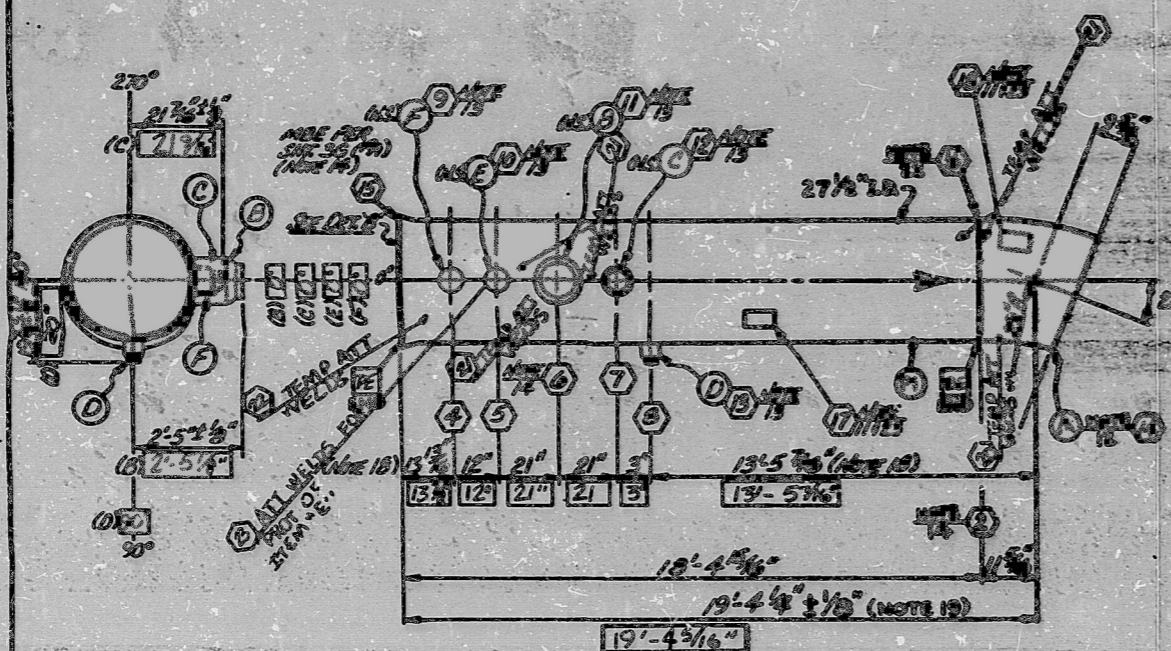

NPT  
 18849  
 (Manufacturer's Serial No.)  
 1979  
 (Year Made)

FOR INFORMATION ONLY

WELD AS BUILT DATA  
 REL. ITEM B, C, D, E, F, G, H, I, J, K, L, M, N, O, P, Q, R, S, T, U, V, W, X, Y, Z

ITEM	DESCRIPTION	DATE	BY	CHKD
1				
2				
3				
NUCLEAR SAFETY RELATED  
 EAC-002-176718-001

ANSTEC APERTURE CARD



PDR RIDS

9403180124

