


12179-EE-1EH

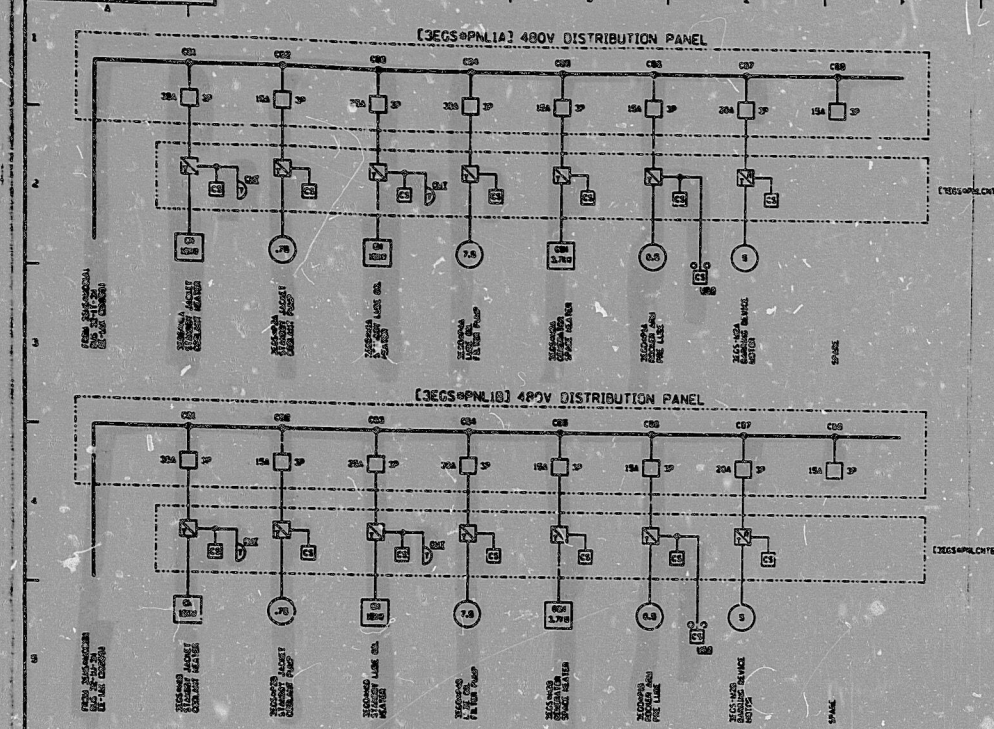

- LEGEND:**
- MAGNETIC STARTER
 - ENCLOSED CONTROL TRANSFORMER
 - REVERSING STARTER
- REFERENCES:**
- ONE LINE DEVICE MESSAGES 12179-ESM-2A
 - ONE LINE DEVICE SYMBOLS 12179-ESM-2B THRU 2C
 - ONE LINE DEVICE DESCRIPTIONS 12179-ESM-2L THRU 2P
 - ELECTRICAL EQUIPMENT ENGINE CONTROL 2447-300-241-0004 (32241 SH 41)
 - 3ECS#PML1A 2447-300-241-0005 (32241 SH 45)
 - 3ECS#PML1B 12179-EE-LAN-100001
 - 480V ONE LINE DIAG. 12179-EE-LAN-100001
 - 400V ONE LINE DIAG. 12179-EE-LAN-100001
- WORKING DIAGRAMS:**
- 3ECS#PML1A/PML1B 2447-300-241-0004 (32241 SH 41)
 - 3ECS#PML1A/PML1B 2447-300-241-0005 (32241 SH 45)
 - 3ECS#PML1A/PML1B 12179-EE-LAN-100001

ANSTEC
APERTURE
CARD

Q.A. CAT. I & II
OPERATIONS CRITICAL

CAD		DATE	DESCRIPTION	BY	CHK	DATE
1	AS BUILT	12/17/79	12179-EE-1EH	W. J. STONE		
2	REVISION					
3	REVISION					
4	REVISION					
5	REVISION					
6	REVISION					
7	REVISION					
8	REVISION					
9	REVISION					
10	REVISION					

S&W DWG. NO. 12179-EE-1EH

9711030154

PDR RIDS

9711030154 116

