


| CATALOG  | SIZE | TYPE | SPRUE & GRADE | REMARKS |
|----------|------|------|---------------|---------|
| PIPE     | 40   | SL   | ASTM A-333-80 |         |
| FLANGES  | 24   | SL   | ASTM A-333-80 |         |
| JOINTS   | 24   | SL   | ASTM A-333-80 |         |
| ELBOWS   | 24   | SL   | ASTM A-333-80 |         |
| TEES     | 24   | SL   | ASTM A-333-80 |         |
| SOCKETS  | 24   | SL   | ASTM A-333-80 |         |
| VALVES   | 24   | SL   | ASTM A-333-80 |         |
| ADAPTERS | 24   | SL   | ASTM A-333-80 |         |

| ITEM NO. | DESCRIPTION              | QTY | UNIT | REMARKS |
|----------|--------------------------|-----|------|---------|
| 1        | PIPE 40" DIA. X 10' LONG | 1   | EA   |         |
| 2        | FLANGE 24" DIA.          | 1   | EA   |         |
| 3        | JOINT 24" DIA.           | 1   | EA   |         |
| 4        | ELBOW 24" DIA.           | 1   | EA   |         |
| 5        | TEE 24" DIA.             | 1   | EA   |         |
| 6        | SOCKET 24" DIA.          | 1   | EA   |         |
| 7        | VALVE 24" DIA.           | 1   | EA   |         |
| 8        | ADAPTER 24" DIA.         | 1   | EA   |         |

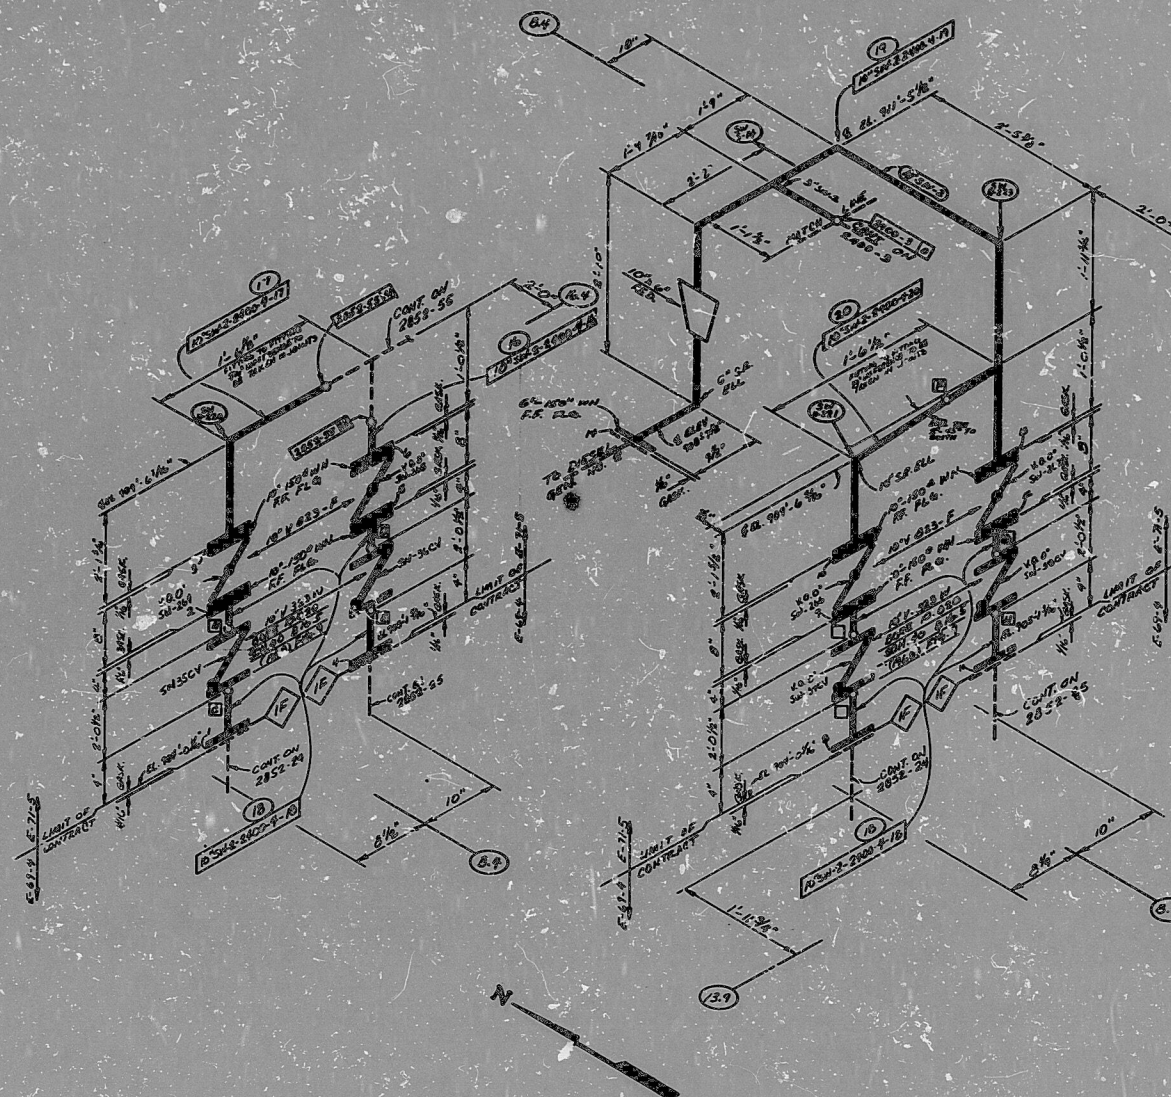

- GENERAL NOTES:
1. MATERIALS SPECIFICATIONS PER CONTRACT E-11-5
  2. ALL MATERIALS, FABRICATION, INSPECTION, INSTALLATION, CERTIFICATIONS, RECORDS AND ALL OTHER REQUIREMENTS CONFORM TO SPECIFICATION E-11-5 AND ALL ADDENDA AND CONTRACT CHANGES THERE TO.
  3. DESIGN CONDITIONS:  
TEMP. 20°C PRESS. 100 PSIG
  4. WELDING PROCEDURES & END PREPARATIONS FOR FIELD WELDS, SEE JELCO WELDING PROCEDURES & END PREPARATIONS PAGE 11749 3
  5. HYDROSTATIC TEST  
150 PSIG
  6. NON-DESTRUCTIVE TEST REQUIREMENTS:  
NONE
  7. HANGER LOCATIONS TO BE SHOWN ON THE AS-BUILT HANGER DETAIL SHEETS.
  8. SEISMIC LOCATIONS TO BE SHOWN ON THE AS-BUILT SEISMIC DETAIL SHEETS.
  9. VALVE ORIENTATION COUNTERCLOCKWISE FROM TOP LOOKING IN SAME DIRECTION OF FLOW. NORTH IS 0° ON VERTICAL PIPE.

AS BUILT

|                        |         |
|------------------------|---------|
| JELCO INCORPORATED     |         |
| DATE                   | 2/27/96 |
| BY                     | W.E.    |
| CHECKED                | W.E.    |
| APPROVED               | W.E.    |
| 10" SCH. 40 SEWER MAIN |         |
| DIESEL GENERATOR BLDG. |         |
| CLAMP 24" DIA. PIPING  |         |
| 24" SCH. 40 SEWER MAIN |         |
| CLAMP 24" DIA. PIPING  |         |
| CLAMP 24" DIA. PIPING  |         |

ANSTEC  
APERTURE  
CARD

JUNE 24, 1994 NPPD

NON-CONTROLLED PRINT  
FEB 27 1996  
N.P.P.D., R.A.D.

PDR RIDS

9604250200

