


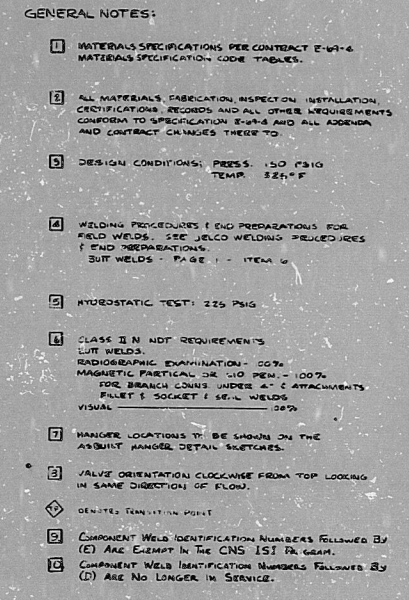

**ANSTEC
APERTURE
CARD**

AS BUILT	
 North Carolina Department of Public Safety Police Division	
COOPER NUCLEAR STATION	
JULCO INCORPORATED	
DESIGN: M.D.T.	DATE:
ASSEMBLY:	FILE NO. 61003
DESIGNED:	DRAWN:
PLAN TITLE	
10" H.P. SECTION - PLANS TO H.P.C.I.	
PUMP DOWN FROM TURBINE NOZZLE NO. 22	
CONST. DATA 21-5 REV. 1 21-6 REV. 1	
312 PLOW SHEET 2044 REV. 4 21-6	
PLAN NO.	REV.
2011-G	NO6
CLASS - IN PLANS 1555M1C	

PDR RIDS

96042503/9

