


LEGEND  
 ——— NON CODE CLASS PIPING  
 - - - - - NON NUCLEAR PIPING

PIPING & INSTRUMENT DIAG.  
 25203-26018

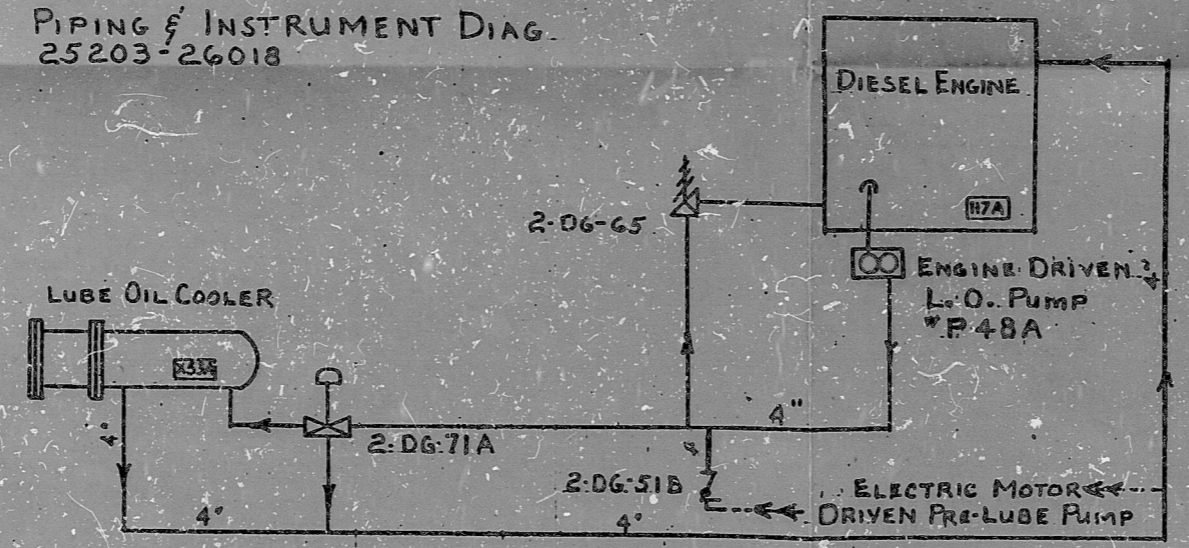

TI  
 APERTURE  
 CARD

Q.A.

8603100451

REVISIONS DURING CONSTRUCTION		P	D

NORTHEAST UTILITIES SERVICE CO.			
NORTHEAST NUC. POWER STATION			
MILLSSTONE NUC. POWER STATION - UNIT 2			
BOUNDARY DIAGRAM - EMERGENCY DIESEL			
GENERATORS 'A' 'C' 'D' - LUBE OIL SYSTEMS			
BY P.A.L.C.	CHWD	APP 108	APP 208
DATE 2-4-85	DATE 3-7-85	DATE 3/10/85	DATE 3/10/85
SCALE N.T.S.	SCALE N.T.S.	SCALE N.T.S.	SCALE N.T.S.
P.A.B.	DATE	REVISIONS	BY DES. APP. APP. PAT. N/A
N/A	1	AS-BUILT PER 2058-42-S-131-B5	25203-26126 SH 16

PDR RIDS

8603100451

