



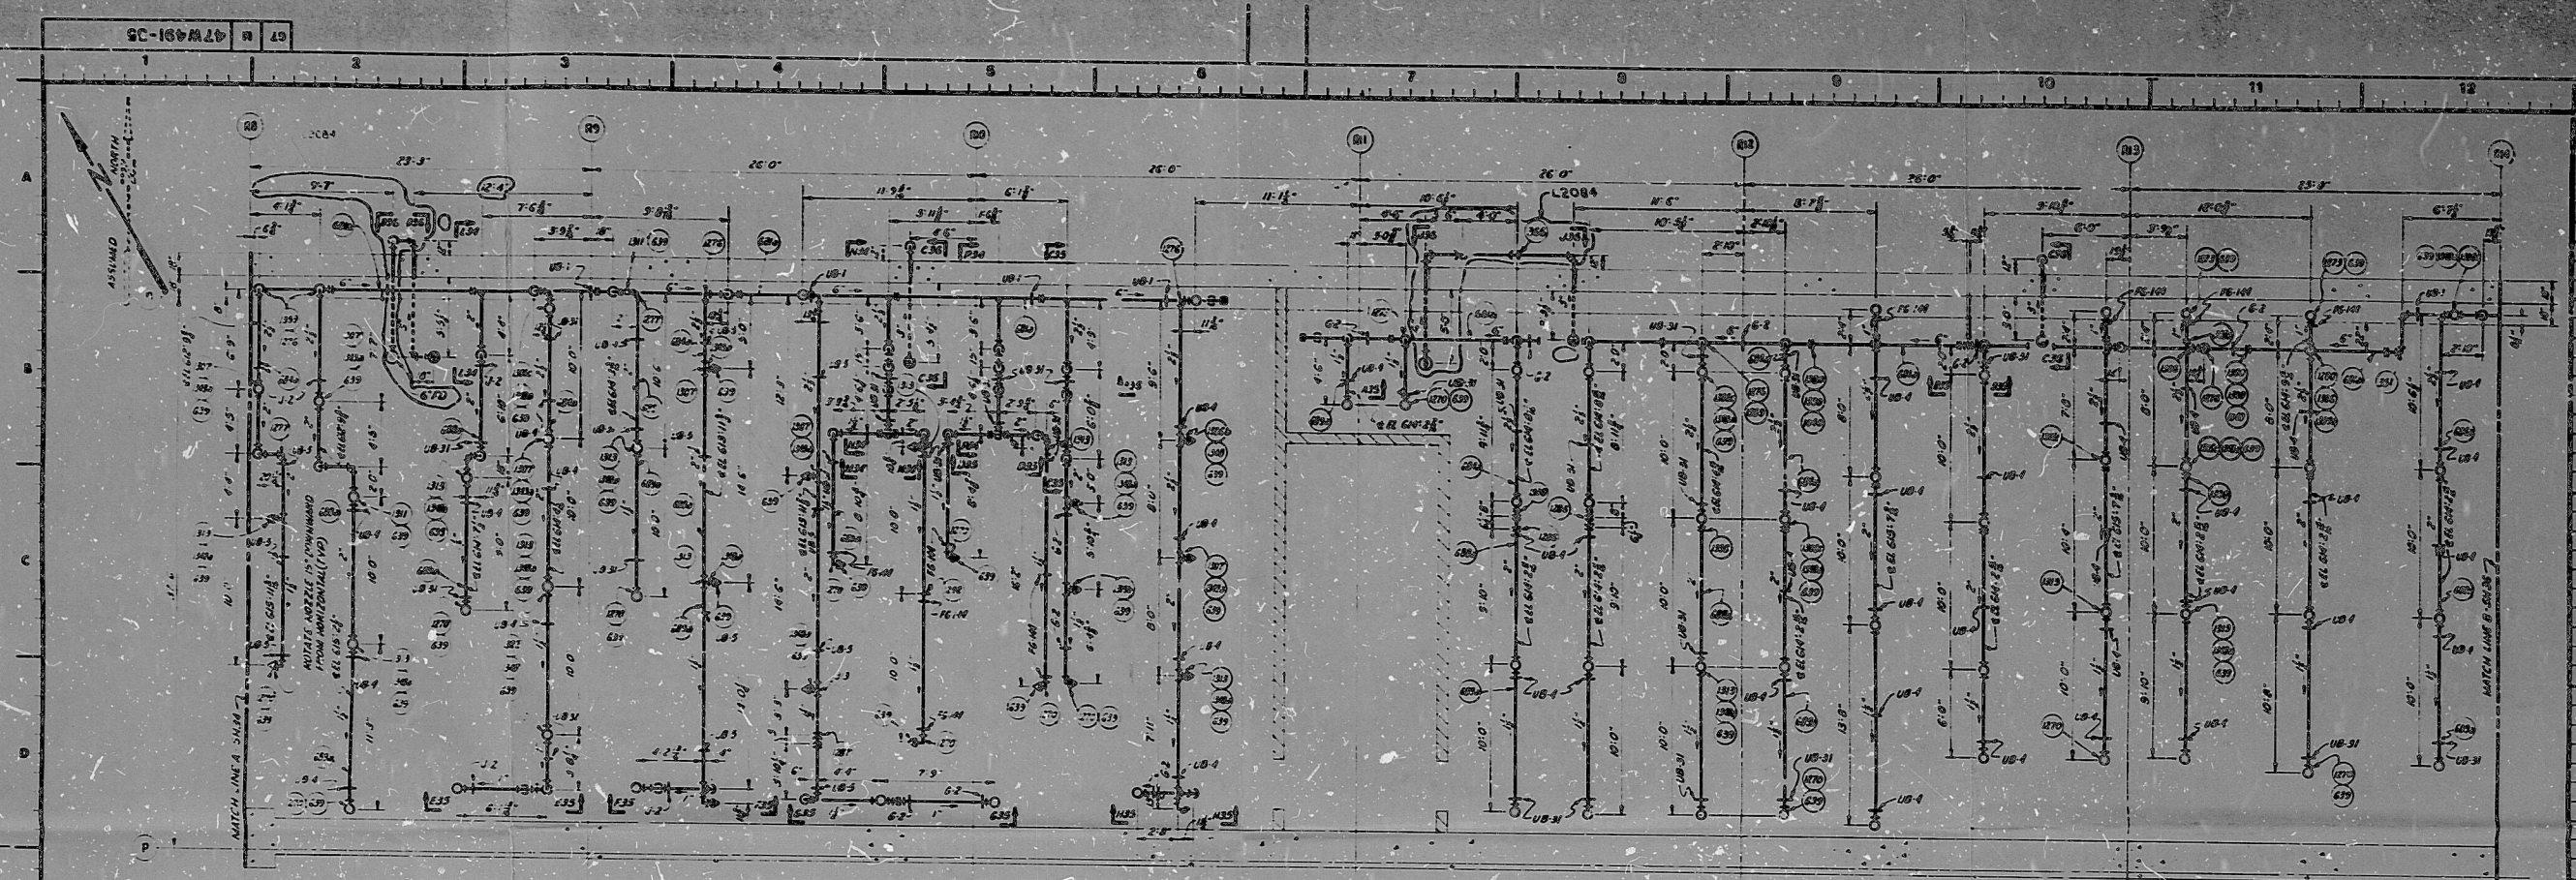

PLAN EL 606.0
SPRINKLER SYSTEM
SPREADER ROOMS A & B

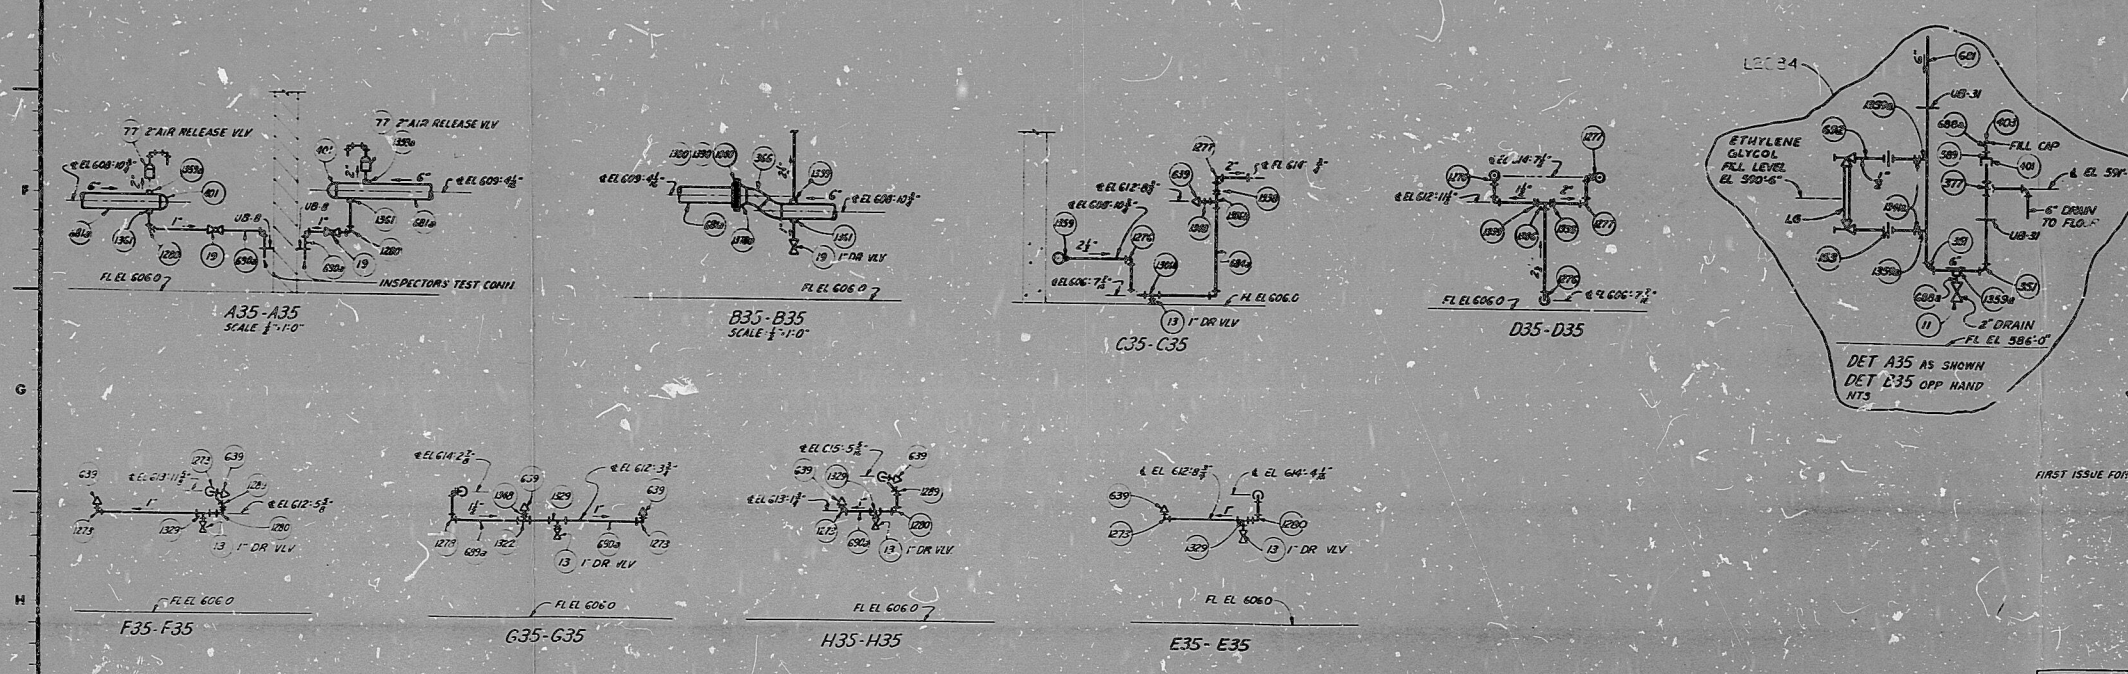

FOR INFORMATION ONLY

POWERHOUSE CONTROL BLDG		UNITS 1-3
MECHANICAL SERVICE WATER, AIR & FIRE PROTECTION		
BROWNS FERRY NUCLEAR PLANT TENNESSEE VALLEY AUTHORITY DIVISION OF ENGINEERING DESIGN		
SUBMITTED	RECOMMENDED	APPROVED
<i>E.E. Chandler</i>	<i>W.R. Smith</i>	<i>A.D. Montgomery</i>
KNOXVILLE 4-27-76		67 4 47W 491-35 R2
RECORD DRAWING AS CONSTRUCTED		

PDR RIDS

8809120064

