




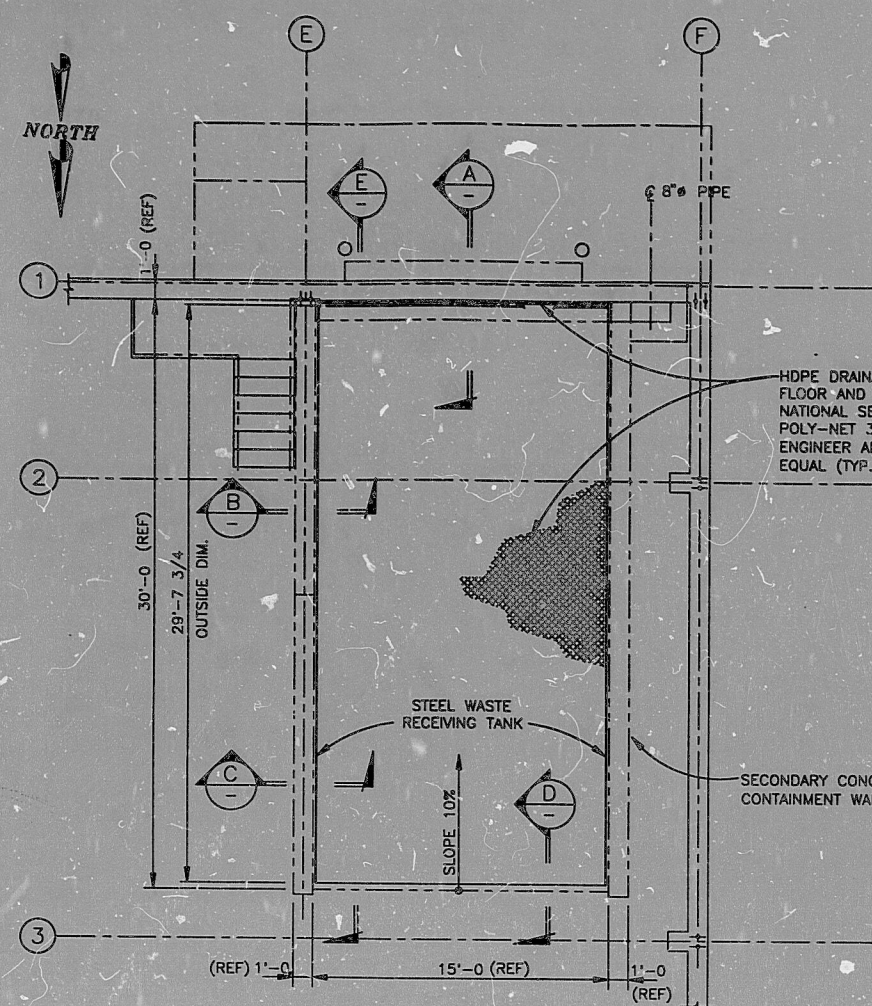


WASTE RECEIVING TANK - PLAN
SCALE: 1/4"=1'-0"

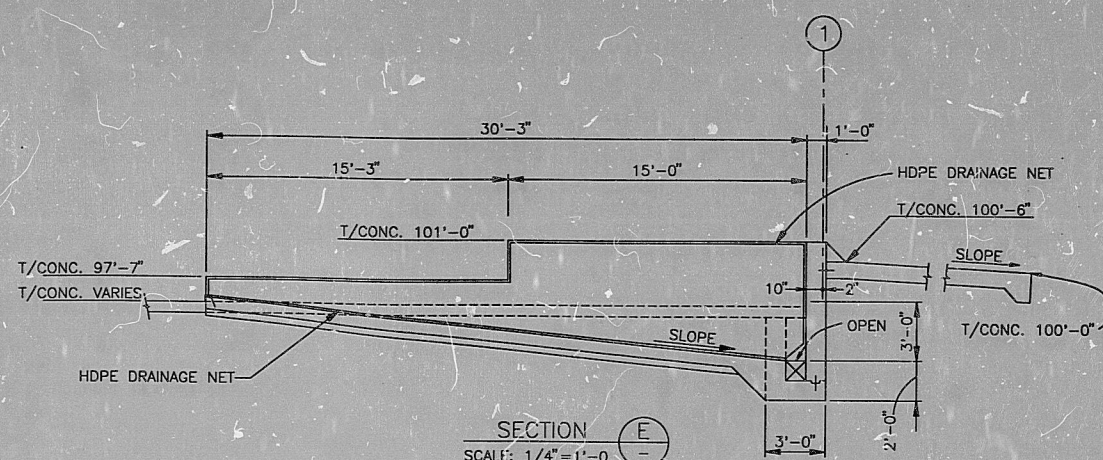


SECTION E-E
SCALE: 1/4"=1'-0"

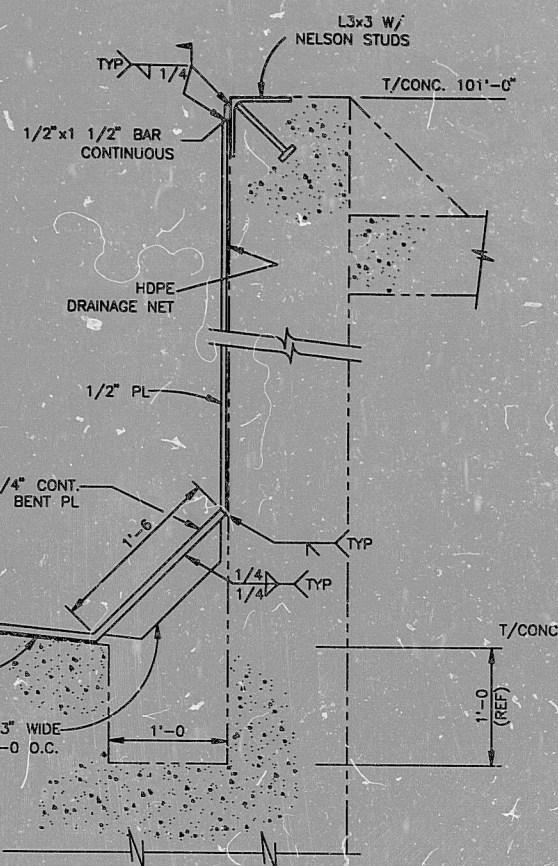

SECTION A-A
SCALE: 1 1/2"=1'-0"

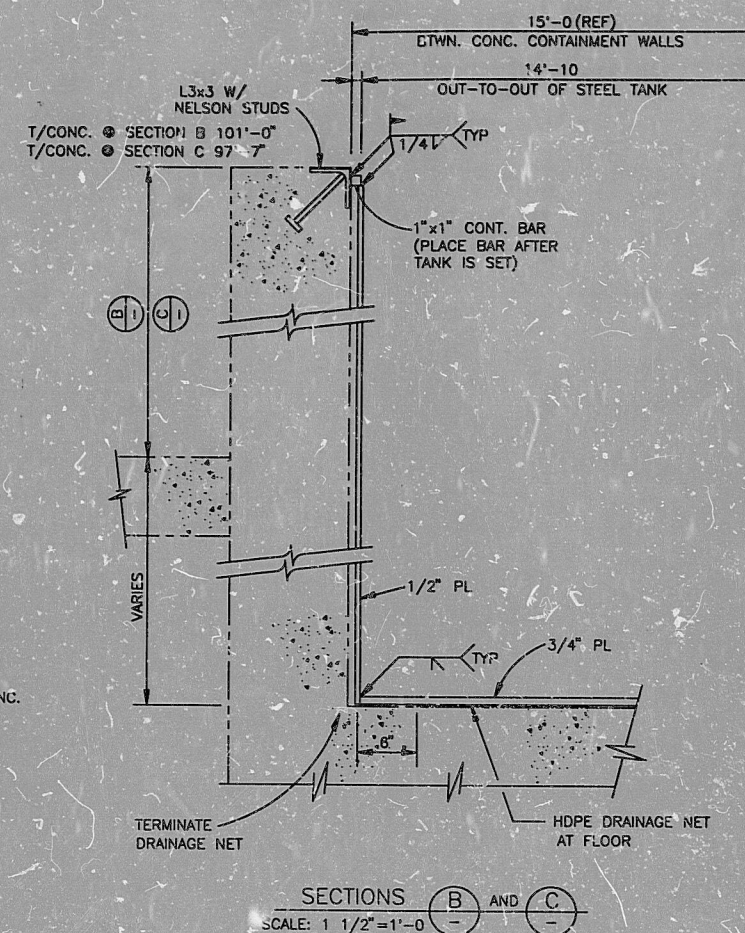

SECTIONS B-B AND C-C
SCALE: 1 1/2"=1'-0"

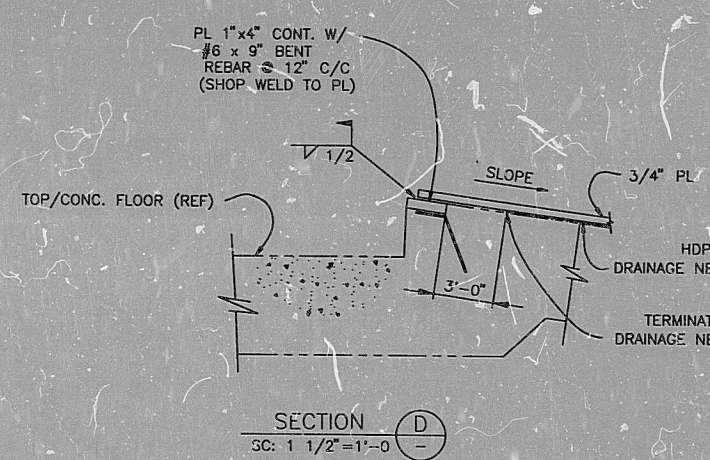

SECTION D-D
SCALE: 1 1/2"=1'-0"

NOTES:

1. FOR GENERAL STRUCTURAL STEEL NOTES SEE DWG. 9317-S1.
2. WORK THIS DWG. W/ DWG. 9317-C8.
3. ALL WELDS FULL PENETRATION U.N.
4. REV. 2 CERTIFIED BY BYRON L. SCHMIDT, P.E. (LIC. NO. 5287) OF ROBERTS & SCHAEFER.

ANSTEC
APERTURE
CARD



				6/15/93	CDH	MS	CERTIFIED								
2/13/95	SJP	AS-BUILT DRAWING---INITIAL CONSTRUCTION		6/31/93	NMc	PAY	ISSUED FOR APPROVAL								
11/15/93	CES	CHANGED NORTH ORIENTATION		6-7-93	VDC	BLS	CONVERTED TO AUTOCAD								
10/19/93	SDM	REVISED SECTION		6-1-93	VDC	BLS	ISSUED FOR APPROVAL								
REV	DATE	BY	CHECK	DESCRIPTION OF REVISION				REV	DATE	BY	CHECK	DESCRIPTION OF REVISION			

ENVIROCORE
OF UTAH, INC.
THE SAFE ALTERNATIVE

MS/VDC
BLS
DJS/CES
gkc

WASTE RECEIVING CONTAINMENT TANK
WASTE TREATMENT FACILITY
CLIVE, UTAH

AS NOTED
4/28/93
9317-S8

9803020242

PDR RIDS

9803020242

