

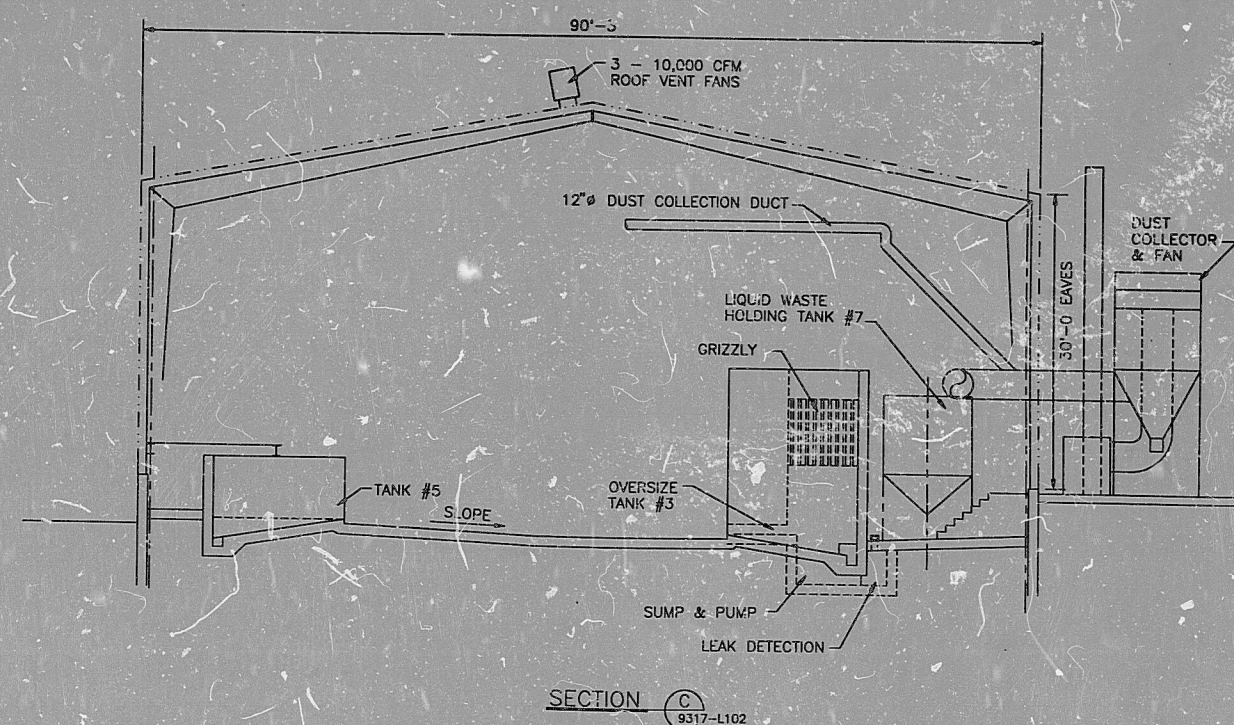
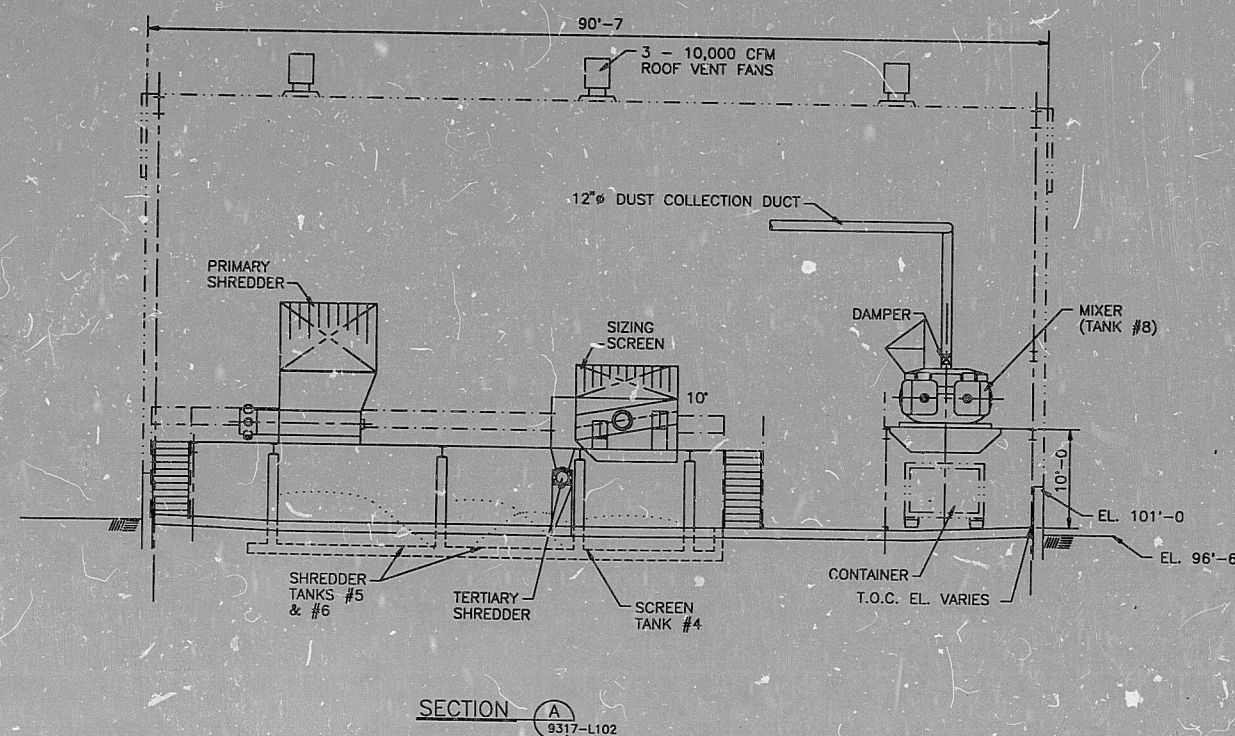
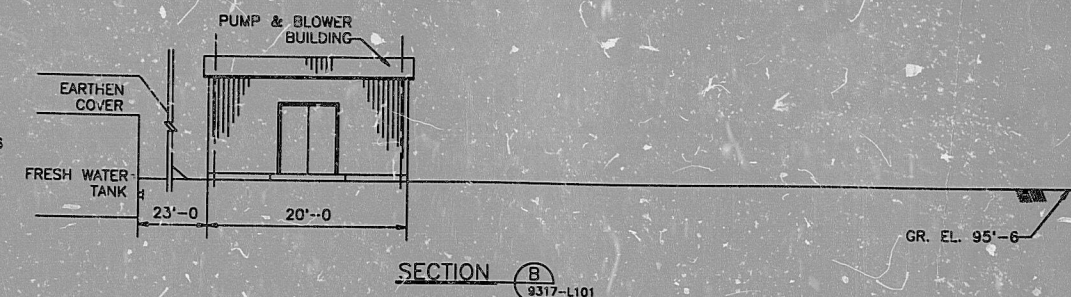
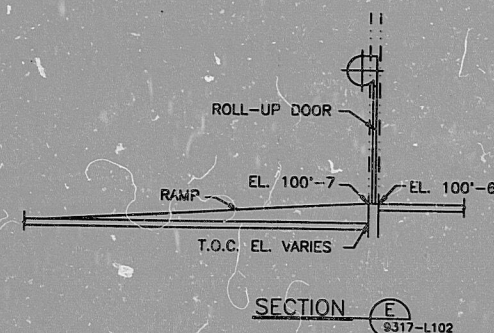


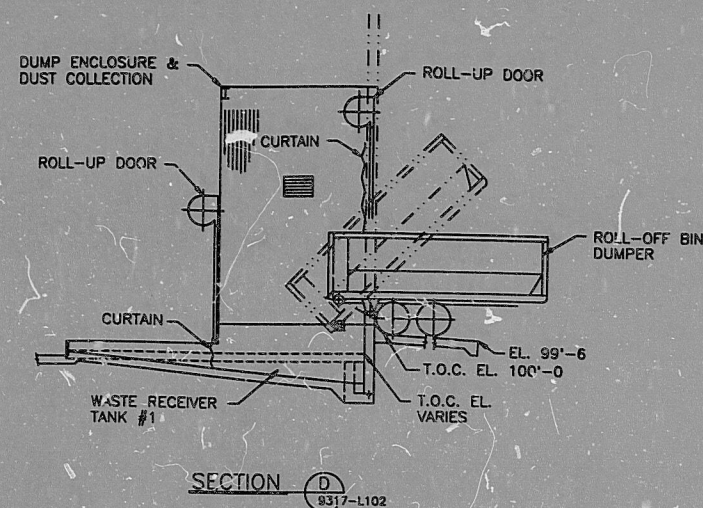

4-12-95	SJP	REMOVED FUTURE INSTALLATIONS	5-4-94	SJP	MOVED REAGENT BINS, ETC.
4-4-95	GW	ADDED DUST COLLECTION TO MIXER	10-18-93	-	CERTIFIED
2-13-95	SJP	AS-BUILT DRAWINGS—INITIAL CONSTRUCTION	8-9-93	-	FOR APPROVAL
			7-28-93	-	PRELIMINARY
REV	DATE	BY	CHECK	DESCRIPTION OF REVISION	

ENVIROCARE
OF UTAH, INC.
THE SAFE ALTERNATIVE

DESIGNED BY	SECTIONS	SCALE 1/8" = 1'-0"	DATE 4-26-93
CHECKED BY	WASTE TREATMENT FACILITY		
APPROVED BY	ENVIROCARE SITE—CLIVE, UTAH		
		9317-M3	

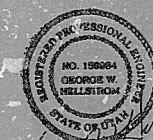

NOTES:
REV. 0 CERTIFIED BY
DAVID L. CARTER, P.E.
(LIC. NO. 6115) OF
ROBERTS & SCHAEFER.

ANSTED
APERTURE
CARD

9803020255

PDR BIDS

9803020255

