



8098-1-232

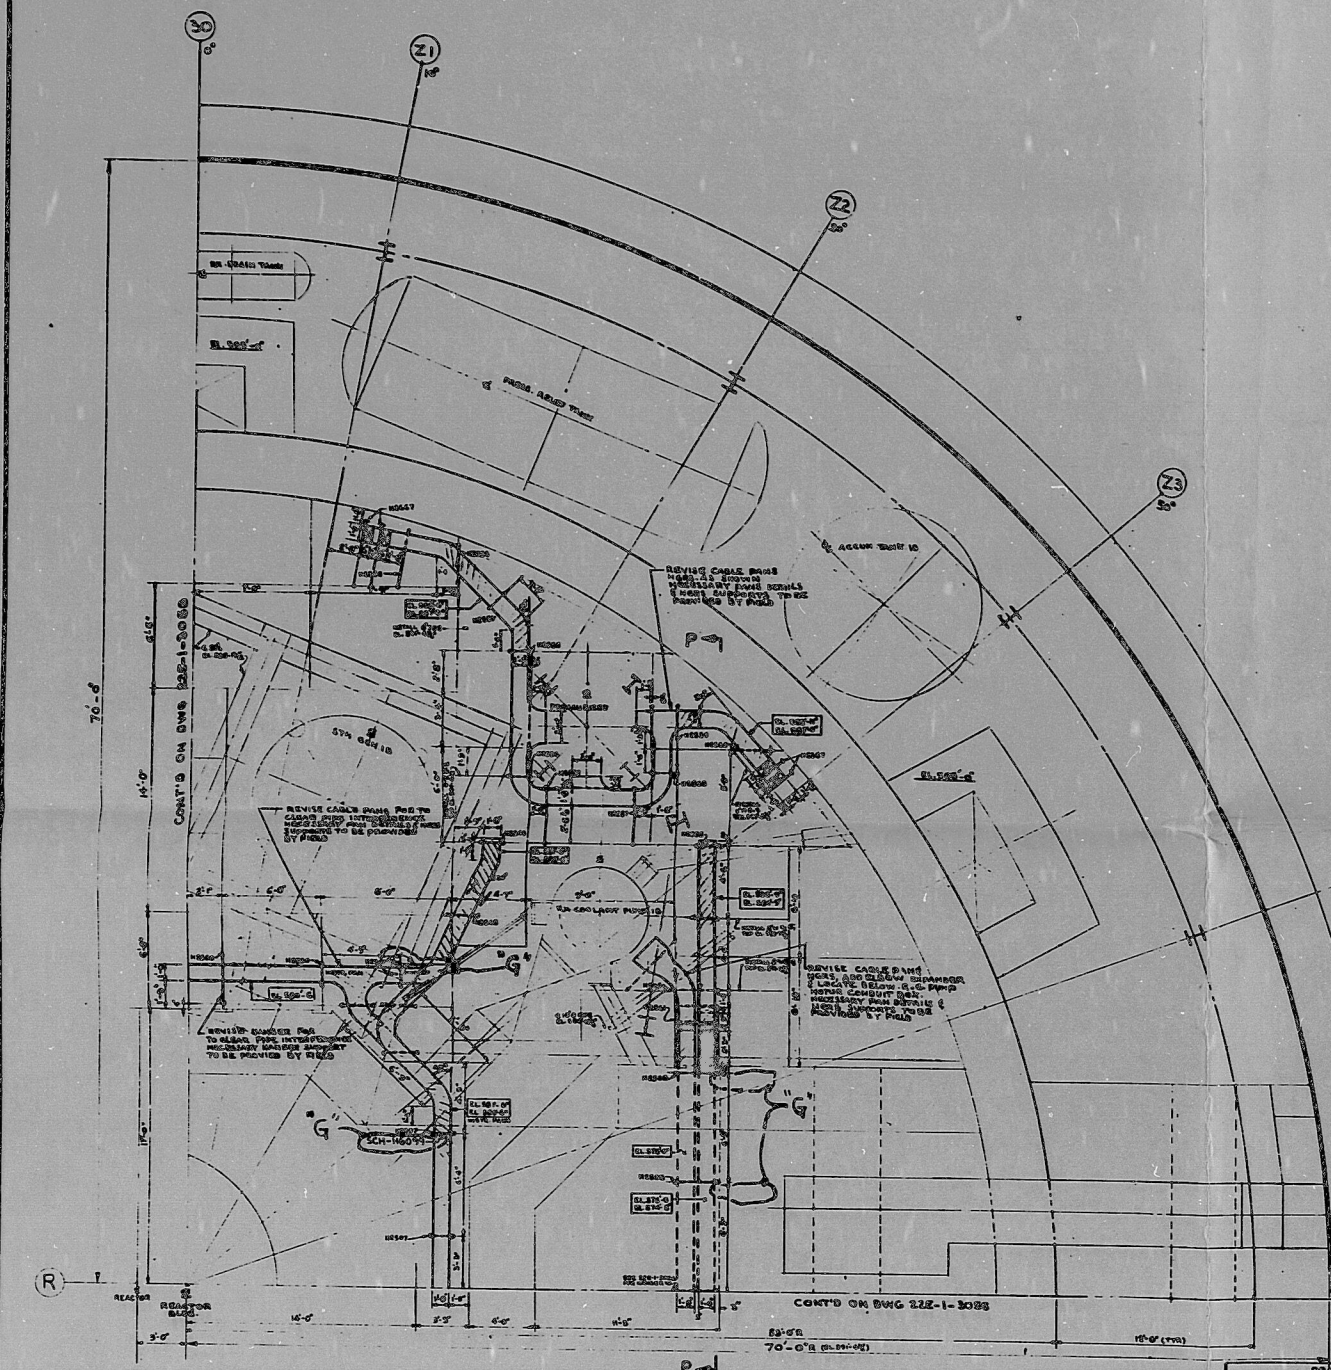


1. THE CABLE TRAYS INSTALLED EXCEPT ON THIS DRAWING HAVE BEEN FIELD VERIFIED AS PART OF THE CABLE SYSTEM INSPECTION AND REVIEW PROCESS FOR THE FOLLOWING ATTITUDES ONLY:
 - A. CABLES ABOVE THE TRAY SIDEWALLS.
 - B. CABLES OUTSIDE OF TRAYS.
 - C. CABLES EXISTING TRAYS AND ROUTED WITH CABLES OF OTHER DIVISIONS.
 - D. TRAYS IN TRAY CABLE TRAYS AS INDICATED BY THE TRAY SIDEWALLS.
 - E. CABLES TRAYS THAT HAVE NOT BEEN FIELD VERIFIED.
2. EXISTING CABLE TRAY/CABLE TRAY SUPPORT LOCATIONS, CONFIGURATIONS & ELEVATIONS HAVE BEEN FIELD VERIFIED UNLESS REQUIRED TO FACILITATE CABLE TRAY SYSTEM REPAIRS.
3. THE CABLE SYSTEM MAINTENANCE AND REVIEW FOR THIS AREA WAS COMPLETED ON 2-11-01.

- NOTES**
1. PER CABLE PANS & REACTOR INSTALLATION NOTES SEE DWG 22E-1-3038.
 2. PER CABLE PANS & REACTOR INSTALLATION NOTES SEE DWG 22E-1-3038.
 3. CABLES THAT ARE SHOWN AS NOT INSTALLED SHALL BE INDICATED BY A DASHED LINE WITH THE DATE 12-1-2000.
 4. ALL CABLES ARE SHOWN WITH A 6" RADIUS UNLESS OTHERWISE NOTED.
 5. SCH-16000 SERIES INDICATES CABLE TRAY SUPPORT HIGHLIGHTS; FOR DETAILS, SEE DWG 22E-1-3038.

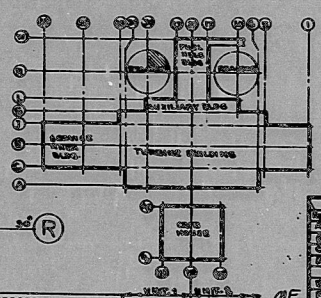

REV	DATE	DESCRIPTION	PREPARED	REVIEWED
G	1-11-72	FOR RECORD DWG 22E-1-3038 REV 1-11-72 REV 1-11-72		

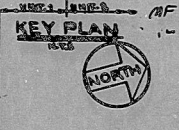

REV	DATE	DESCRIPTION	PREPARED	REVIEWED
A	1-11-72	FOR RECORD DWG 22E-1-3038 REV 1-11-72 REV 1-11-72		

CLASS I **REVISED FOR CABLE ROUTING** (1-22-71)

CABLE PANS - REACTOR BLDG.
PLAN EL. 500'-0" **N.W. AREA**
ZION STATION UNIT 1
COMMONWEALTH EDISON CO.
CHICAGO, ILLINOIS

SCALE 1/8" = 1'-0"

DATE 1-11-72

BY [Signature]

CHKD [Signature]

22E-1-3038

MC

9611220082

ANSTEC
APERTURE
CARD

9611220082

PDR RIL

9611220082

