




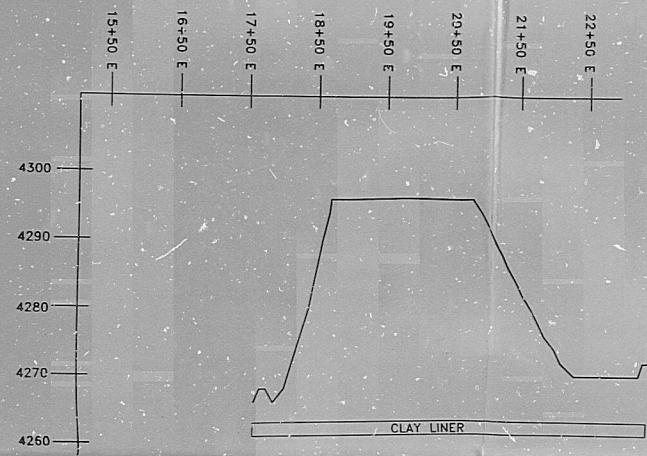

J 10+00 N CROSS SECTION
 9903-03
 HORIZONTAL SCALE: 1" = 100'
 VERTICAL SCALE: 1" = 10'

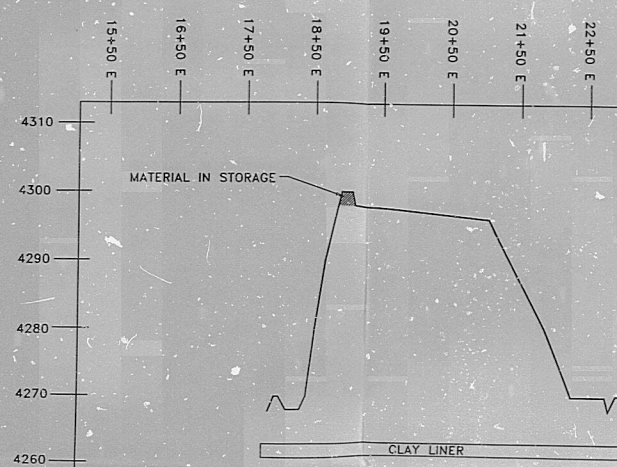


L 12+00 N CROSS SECTION
 9903-03
 HORIZONTAL SCALE: 1" = 100'
 VERTICAL SCALE: 1" = 10'

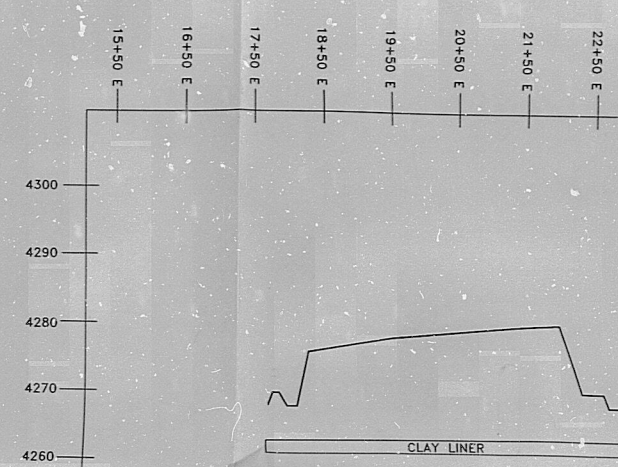


N 14+00 N CROSS SECTION
 9903-03
 HORIZONTAL SCALE: 1" = 100'
 VERTICAL SCALE: 1" = 10'


990440223

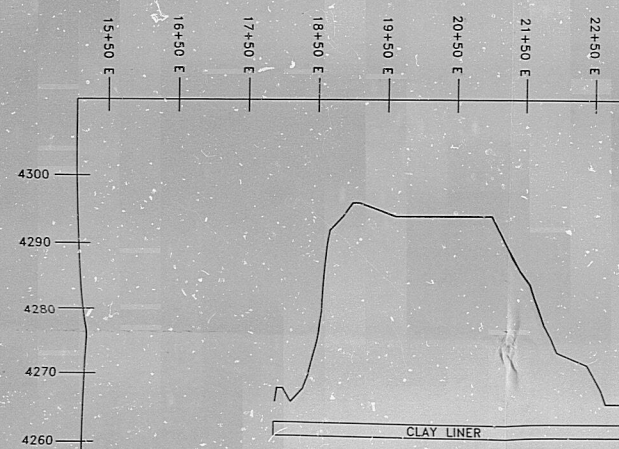

K 11+00 N CROSS SECTION
 9903-03
 HORIZONTAL SCALE: 1" = 100'
 VERTICAL SCALE: 1" = 10'

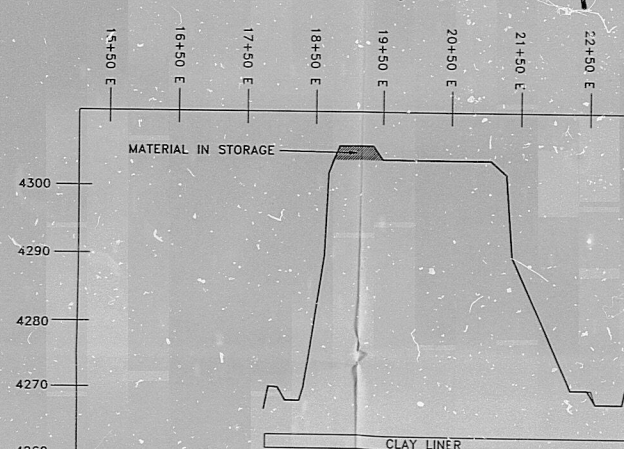

M 13+00 N CROSS SECTION
 9903-03
 HORIZONTAL SCALE: 1" = 100'
 VERTICAL SCALE: 1" = 10'

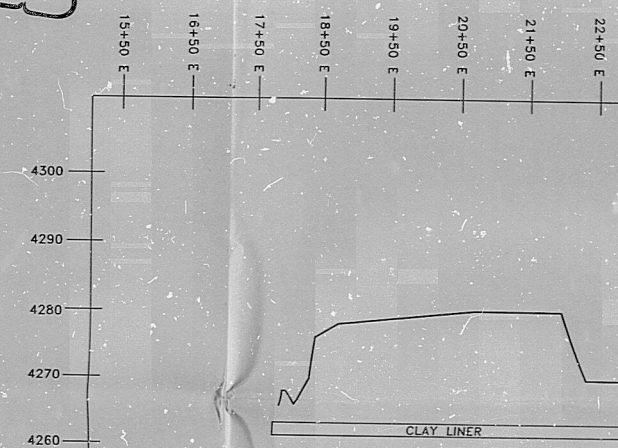

O 15+00 N CROSS SECTION
 9903-03
 HORIZONTAL SCALE: 1" = 100'
 VERTICAL SCALE: 1" = 10'

DATE	BY	DESCRIPTION OF CHANGE	DATE	BY	DESCRIPTION OF CHANGE




ENVIROCARE
 OF UTAH, INC.
 "THE SAFE ALTERNATIVE"

DATE: J. WEST
 DRAWN: D. CUMSTOCK
 PROJECT: 9903-03

11e(2) DISPOSAL CELL
 AS-BUILT DRAWINGS
 CROSS SECTIONS
 CLIVE, UTAH

DATE: 1/26/99
 DRAWN BY: 9903-03
 CHECKED BY:

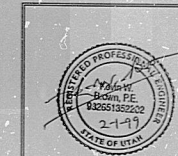

APERTURE
 CARD

990440223

9904140223

PDR RIDS

* 9904060048

9904140223

