




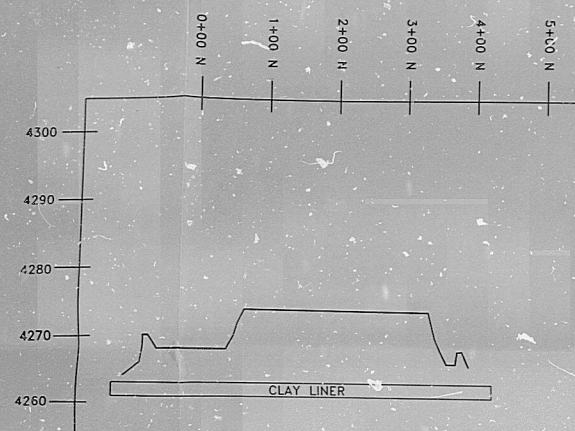

B-B 17+50 E CROSS SECTION
 9903-04
 HORIZONTAL SCALE: 1" = 100'
 VERTICAL SCALE: 1" = 10'

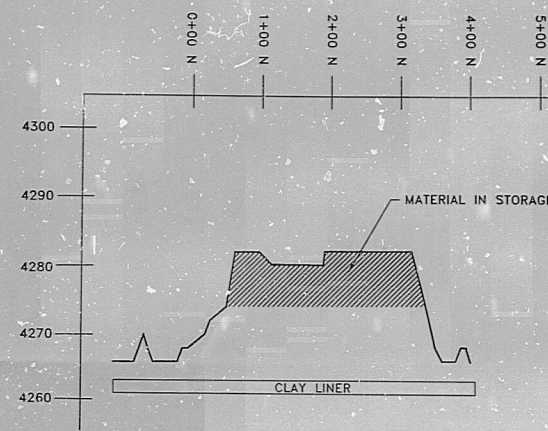

A-A 16+50 E CROSS SECTION
 9903-04
 HORIZONTAL SCALE: 1" = 100'
 VERTICAL SCALE: 1" = 10'

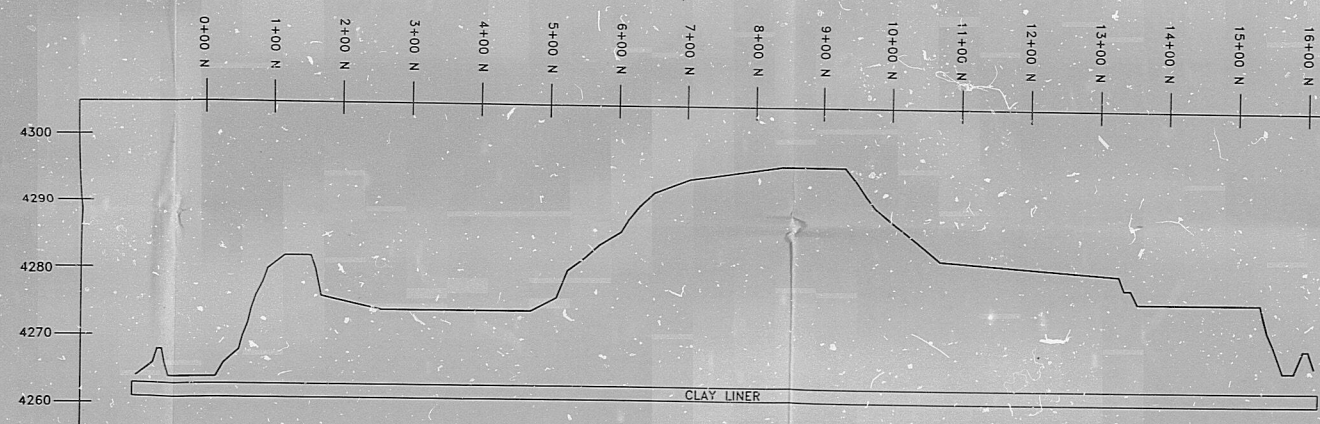

C-C 18+50 E CROSS SECTION
 9903-04
 HORIZONTAL SCALE: 1" = 100'
 VERTICAL SCALE: 1" = 10'

9904140224


DATE	BY	DESCRIPTION OF CHANGE	DATE	BY	DESCRIPTION OF CHANGE



ENVIROCARE
OF UTAH, INC.
 "THE SAFE ALTERNATIVE"

DESIGNED BY
 J. WEST
 CHECKED BY
 D. COASTOCK
 DRAWN BY

116(2) DISPOSAL CELL
 AS-BUILT DRAWINGS
 CROSS SECTIONS
 CLIVE, UTAH

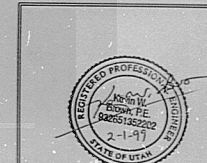

DATE AS NOTED 1/26/99
 DRAWING NO. 9903-04

9904140224

9904140224

PTR RIDS

* 9904060048

9904140224

