


5148 M 2001

GROUP 1
FUEL CELL LOCATIONS

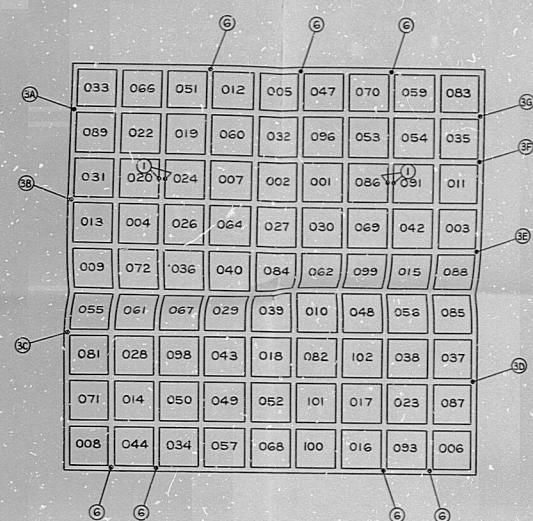


AS-BUILT CONDITIONS

- NCR 82-41 ① ITEM IS ADAPTER BARS DELETED AT THE 4 LOCATIONS MARKED.
- NCR 82-45 ② CELLS SHOWN EXCEED PLUMBNESS TOLERANCE AS FOLLOWS:
*035 - .055 OVER TOLERANCE *083 - .055 OVER TOLERANCE
*033 - .025 OVER TOLERANCE
- NCR 82-53 ③ ACTUAL LENGTHS OF 3.0 DIM. (ZONE E-6, SHT. 1) FOR NOTED LOCATIONS ARE AS FOLLOWS:
A - 2.700 B - 2.950 C - 2.920 D - 2.845
E - 2.790 F - 2.900 G - 2.910
- NCR 82-54 ④ FUEL CELL INSIDE DIMENSION (7.00±.03) IS OVERSIZE IN ONE DIRECTION TO THE DEPTHS SHOWN BELOW:
- | CELL # | ACT. DIM. | DEPTH | CELL # | ACT. DIM. | DEPTH | CELL # | ACT. DIM. | DEPTH |
|--------|-----------|-------|--------|-----------|-------|--------|-----------|-------|
| 066 | 7.055 | 8" | 042 | 7.060 | 9" | 043 | 7.040 | 5" |
| 047 | 7.060 | 16" | 003 | 7.065 | 10" | 018 | 7.075 | 10" |
| 070 | 7.050 | 12" | 038 | 7.060 | 18" | 102 | 7.055 | 9" |
| 089 | 7.080 | 23" | 040 | 7.060 | 12" | 038 | 7.070 | 10" |
| 060 | 7.055 | 23" | 084 | 7.075 | 9" | 037 | 7.065 | 10" |
| 096 | 7.055 | 9" | 062 | 7.080 | 10" | 014 | 7.060 | 13" |
| 054 | 7.060 | 16" | 099 | 7.090 | 9" | 049 | 7.090 | 23" |
| 035 | 7.060 | 8" | 061 | 7.060 | 9" | 052 | 7.100 | 9" |
| 031 | 7.090 | 10" | 067 | 7.065 | 21" | 101 | 7.065 | 18" |
| 091 | 7.058 | 18" | 029 | 7.075 | 13" | 017 | 7.055 | 10" |
| 011 | 7.060 | 9" | 039 | 7.090 | 14" | 023 | 7.060 | 12" |
| 004 | 7.045 | 21" | 010 | 7.105 | 10" | 087 | 7.045 | 17" |
| 026 | 7.070 | 11" | 048 | 7.095 | 11" | 100 | 7.050 | 14" |
| 027 | 7.050 | 14" | 056 | 7.090 | 10" | 016 | 7.055 | 12" |
| 030 | 7.055 | 9" | 085 | 7.055 | 16" | 057 | 7.045 | 10" |
| 069 | 7.055 | 10" | 028 | 7.050 | 13" | | | |
- ADDITIONAL CELLS THAT EXCEED THE 7.03 DIMENSION IN ONE DIRECTION ARE SHOWN BELOW:
- | CELL # | ACT. DIM. | CELL # | ACT. DIM. | CELL # | ACT. DIM. |
|--------|-----------|--------|-----------|--------|-----------|
| *033 | *051 | *012 | *005 | *059 | *083 |
| *053 | *007 | *002 | *086 | *091 | *064 |
| *072 | *060 | *037 | *015 | *082 | *050 |
| *008 | *044 | *034 | *068 | *055 | *006 |
- NCR 82-55 ⑤ CELL PITCH 9.00±.06 IS EXCEEDED AS FOLLOWS:
- | CELL TO CELL | ACT. DIM. | CELL TO CELL | ACT. DIM. |
|--------------|-----------|--------------|-----------|
| 033 - 089 | 8.933 | 059 - 054 | 8.920 |
| 066 - 022 | 8.927 | 083 - 035 | 8.909 |
| 051 - 019 | 8.921 | 096 - 001 | 8.935 |
| 012 - 060 | 8.937 | 053 - 086 | 8.932 |
| 012 - 005 | 8.934 | 020 - 024 | 8.972 |
| 005 - 032 | 8.902 | 099 - 015 | 8.915 |
| 070 - 053 | 8.930 | 067 - 029 | 8.932 |
- NCR 82-64 ⑥ AT LOCATIONS SHOWN, TOLERANCE ON 4.0±.1 DIM. (ZONE E-6, SHT. 1) IS INCREASED TO ±.2

*SEE NCR 82-61 - THIS VALUE DID NOT CHANGE


GROUP 2
FUEL CELL LOCATIONS

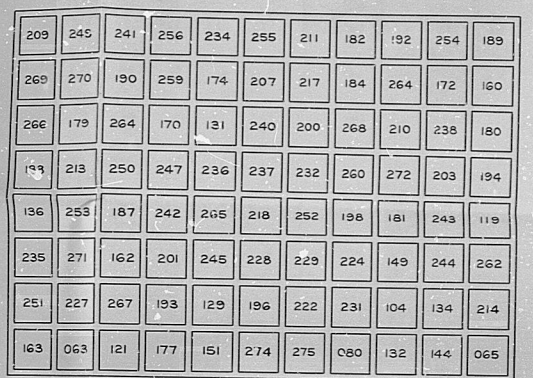

AS-BUILT CONDITIONS

- NCR 82-13 ① FUEL CELL DIMENSION (7.00±.03) IS OVERSIZE IN ONE DIRECTION AT DISTANCES DOWN FROM LEAD-IN ON THE FOLLOWING CELLS:
- | CELL # | ACT. DIM. | DIST. DN. FR. LEAD-IN | CELL # | ACT. DIM. | DIST. DN. FR. LEAD-IN |
|--------|-----------|-----------------------|--------|-----------|-----------------------|
| 063 | 7.037 | 8.00 | 151 | 7.041 | 6.00 |
| 065 | 7.042 | 8.00 | 144 | 7.049 | 7.00 |
| 132 | 7.051 | 7.00 | 163 | 7.049 | 5.00 |
| 121 | 7.050 | 7.62 | 177 | 7.038 | 9.00 |
- NCR 82-39 ② IN ADDITION THE FOLLOWING CELLS ARE OVERSIZE BUT NONE EXCEED THE 7.05 DIM. SPECIFIED FOR *132:
- | CELL # | ACT. DIM. | CELL # | ACT. DIM. | CELL # | ACT. DIM. |
|--------|-----------|--------|-----------|--------|-----------|
| *131 | *136 | *149 | *162 | *170 | *180 |
| *187 | *200 | *201 | *203 | *210 | *213 |
| *228 | *232 | *235 | *236 | *237 | *238 |
| *244 | *245 | *247 | *250 | *251 | *252 |
| *262 | *264 | *265 | *266 | *267 | *272 |
- NCR 82-27 ③ FUEL CELL DIMENSION (7.00±.03) IS UNDERSIZE IN ONE DIRECTION ON THE FOLLOWING CELLS:
- | CELL # | ACT. DIM. | CELL # | ACT. DIM. |
|--------|-----------|--------|-----------|
| 214 | 6.960 | 169 | 6.940 |
- NCR 82-58 ④ TOLERANCE INCREASED ON 5.0±.1 DIA. (ZONE D-1, SHT. 1) TO ±.1 (NOTE: 6 CELLS ONLY AFFECTED)
- NCR 82-71 ⑤ CELL PITCH 9.00±.06 MEASURES 8.875 AT FOUR LOCATIONS ONLY. (LOCATIONS NOT CLEARLY SPECIFIED ON NCR)
- NCR 82-103 AM ⑥ 1/8" CAN SEAM WELD (ZONE D-1, SHT. 1) ARE UNDERSIZE ON THE FOLLOWING CELLS:
- | CELL # | ACT. DIM. | CELL # | ACT. DIM. | CELL # | ACT. DIM. |
|--------|-----------|--------|-----------|--------|-----------|
| *119 | *129 | *136 | *149 | *160 | *162 |
| *180 | *181 | *183 | *184 | *187 | *189 |
| *194 | *196 | *197 | *198 | *200 | *201 |
| *210 | *211 | *213 | *217 | *218 | *222 |
| *229 | *231 | *232 | *234 | *235 | *236 |
| *241 | *242 | *243 | *244 | *245 | *246 |
| *251 | *252 | *253 | *254 | *255 | *256 |
| *264 | *265 | *266 | *267 | *268 | *269 |
| *121 | *063 | *177 | *151 | *132 | *163 |
| *134 | *214 | *169 | | | |
- NOTE: WORST CASE IS 3/32" WELD ON CELL *234.
- NCR 82-114 ⑦ CELL TO CELL PITCH (9.00±.06 INDIVIDUAL & ±.120 ACCUMULATIVE) IS EXCEED AS FOLLOWS:
- | CELL TO CELL | ACT. DIM. | CELL TO CELL | ACT. DIM. | | |
|--------------|-----------|--------------|-----------|-----|-------|
| 269 | 209 | 8.916 | 172 | 254 | 8.935 |
| 270 | 249 | 8.935 | 160 | 189 | 8.929 |
| 207 | 255 | 8.930 | 247 | 170 | 8.935 |
| 217 | 211 | 8.929 | 260 | 268 | 8.931 |
| 184 | 182 | 8.933 | 189 | 065 | 8.966 |
| 183 | 194 | 8.965 | 136 | 119 | 8.957 |

GROUP 3
FUEL CELL LOCATIONS

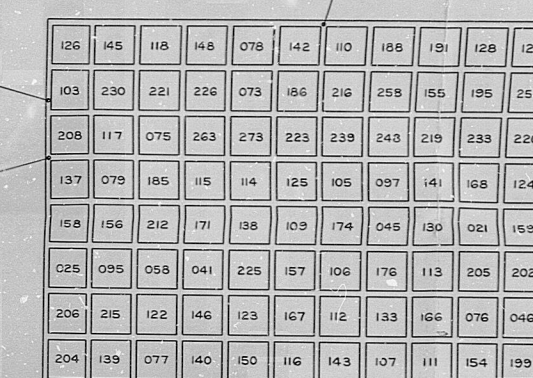

AS-BUILT CONDITIONS

- NCR 82-33 ① FUEL CELL DIMENSION (7.00±.03) IS OVERSIZE ON CELL *176. ACTUAL DIMENSION IS 7.050
- NCR 82-100 ② ADDITIONAL CELLS THAT EXCEED THE 7.03 DIMENSION ARE SHOWN BELOW:
- | CELL # | ACT. DIM. | CELL # | ACT. DIM. | CELL # | ACT. DIM. |
|--------|-----------|--------|-----------|--------|-----------|
| *046 | *074 | *076 | *077 | *090 | *092 |
| *106 | *107 | *111 | *112 | *113 | *116 |
| *119 | *122 | *123 | *130 | *139 | *140 |
| *143 | *146 | *150 | *154 | *157 | *161 |
| *164 | *167 | *169 | *199 | *202 | *204 |
| *205 | *206 | *223 | | | |
- NCR 82-43 ③ THE 4.00±.06 DIM. (ZONE E-7, SHT. 2) IS OUT OF TOLERANCE AT LOCATIONS SHOWN. ACTUAL DIMENSIONS ARE A. 3.937 B. 4.080 C. 4.080
- NCR 82-92 ④ FUEL CELL DIMENSION (7.00±.03) IS OVERSIZE ON THE FOLLOWING CELLS:
- | CELL # | ACT. DIM. | CELL # | ACT. DIM. | CELL # | ACT. DIM. |
|--------|--|--------|--|--------|--|
| *078 | OVERSIZE 7.051 FROM TOP 11" DOWN TO 7.030 | *142 | OVERSIZE 7.051 FROM TOP 3 1/2" DOWN TO 7.030 | *145 | OVERSIZE 7.051 FROM TOP 1 1/2" DOWN TO 7.030 |
| *147 | OVERSIZE 7.051 FROM TOP 1 1/2" DOWN TO 7.030 | *148 | OVERSIZE 7.051 FROM TOP 4" DOWN TO 7.030 | *149 | OVERSIZE 7.051 FROM TOP 2 1/2" DOWN TO 7.030 |
- NCR 82-93 ⑤ CELL TO CELL PITCH (9.00±.06 INDIVIDUAL & ±.120 ACCUMULATIVE) IS EXCEEDED AS FOLLOWS:
- | CELL TO CELL | ACT. DIM. | CELL TO CELL | ACT. DIM. | | |
|--------------|-----------|--------------|-----------|-----|---------|
| 078 | 142 | 9.084 | 208 | 103 | 8.935 |
| 147 | 090 | 6.2973 | 137 | 108 | 10.7660 |
- NCR 82-106 ⑥ 1/8" CAN SEAM WELD (ZONE D-1, SHT. 1) ARE UNDERSIZE ON THE FOLLOWING CELLS:
- | CELL # | ACT. DIM. | CELL # | ACT. DIM. | CELL # | ACT. DIM. |
|--------|-----------|--------|-----------|--------|-----------|
| *021 | *025 | *041 | *045 | *046 | *056 |
| *073 | *074 | *075 | *076 | *077 | *078 |
| *079 | *080 | *081 | *082 | *083 | *084 |
| *085 | *086 | *087 | *088 | *089 | *090 |
| *091 | *092 | *093 | *094 | *095 | *096 |
| *097 | *098 | *099 | *100 | *101 | *102 |
| *103 | *104 | *105 | *106 | *107 | *108 |
| *109 | *110 | *111 | *112 | *113 | *114 |
| *115 | *116 | *117 | *118 | *119 | *120 |
| *122 | *123 | *124 | *125 | *126 | *127 |
| *128 | *129 | *130 | *131 | *132 | *133 |
| *135 | *136 | *137 | *138 | *139 | *140 |
| *141 | *142 | *143 | *144 | *145 | *146 |
| *148 | *149 | *150 | *151 | *152 | *153 |
| *154 | *155 | *156 | *157 | *158 | *159 |
| *161 | *162 | *163 | *164 | *165 | *166 |
| *168 | *169 | *170 | *171 | *172 | *173 |
| *175 | *176 | *177 | *178 | *179 | *180 |
| *183 | *184 | *185 | *186 | *187 | *188 |
| *191 | *192 | *193 | *194 | *195 | *196 |
| *199 | *200 | *201 | *202 | *203 | *204 |
| *206 | *207 | *208 | *209 | *210 | *211 |
| *213 | *214 | *215 | *216 | *217 | *218 |
| *220 | *221 | *222 | *223 | *224 | *225 |
| *228 | *229 | *230 | *231 | *232 | *233 |
| *235 | *236 | *237 | *238 | *239 | *240 |
| *243 | *244 | *245 | *246 | *247 | *248 |
| *251 | *252 | *253 | *254 | *255 | *256 |
| *867 | *868 | *869 | *870 | *871 | *872 |
| *8 | | | | | |

9904140309

PDR RIDS

* 9904080072

9904140309

