



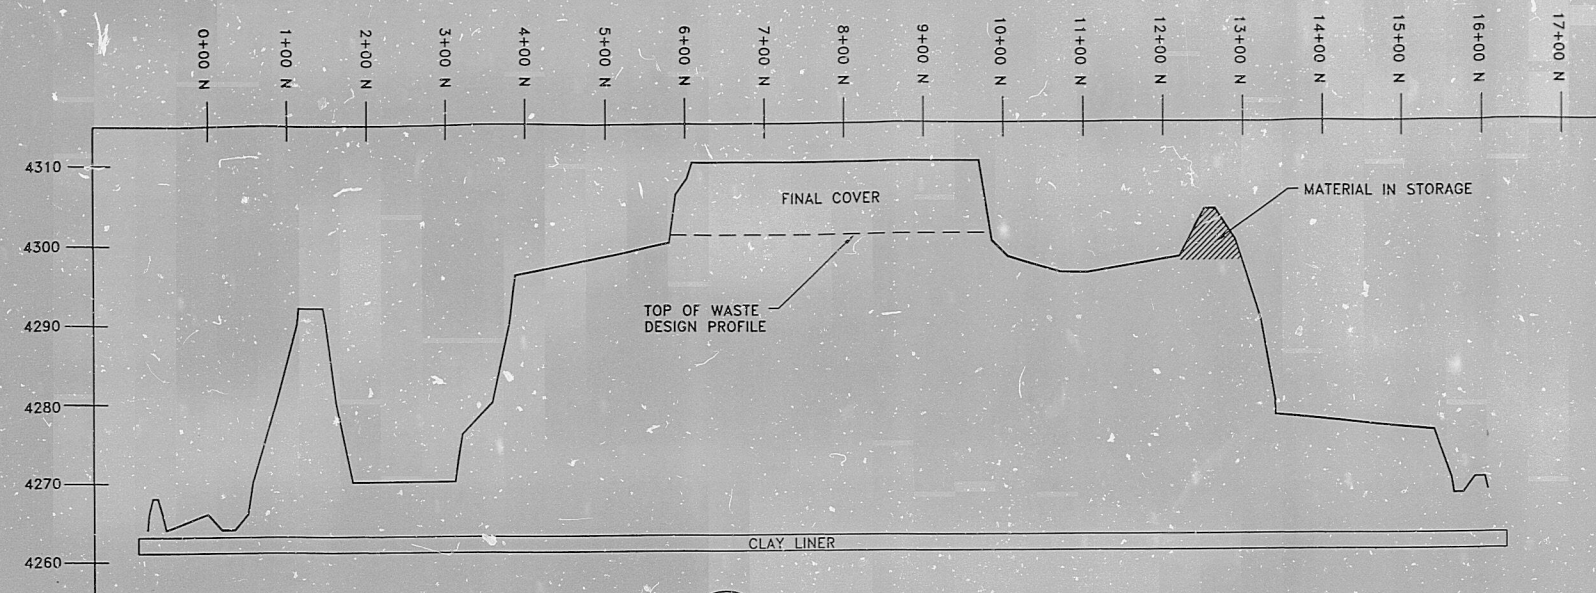

D-D 19+50 E CROSS SECTION
 9903-05
 HORIZONTAL SCALE: 1" = 100'
 VERTICAL SCALE: 1" = 10'

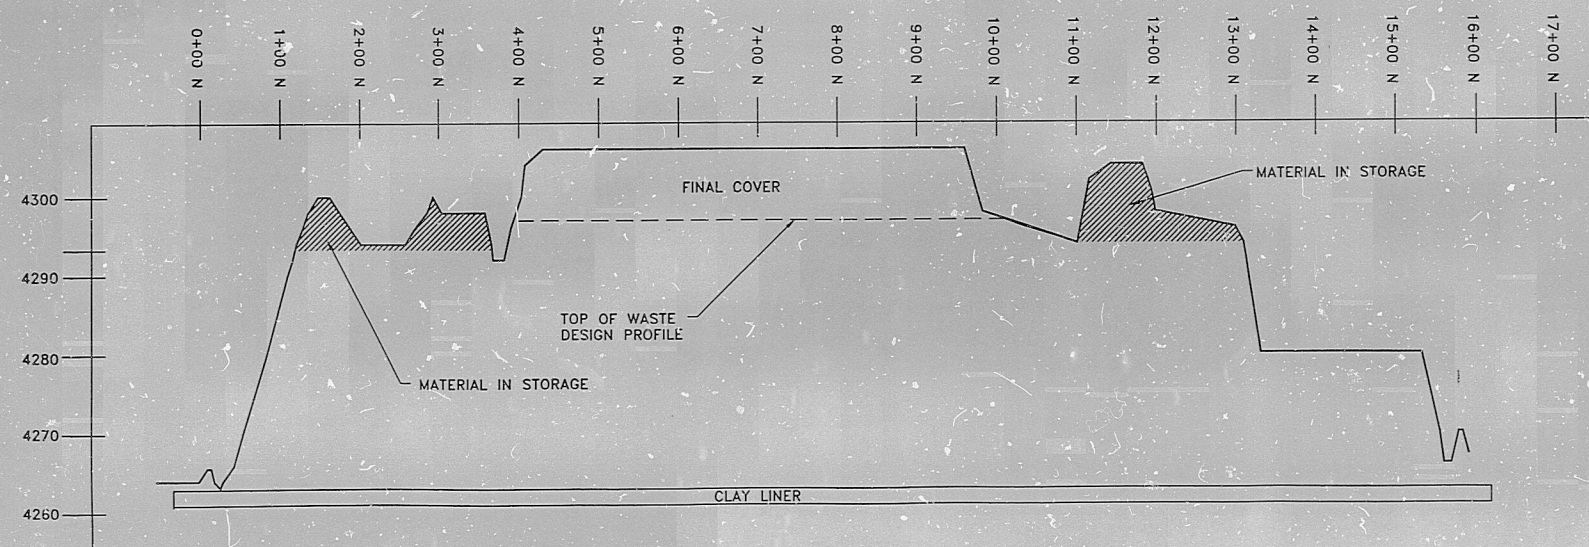

E-E 20+50 E CROSS SECTION
 9903-05
 HORIZONTAL SCALE: 1" = 100'
 VERTICAL SCALE: 1" = 10'

9906010023

APERTURE CARD



DATE	BY	DESCRIPTION OF CHANGE
04/16/99	JSW	DRAWING ERROR CORRECTION



ENVIROCARE
OF UTAH, INC.
 "THE SAFE ALTERNATIVE"

DESIGNED BY
 J. WEST
 CHECKED BY
 D. COMSTOCK
 DRAWN BY

11e(2) DISPOSAL CELL
 AS-BUILT DRAWINGS
 CROSS SECTIONS
 CLIVE, UTAH

SCALE AS NOTED
 DATE 1/26/99
 DRAWING NO. 9903-05

9906010023

9906010023

FDR RIDS

9906010023

