


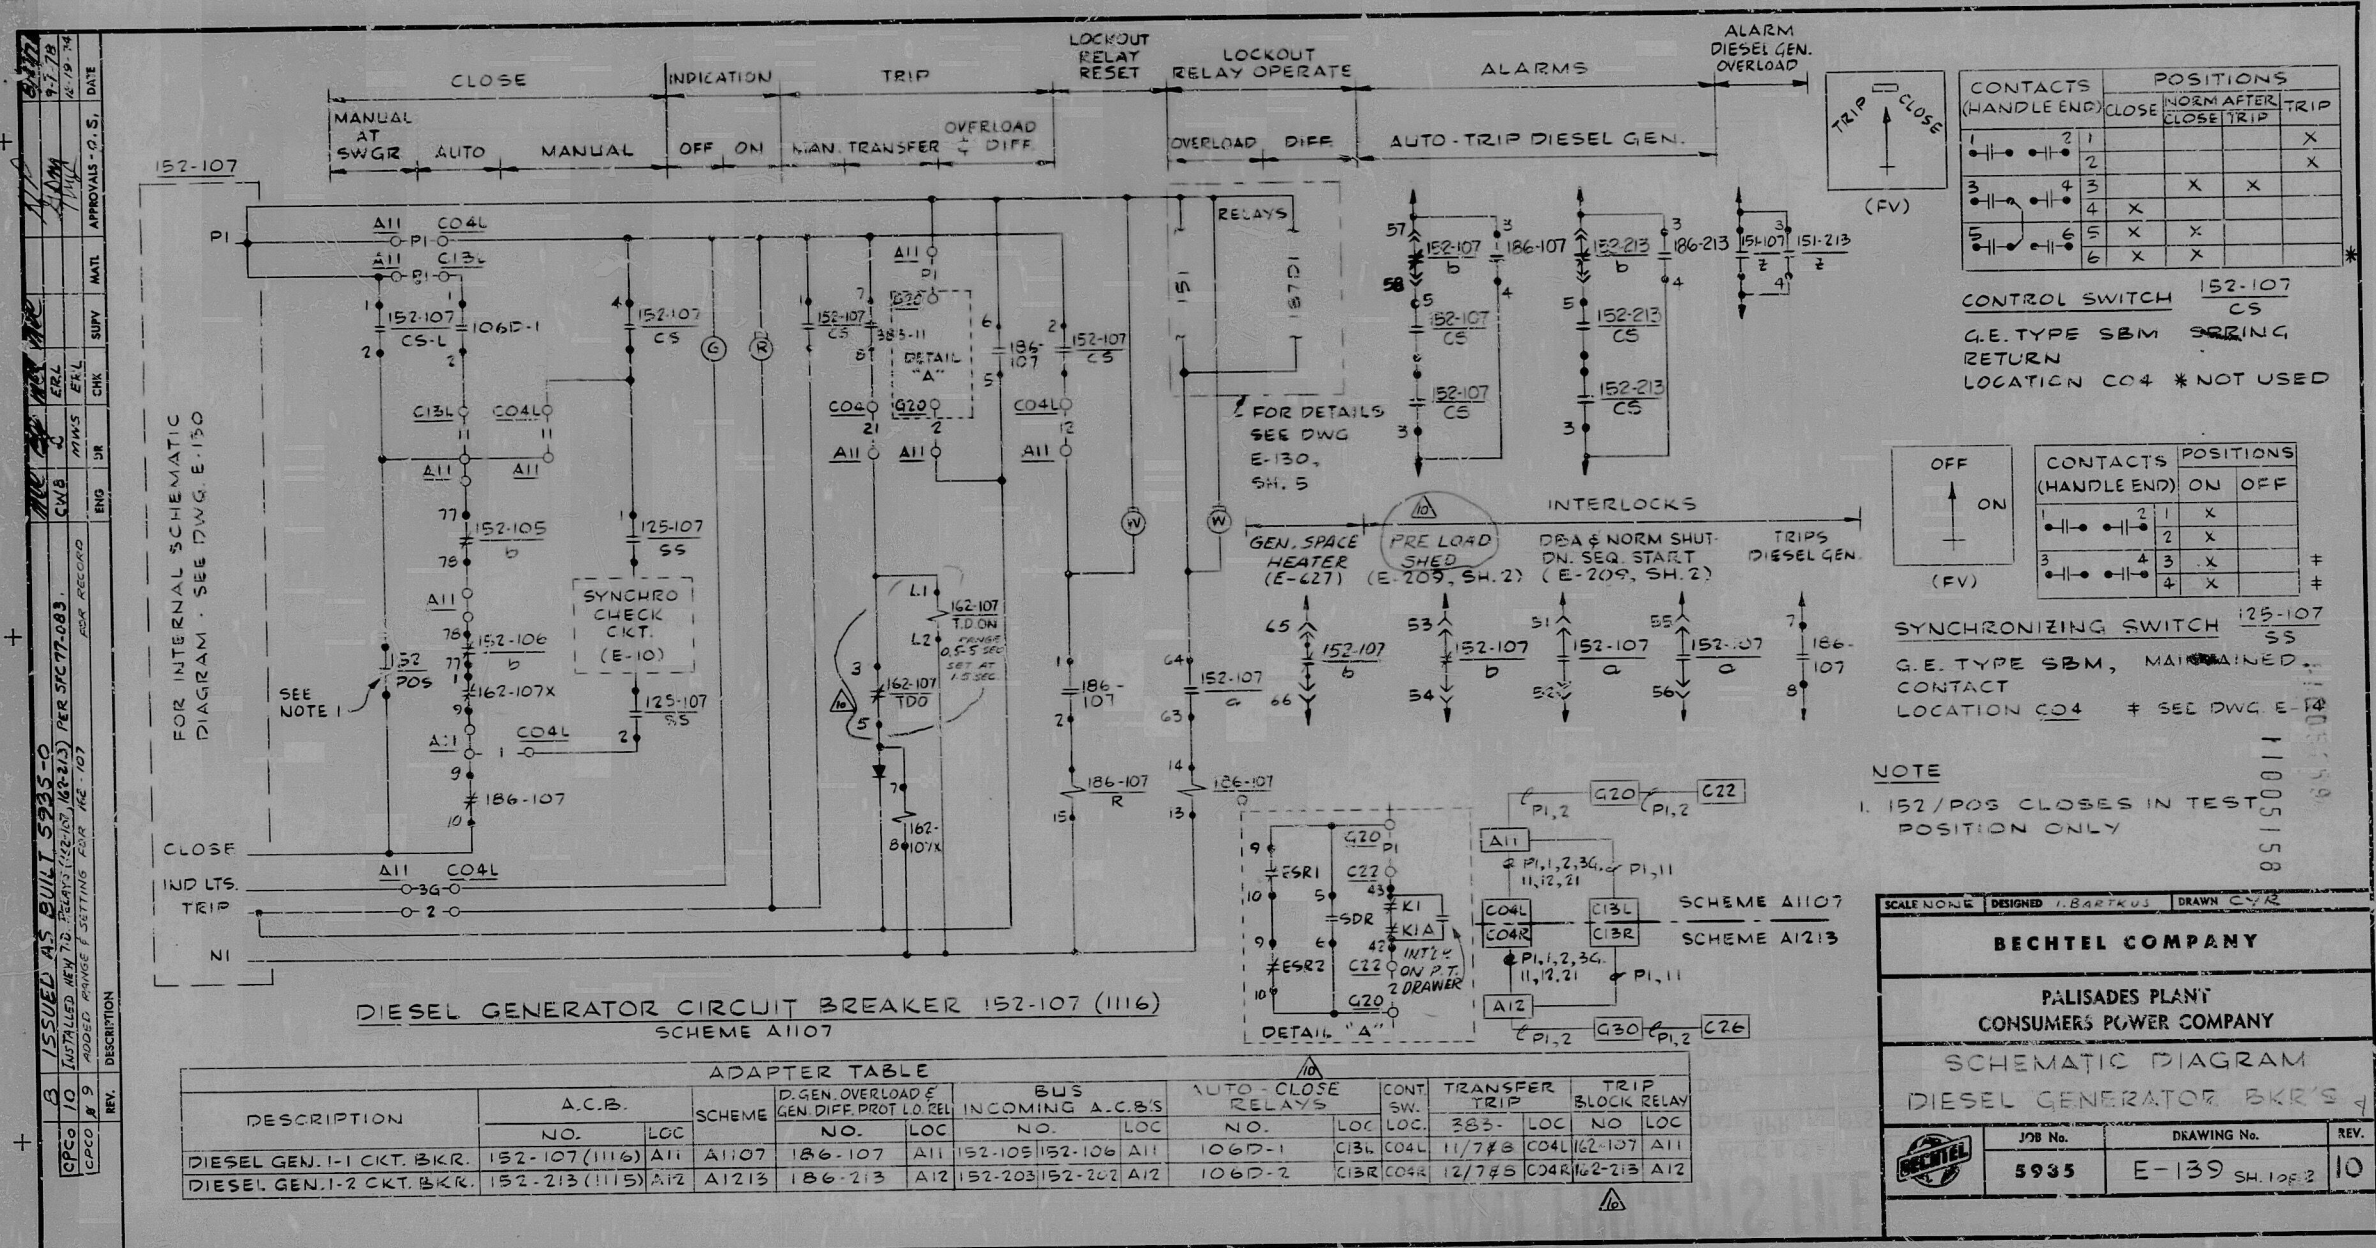

REV.	DESCRIPTION	DATE
1	ISSUED AS BUILT 5935-0	9-7-79
2	INSTALLED NEW TO RELAYS (E-139) PER SFC 77-083	11-19-79
3	ADDED RANGE SETTING FOR ME-107	12-19-79

DESCRIPTION	A.C.B.		SCHEME	D. GEN. OVERLOAD & GEN. DIFF. PROT. LO. REL.		BUS INCOMING A.C.B.'S		AUTO CLOSE RELAYS		CONT. SW.	TRANSFER TRIP		TRIP BLOCK RELAY	
	NO.	LOC.		NO.	LOC.	NO.	LOC.	NO.	LOC.		NO.	LOC.	NO.	LOC.
DIESEL GEN. 1-1 CKT. BKR.	152-107 (1116)	A11	A1107	186-107	A11	152-105	152-106	A11	106D-1	C13L	CO4L	11/7#8	CO4L	162-107
DIESEL GEN. 1-2 CKT. BKR.	152-213 (1115)	A12	A1213	186-213	A12	152-203	152-202	A12	106D-2	C13R	CO4R	12/7#8	CO4R	162-213

CONTACTS (HANDLE END)		POSITIONS			
		CLOSE	NORM AFTER CLOSE	TRIP	
1	2			X	
3	4		X	X	
5	6	X	X		
7	8	X	X		

CONTROL SWITCH 152-107 CS
G.E. TYPE SBM, RETURN
LOCATION CO4 * NOT USED

CONTACTS (HANDLE END)		POSITIONS	
		ON	OFF
1	2	X	
3	4	X	
5	6	X	
7	8	X	

SYNCHRONIZING SWITCH 125-107 SS
G.E. TYPE SBM, MAIN
CONTACT LOCATION CO4 * SEE DWG. E-139

NOTE
1. 152/P03 CLOSING IN TEST POSITION ONLY

SCALE NONE DESIGNED I. BARTUS DRAWN C. Y. R.

BECHTEL COMPANY


PALISADES PLANT
CONSUMERS POWER COMPANY

SCHEMATIC DIAGRAM
DIESEL GENERATOR BKR'S

JOB No.	DRAWING No.	REV.
5935	E-139 SH. 1 OF 2	10


16X

9500					E 139100001										DIESEL GENERATOR BREAKERS										748																																		
PREFIX					CLASS					DWG NO					REV					SHEET					DRAWING TITLE					YR																													
PREFIX					CLASS					DWG NO					REV					SHEET					DRAWING TITLE					YR																													
1	2	3	4	5	6	7	8	9	10	11	12	13	14	15	16	17	18	19	20	21	22	23	24	25	26	27	28	29	30	31	32	33	34	35	36	37	38	39	40	41	42	43	44	45	46	47	48	49	50	51	52	53	54	55	56	57	58	59	60
1	2	3	4	5	6	7	8	9	10	11	12	13	14	15	16	17	18	19	20	21	22	23	24	25	26	27	28	29	30	31	32	33	34	35	36	37	38	39	40	41	42	43	44	45	46	47	48	49	50	51	52	53	54	55	56	57	58	59	60

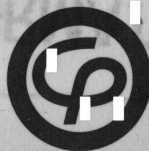

Consumers
Power
Company

INFORMATION COPY

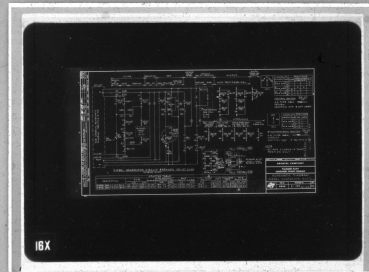

**PRODUCTION & TRANSMISSION
ENGINEERING TRACINGS**

8101130489