


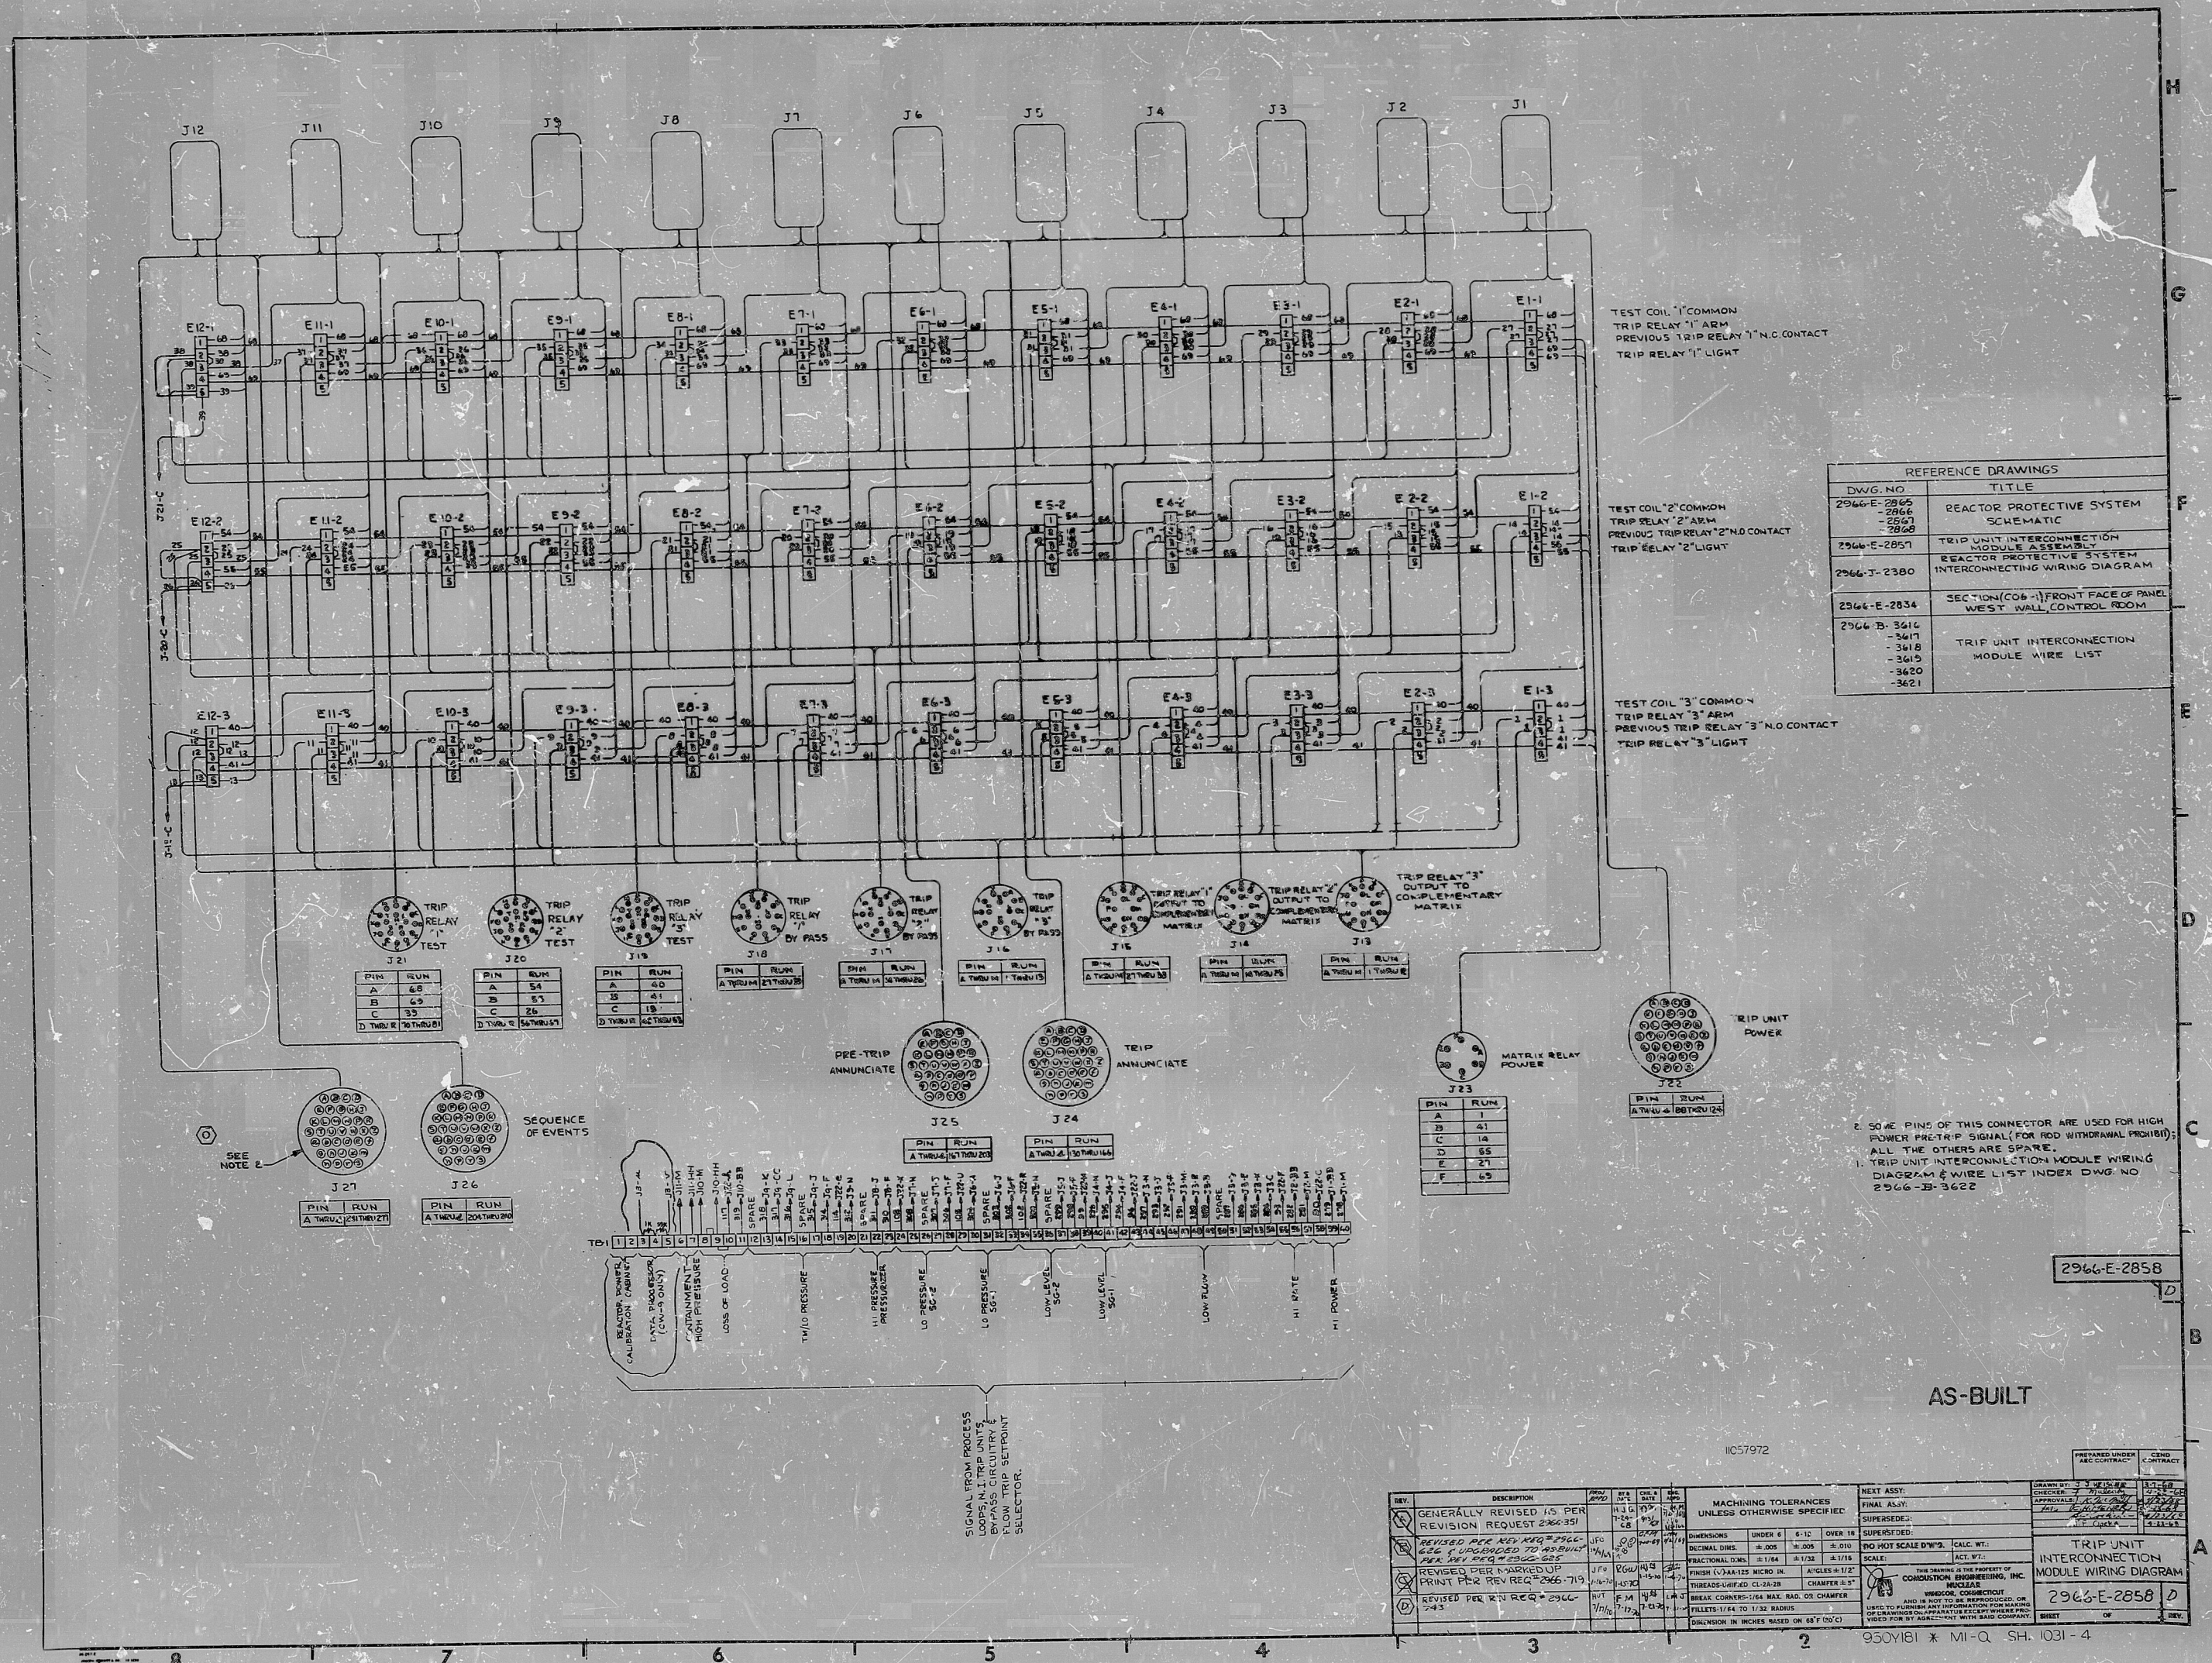

REFERENCE DRAWINGS	
DWG. NO.	TITLE
2966-E-2865	REACTOR PROTECTIVE SYSTEM
-2866	SCHEMATIC
-2867	TRIP UNIT INTERCONNECTION
2966-E-2857	MODULE ASSEMBLY
2966-J-2380	REACTOR PROTECTIVE SYSTEM
	INTERCONNECTING WIRING DIAGRAM
2966-E-2834	SECTION (C08-1) FRONT FACE OF PANEL
	WEST WALL CONTROL ROOM
2966-B-3616	TRIP UNIT INTERCONNECTION
-3617	MODULE WIRE LIST
-3618	
-3619	
-3620	
-3621	

TEST COIL "1" COMMON
TRIP RELAY "1" ARM
PREVIOUS TRIP RELAY "1" N.C. CONTACT
TRIP RELAY "1" LIGHT

TEST COIL "2" COMMON
TRIP RELAY "2" ARM
PREVIOUS TRIP RELAY "2" N.O. CONTACT
TRIP RELAY "2" LIGHT

TEST COIL "3" COMMON
TRIP RELAY "3" ARM
PREVIOUS TRIP RELAY "3" N.O. CONTACT
TRIP RELAY "3" LIGHT

2. SOME PINS OF THIS CONNECTOR ARE USED FOR HIGH POWER PRE-TRIP SIGNAL (FOR ROD WITHDRAWAL PROHIBIT); ALL THE OTHERS ARE SPARE.
1. TRIP UNIT INTERCONNECTION MODULE WIRING DIAGRAM & WIRE LIST INDEX DWG. NO. 2966-B-3622

AS-BUILT

REVISION		DESCRIPTION		DATE		BY		CHECKED		DATE	
1		GENERALLY REVISED AS PER REVISION REQUEST 2966-351		11/10/72		J.F.		J.F.		11/10/72	
2		REVISED PER REV REQ 2966-719		11/10/72		J.F.		J.F.		11/10/72	
3		REVISED PER REV REQ 2966-719		11/10/72		J.F.		J.F.		11/10/72	
4		REVISED PER REV REQ 2966-719		11/10/72		J.F.		J.F.		11/10/72	

MACHINING TOLERANCES UNLESS OTHERWISE SPECIFIED		DIMENSIONS		TOLERANCES		FINISH		THREADS		HOLE DRILLING	
UNDER 1/8"	±.005	1/8" - 1/2"	±.010	OVER 1/2"	±.015	1/8" - 1/2"	±.010	OVER 1/2"	±.015	1/8" - 1/2"	±.010
1/8" - 1/2"	±.005	1/2" - 1"	±.010	OVER 1"	±.015	1/8" - 1/2"	±.010	OVER 1/2"	±.015	1/8" - 1/2"	±.010
1/8" - 1/2"	±.005	1/2" - 1"	±.010	OVER 1"	±.015	1/8" - 1/2"	±.010	OVER 1/2"	±.015	1/8" - 1/2"	±.010


NEXT ASSY.		FINAL ASSY.		SUPERSEDED		SUPERSEDED		SCALE		ACT. WT.	
NO HOT SCALE DWG.		NO HOT SCALE DWG.		NO HOT SCALE DWG.		NO HOT SCALE DWG.		NO HOT SCALE DWG.		NO HOT SCALE DWG.	

DRAWN BY		CHECKED BY		DATE		DATE	
J.F.		J.F.		11/10/72		11/10/72	

TRIP UNIT INTERCONNECTION MODULE WIRING DIAGRAM		2966-E-2858		D	
2966-E-2858		2966-E-2858		2966-E-2858	

0950Y 01811031

2966E2858 4TRIP UNIT INTERCM1Q

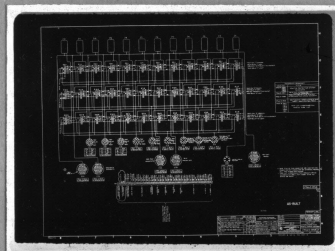

8101130647