


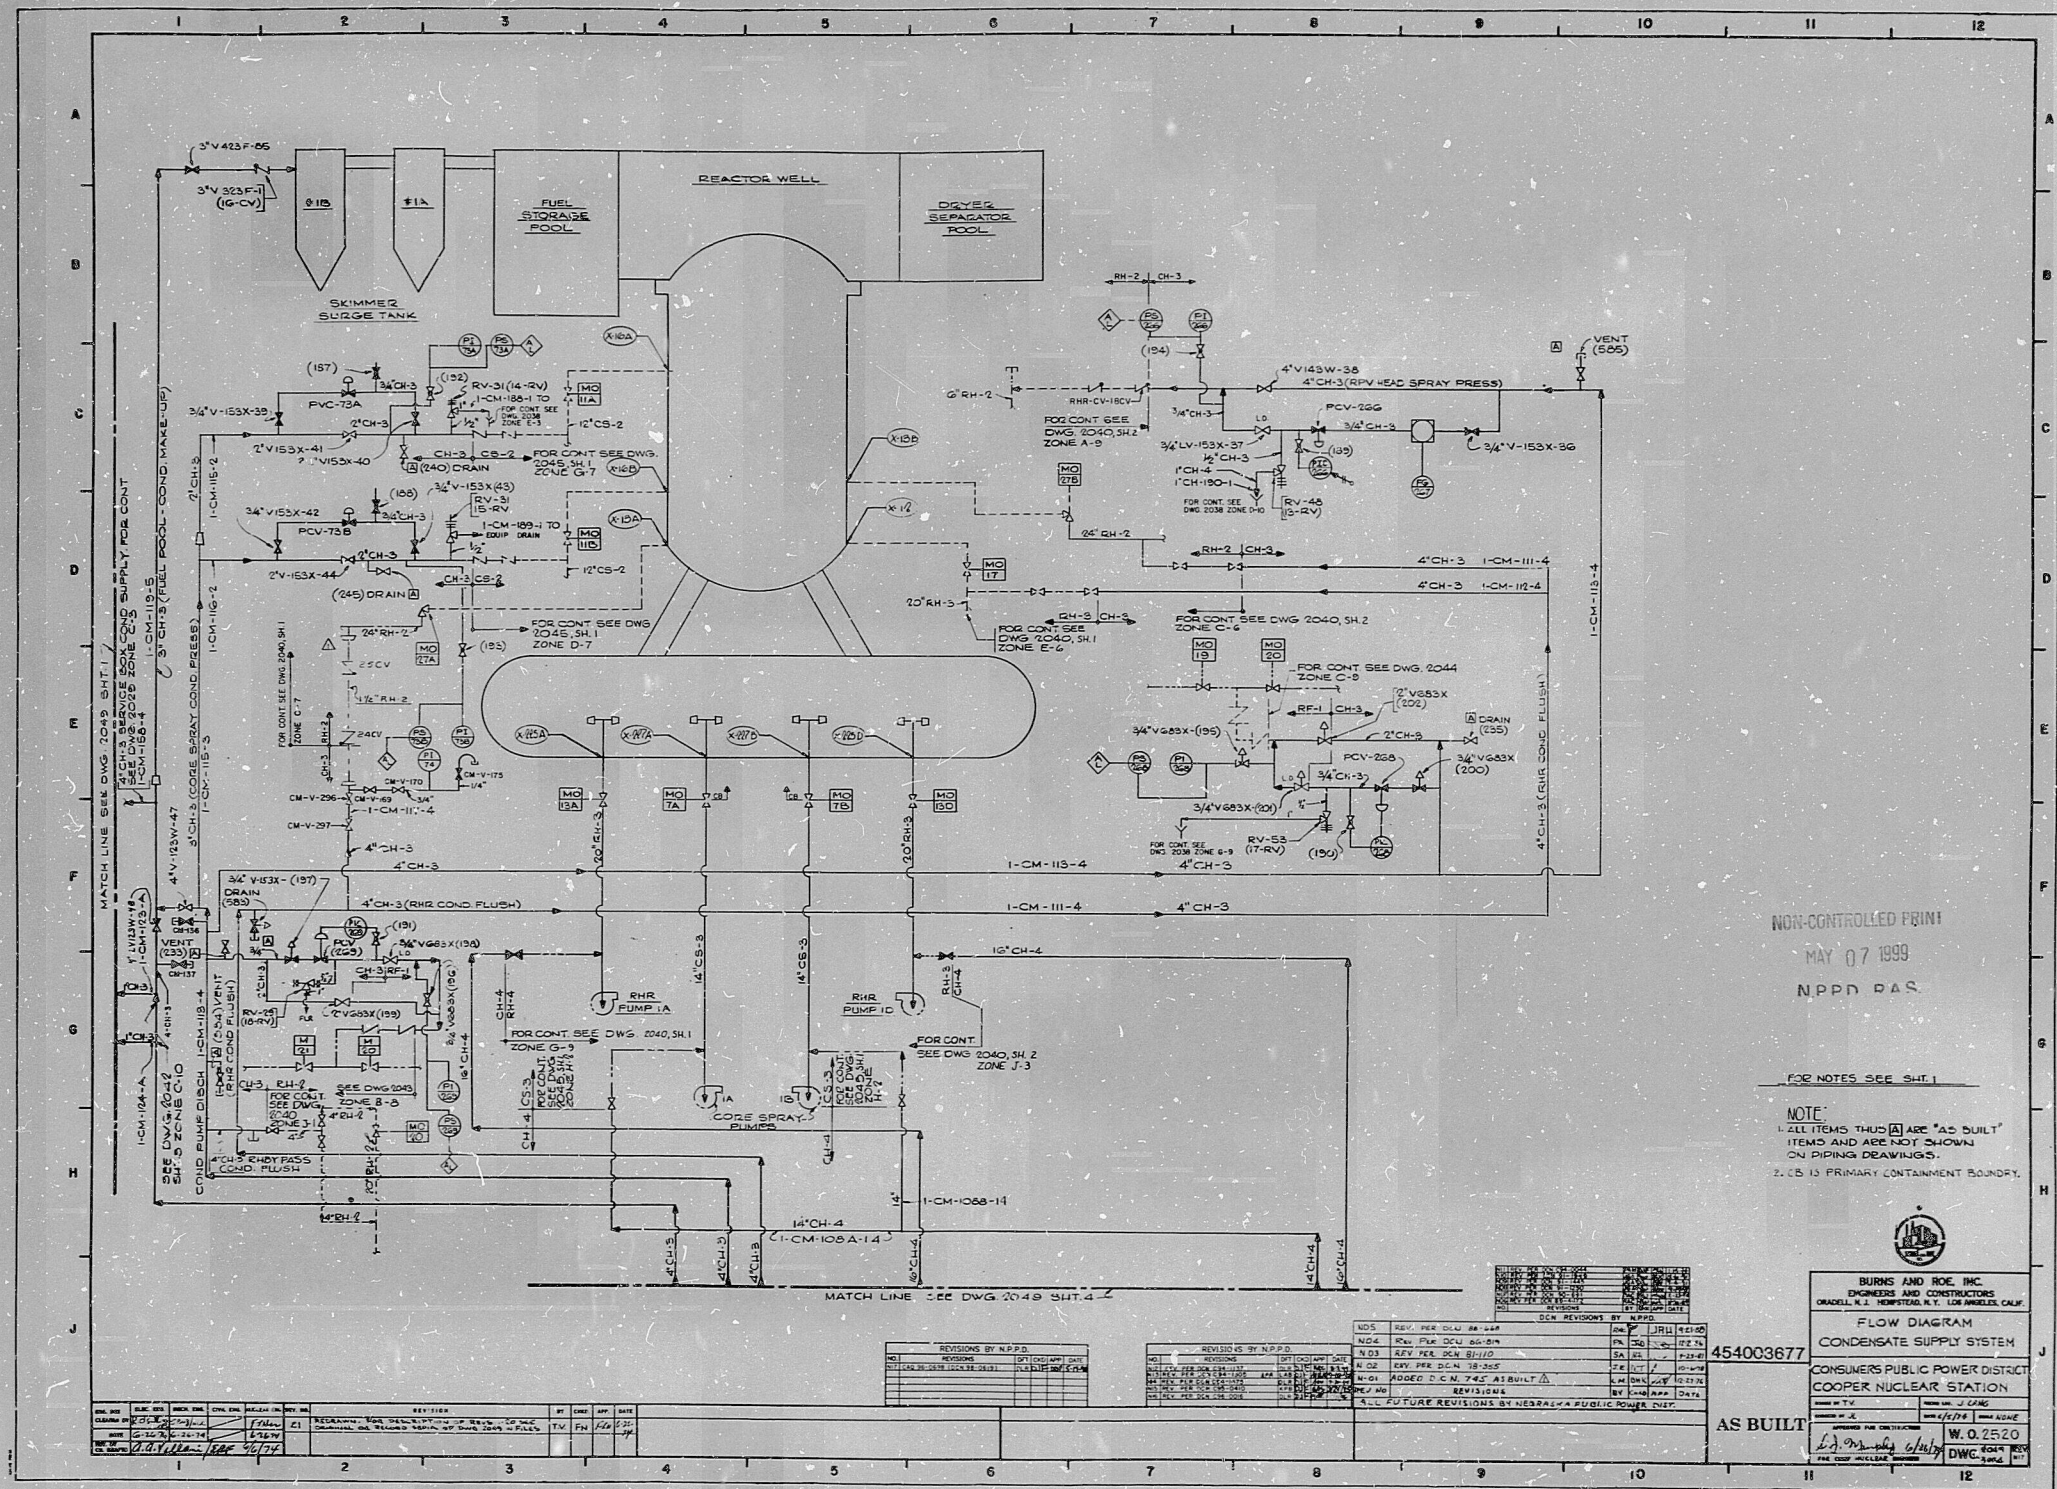

NON-CONTROLLED PRINT
MAY 07 1999
NPPD PAS

FOR NOTES SEE SHEET 1

NOTE:
1. ALL ITEMS THUS [X] ARE "AS BUILT"
ITEMS AND ARE NOT SHOWN
ON PIPING DRAWINGS.
2. CS IS PRIMARY CONTAINMENT BOUNDARY.

BURNS AND ROE, INC.
ENGINEERS AND CONSTRUCTORS
ORADLE, N.J. NEWPORT, N.Y. LOS ANGELES, CALIF.

**FLOW DIAGRAM
CONDENSATE SUPPLY SYSTEM**

**CONSOLIDATED PUBLIC POWER DISTRICT
COOPER NUCLEAR STATION**

454003677

AS BUILT

W. O. 2520
DWG. NO. 2520

MAY 20, 1993 NPPD

☐ DRAWING SUBJECT TO REVISION
TER
☐ DRAWING BEING REVISED PER
DCW# 99-0223

APERTURE CAPD

9907080320

PDR RIDS

9907080320

