


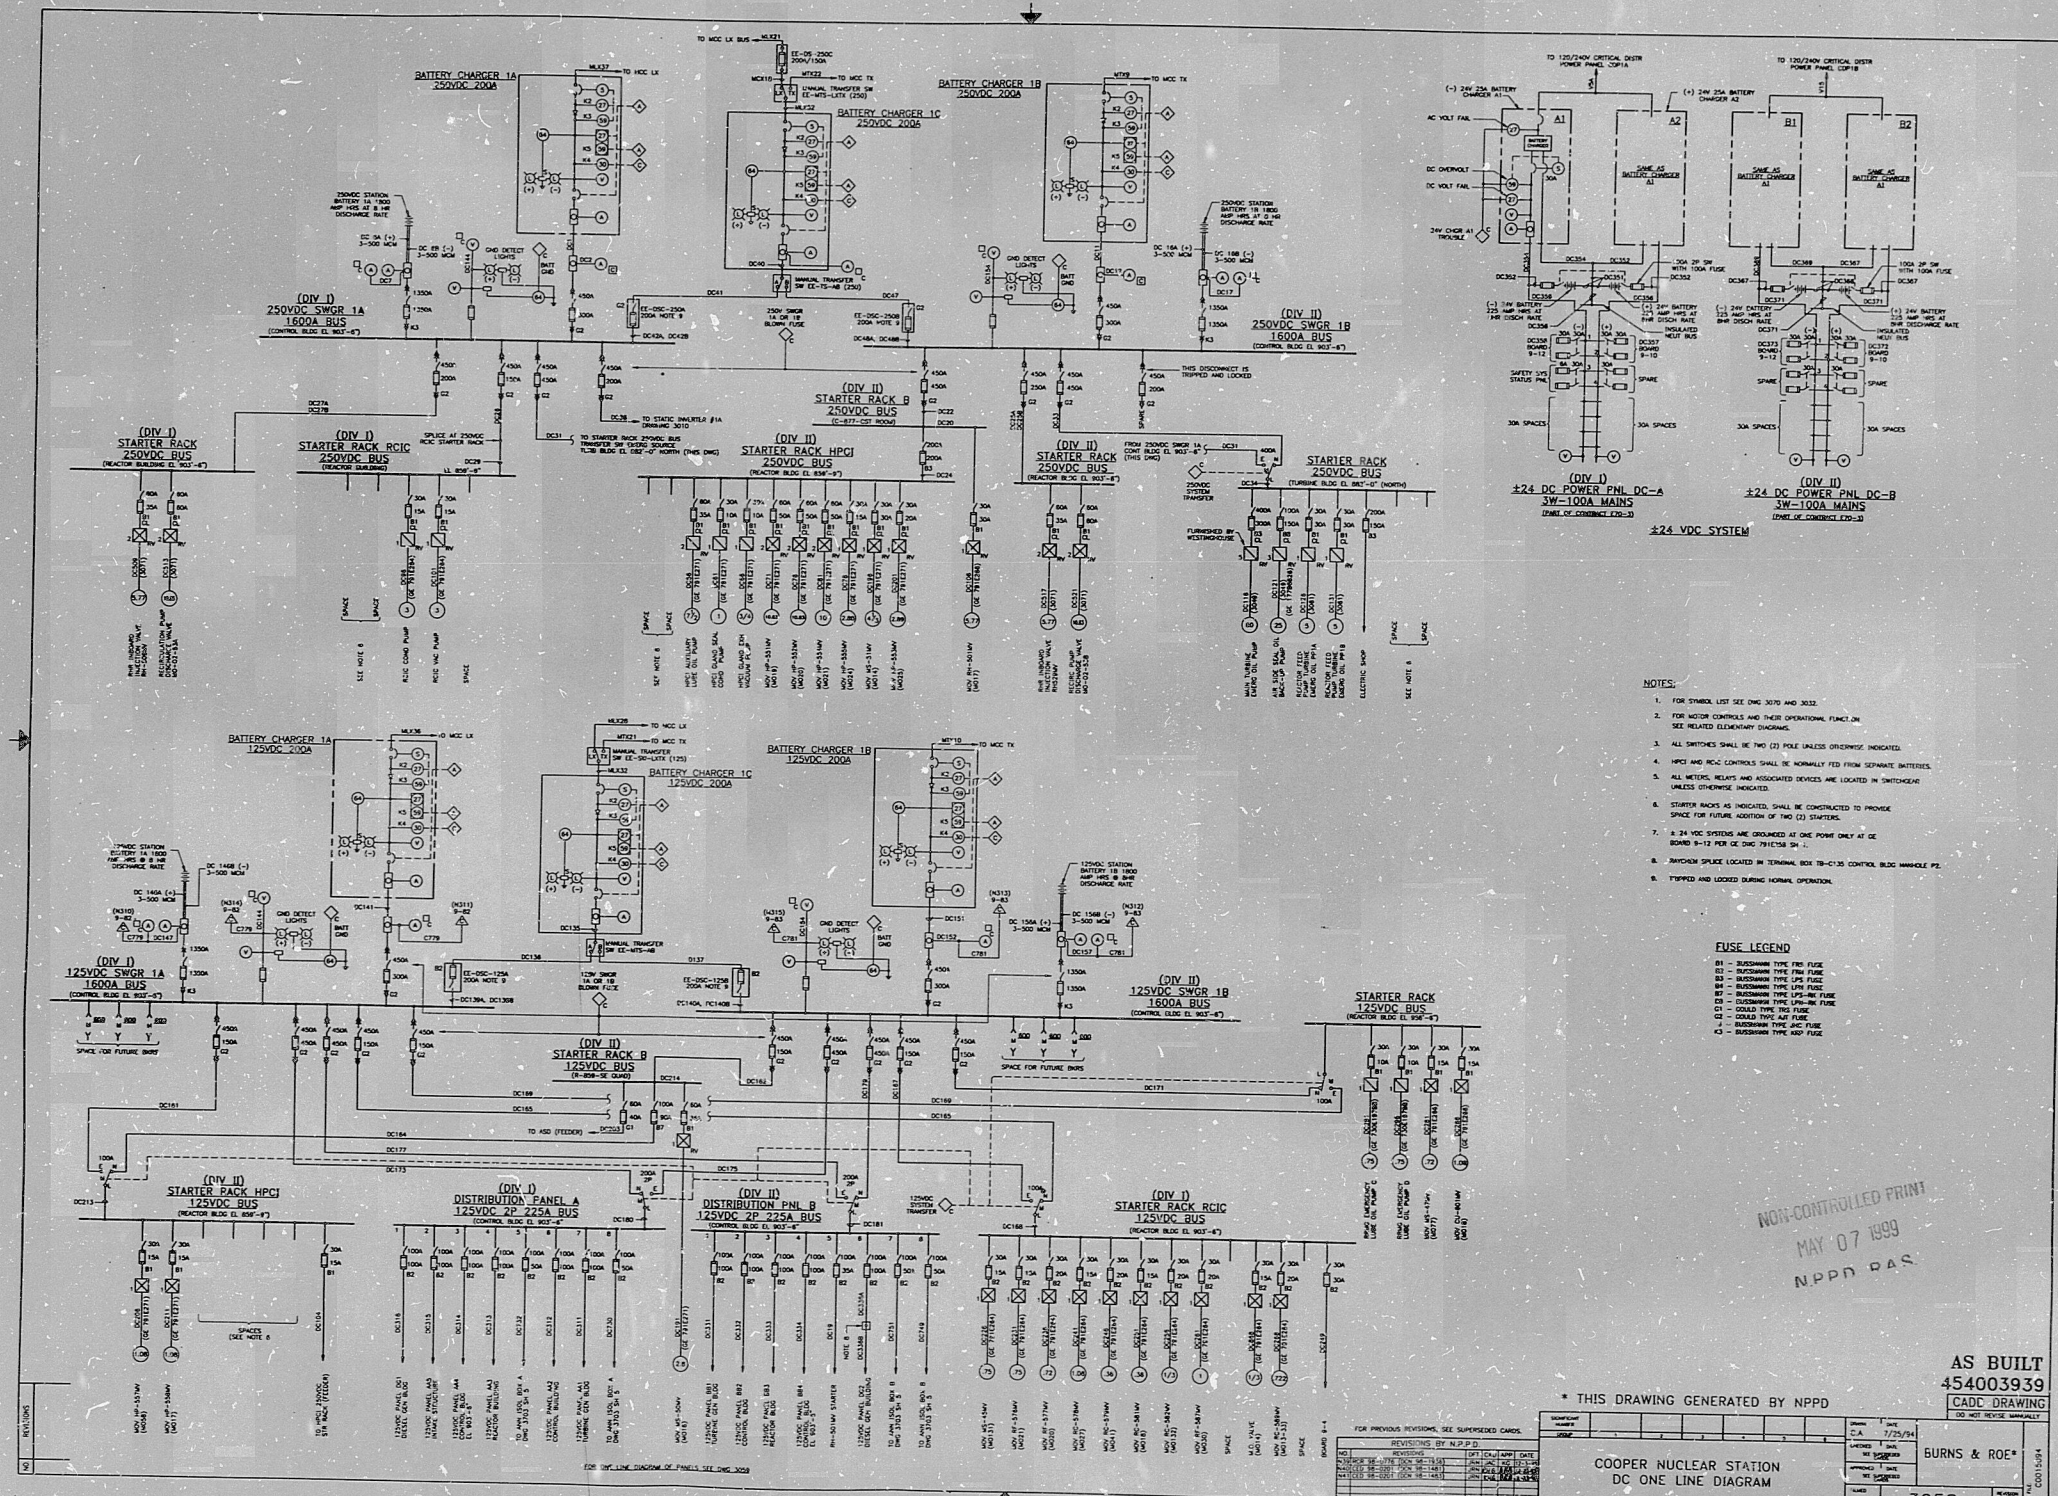

- NOTES:
1. FOR SYMBOLS LIST SEE ONE SHEET AND 3002.
 2. FOR MOTOR CONTROLS AND THEIR OPERATIONAL FUNCTIONS SEE RELATED ELEMENTARY DRAWINGS.
 3. ALL SWITCHES SHALL BE TWO (2) POLE UNLESS OTHERWISE INDICATED.
 4. SPACED AND HOLD CONTROLS SHALL BE NORMALLY PREFERRED UNLESS OTHERWISE INDICATED.
 5. ALL METERS, RELAYS AND ASSOCIATED DEVICES ARE LOCATED IN PARTITIONED UNLESS OTHERWISE INDICATED.
 6. STARTER RACKS AS INDICATED, SHALL BE CONSTRUCTED TO PROVIDE SPACE FOR FUTURE ADDITION OF TWO (2) STARTERS.
 7. A 24 VDC SYSTEMS ARE UNBUNDLED AT ONE POWER ONLY AT SEE BOARD 9-12 PER DC ONE SHEET 3002.
 8. SWITCHES SPACED LOCATED IN TERMINAL BOX 10-135 CONTROL BLOCK IMMEDIATE P2.
 9. TRIPPED AND LOCKED DURING NORMAL OPERATION.

- FUSE LEGEND
- BT - BUSHBROOK TYPE FUSE
 - BT - BUSHBROOK TYPE FUSE
NON-CONTROLLED PRINT
MAY 07 1999
NPPD PAS

AS BUILT
454003939
CADD DRAWING
THIS DRAWING GENERATED BY NPPD

COOPER NUCLEAR STATION	DC ONE LINE DIAGRAM
3058	N41

BURNS & ROE

DEC. 29, 1998 NPPD

APERTURE CARD

9907090006

PDR RIDS

9907090006

