


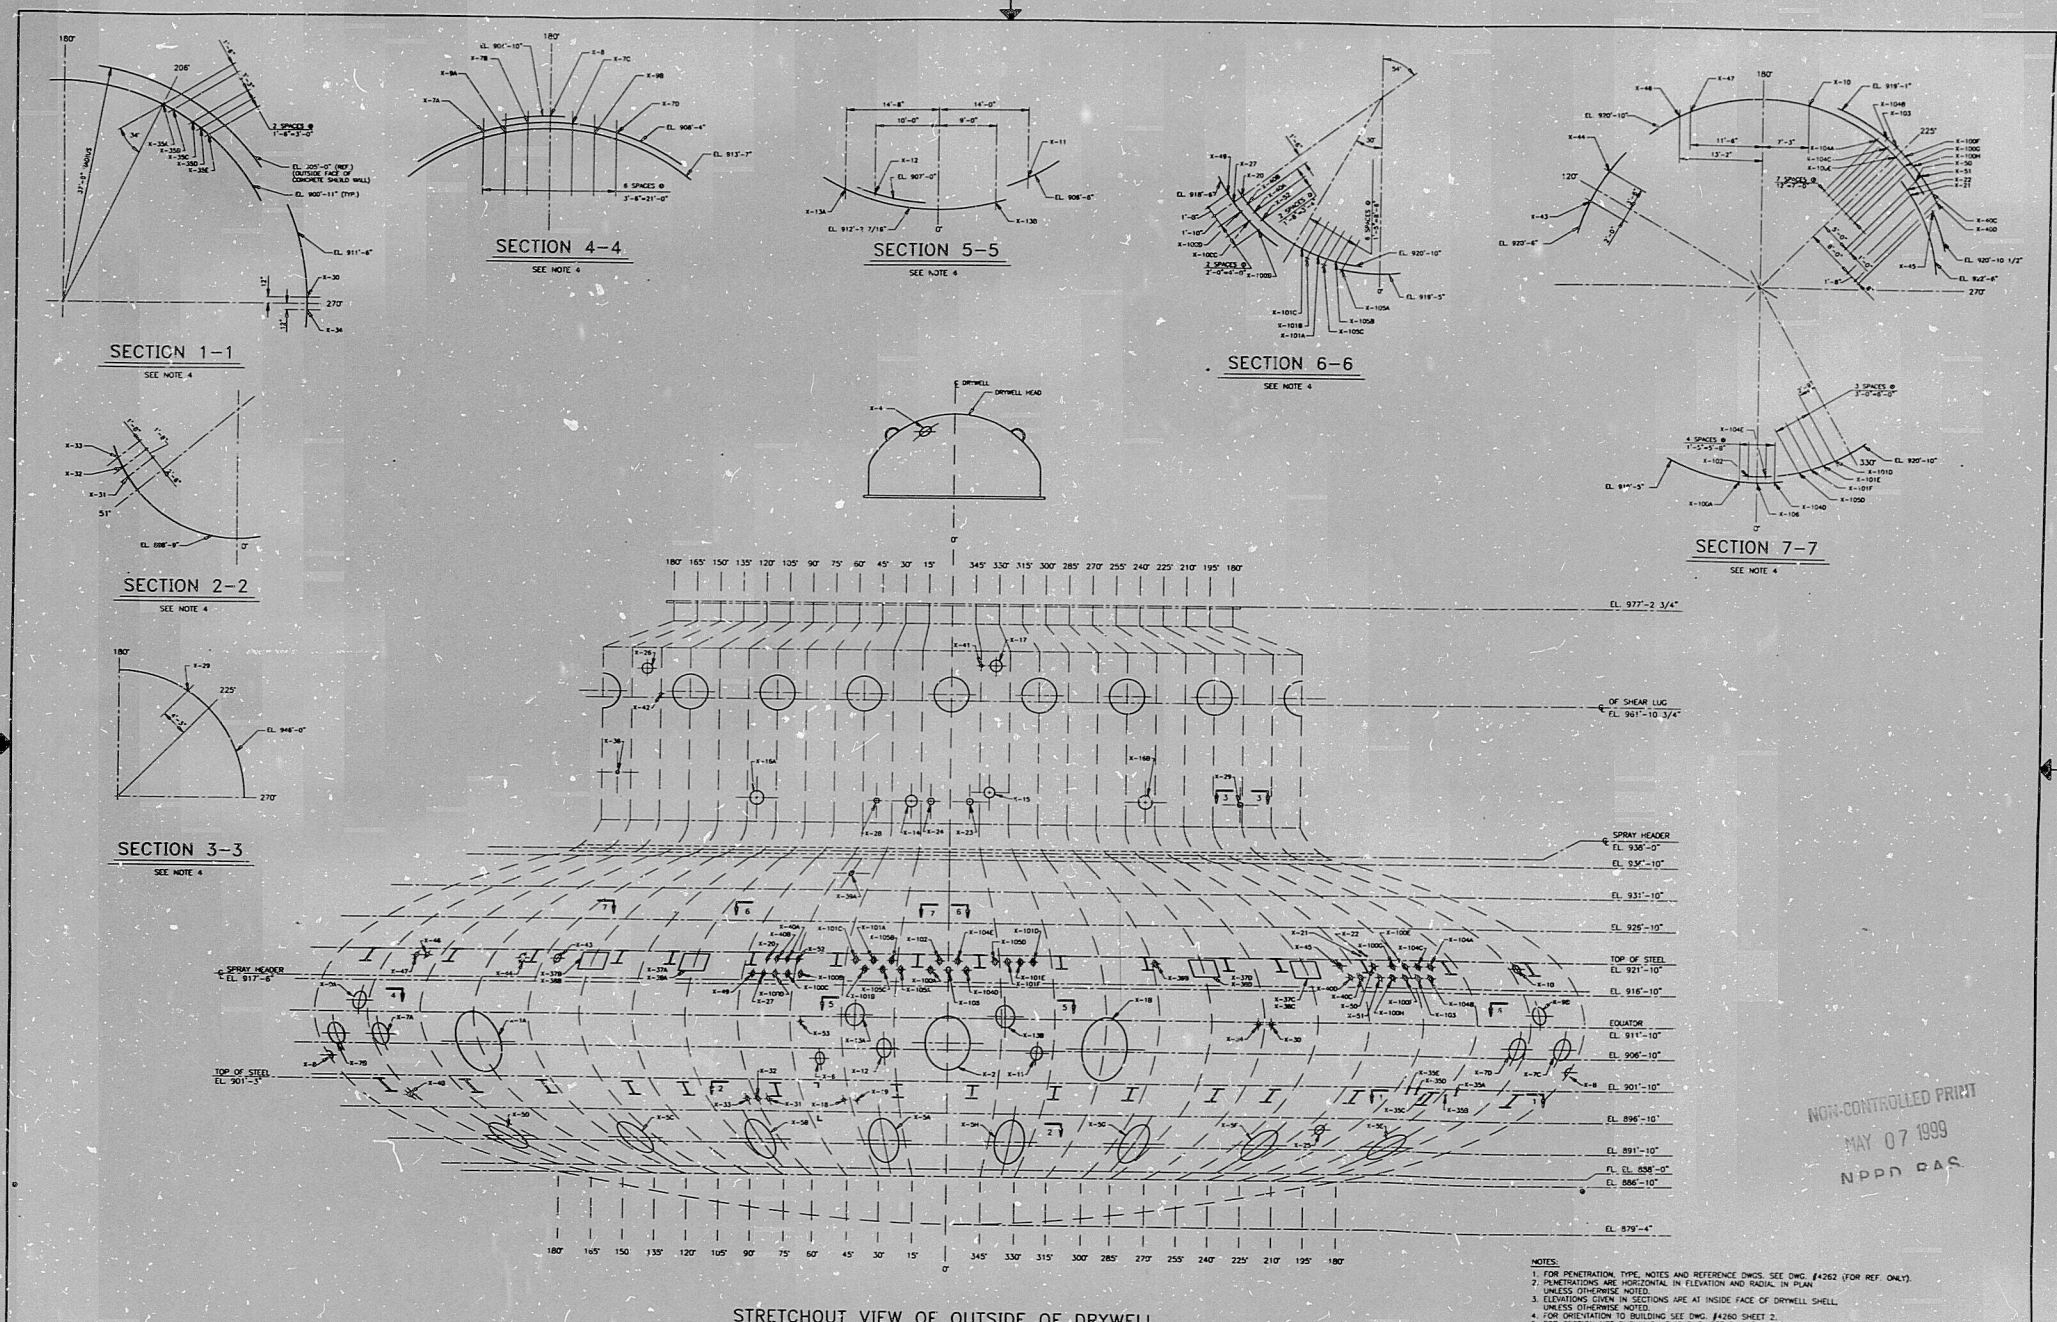

NON-CONTROLLED PRINT
MAY 07 1999
NPPD CAS

- NOTES:
1. FOR PENETRATION, TYPE, NOTES AND REFERENCE DIMS. SEE DWG. #4262 (FOR REF. ONLY).
 2. PENETRATIONS ARE HORIZONTAL IN ELEVATION AND RADIAL IN PLAN, UNLESS OTHERWISE NOTED.
 3. ELEVATIONS SHOWN IN SECTIONS ARE AT INSIDE FACE OF DRYWELL SHELL, UNLESS OTHERWISE NOTED.
 4. FOR ORIENTATION TO BUILDING SEE DWG. #4260 SHEET 2.
 5. FOR SECTION NOT SHOWN ON THIS DWG. SEE DWG. #4262 (FOR REF. ONLY).
 6. ALL PENETRATIONS ARE SHOWN IN THEIR APPROXIMATE LOCATION.

THIS DRAWING IS NOT TO SCALE
* THIS DRAWING GENERATED BY NPPD

454004628
AS BUILT
CADD DRAWING

FOR PREVIOUS REVISIONS, SEE SUPERSEDED CARDS	REVISIONS BY	DATE	APPROVED BY	DATE
1	W. J. BURNS	10/10/97	W. J. BURNS	10/10/97
2	W. J. BURNS	10/10/97	W. J. BURNS	10/10/97
3	W. J. BURNS	10/10/97	W. J. BURNS	10/10/97
4	W. J. BURNS	10/10/97	W. J. BURNS	10/10/97
5	W. J. BURNS	10/10/97	W. J. BURNS	10/10/97
6	W. J. BURNS	10/10/97	W. J. BURNS	10/10/97
7	W. J. BURNS	10/10/97	W. J. BURNS	10/10/97
8	W. J. BURNS	10/10/97	W. J. BURNS	10/10/97
9	W. J. BURNS	10/10/97	W. J. BURNS	10/10/97
10	W. J. BURNS	10/10/97	W. J. BURNS	10/10/97

CONTAINMENT VESSEL
PENETRATION LOCATION
SHEET 1

BURNS & ROE
4259
N10

MAR. 31, 1997 NPPD

APERTURE
CARD

9907090015

PDR RIDS

9907090015

