
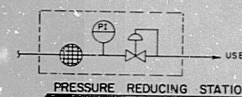


STATION #	FILTER	PRV	OILER	2010 SHT	NOTES
1	F-769 AV	N/A	LUB-769 AV	2	
2	F-772 AV		LUB-772 AV		
3	F-768 AV		LUB-768 AV		
4	F-771 AV		LUB-771 AV		
5	F-765		LUB-765 AV		
6	F-265		LUB-265 AV		
7	F-267		LUB-267 AV		
8	F-269	N/A	LUB-269 AV		
9	F-756 AV	PRV 84	N/A		
10	F-758 AV	PRV 85	N/A		
11	F-759	PRV 82	N/A		
12	F-757	PRV 81	N/A		
13	F-1331 AV	PRV 151	LUB-1331 AV		
14	F-1332 AV	PRV 153	LUB-1332 AV	2	
15	F-10	PRV 2690	LUB-10	3	A
16	F-11	PRV 2691	LUB-11		
17	F-7	N/A	LUB-7		
18	F-8		LUB-8		
19	F-5		LUB-5		
20	F-4		LUB-4		
21	F-3		LUB-3		
22	F-2	N/A	LUB-2		
23	F-2	N/A	LUB-2	3	A
24	DELETED				
25	F-45	PRV 131	N/A	1	
26	F-LMC	N/A	LUB-LMC	4	
27	F-655 AV		LUB-655 AV	1	
28	F-671 AV		LUB-671 AV		
29	F-642 AV		LUB-642 AV		
30	F-843 AV		LUB-843 AV		
31	F-408 AV		LUB-408 AV		
32	F-408 AV		LUB-408 AV		
33	F-404 AV		LUB-404 AV		
34	F-422 AV		LUB-422 AV		
35	F-424 AV		LUB-424 AV		
36	F-402 AV		LUB-402 AV		
37	F-402 AV		LUB-402 AV		
38	F-1330 AV		LUB-1330 AV		
39	F-411 AV		LUB-411 AV		
40	F-412 AV		LUB-412 AV		
41	F-409 AV		LUB-409 AV		
42	F-410 AV		LUB-410 AV		
43	F-403 AV	N/A	LUB-403 AV		
44	F-978 AV	PRV 81	LUB-4085		
45	F-966 AV	PRV 63	LUB-4028		
46	F-980 AV	PRV 82	LUB-4073		
47	F-140	PRV 619	N/A		
48	F-984 AV	PRV 80	LUB-4076		
49	N/A	N/A	LUB-SP2		
50	F-2005	PRV 618	N/A	1	
51	F-36	N/A	LUB-19	3	A
52	F-9	N/A	N/A	3	A
53	F-287.701 AV	N/A	LUB-770 AV	2	
54	F-PAS	PRV 56	N/A	2	
55	F-44	N/A	LUB-M20	1	
56	F-408	PRV 808	N/A	1	
57	F-31	PRV 113	N/A	1	
58	F-9	PRV 2689	N/A	3	A
59	F-740 AV	PRV 740	N/A	2	C.D.
60	F-741 AV	PRV 741	N/A	2	C.D.

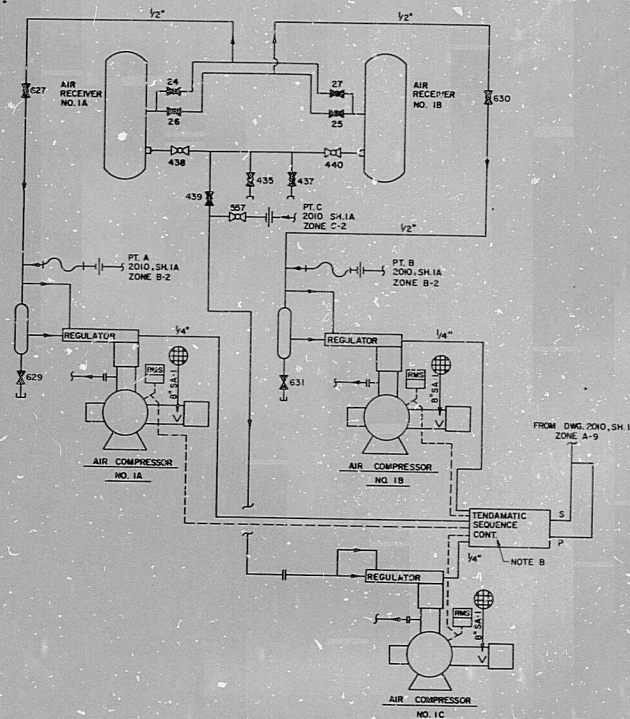

STATION #	CIC NUMBER	2010 SHT
A	HV-PC-(AC-RW-(B))	4
B	HV-PC-(AC-RW-(A))	1
C	HV-PC-(EF-AR-(C))	1
D	HV-PC-ARW	4
E	HV-PC-(FC-C-1A)	1A
F	HV-PC-(FC-CH-1A)	1
G	HV-PC-(AC-CO-1A)	1
H	HV-PC-(EF-MS-1F)	
I	HV-PC-(EF-MS-1G)	
J	1A-PC-100	
K	HV-PC-(AC-T-1A)	
L	HV-PC-(EF-T-1E)	
M	HV-PC-(BP-T-1A/1B)	1
N	HV-PC-(EF-R-1E)	2
P	HV-PC-(EF-R-1F)	2
R	1A-PC-317	4

- NOTES
- DEVICES ASSOCIATED WITH THIS STATION BELONG TO THE SA SYSTEM.
 - REF DWG. INGRESSOR, RAND 1075000 F-28399-D.
 - LOCATIONS OF FILTERS & REDUCING VALVE ARE REVERSED.
 - E70-19 BOUNDARY IS AT THE REDUCING VALVE'S OUTLET.

NON-CONTROLLED POINT

MAY 07 1998

NPPD PAS

454237341

AS BUILT

* THIS DRAWING GENERATED BY NPPD.

BURNS AND ROE, INC.
ENGINEERS AND CONSTRUCTORS
ORACLE, N.J. 08502, N.Y. 10018, CALIF.
INSTRUMENT & SERVICE AIR
MISCELLANEOUS DETAILS
NEBRASKA PUBLIC POWER DISTRICT
COOPER NUCLEAR STATION

REVISIONS BY NPPD	DATE	DESCRIPTION
1	11/11/97	ISSUED FOR CONSTRUCTION
2	11/11/97	ISSUED FOR CONSTRUCTION
3	11/11/97	ISSUED FOR CONSTRUCTION
4	11/11/97	ISSUED FOR CONSTRUCTION
5	11/11/97	ISSUED FOR CONSTRUCTION
6	11/11/97	ISSUED FOR CONSTRUCTION
7	11/11/97	ISSUED FOR CONSTRUCTION
8	11/11/97	ISSUED FOR CONSTRUCTION
9	11/11/97	ISSUED FOR CONSTRUCTION
10	11/11/97	ISSUED FOR CONSTRUCTION

MAY 20, 1998 NPPD

APERTURE CARD

9907190020

PDR RIDS

9907190020

