


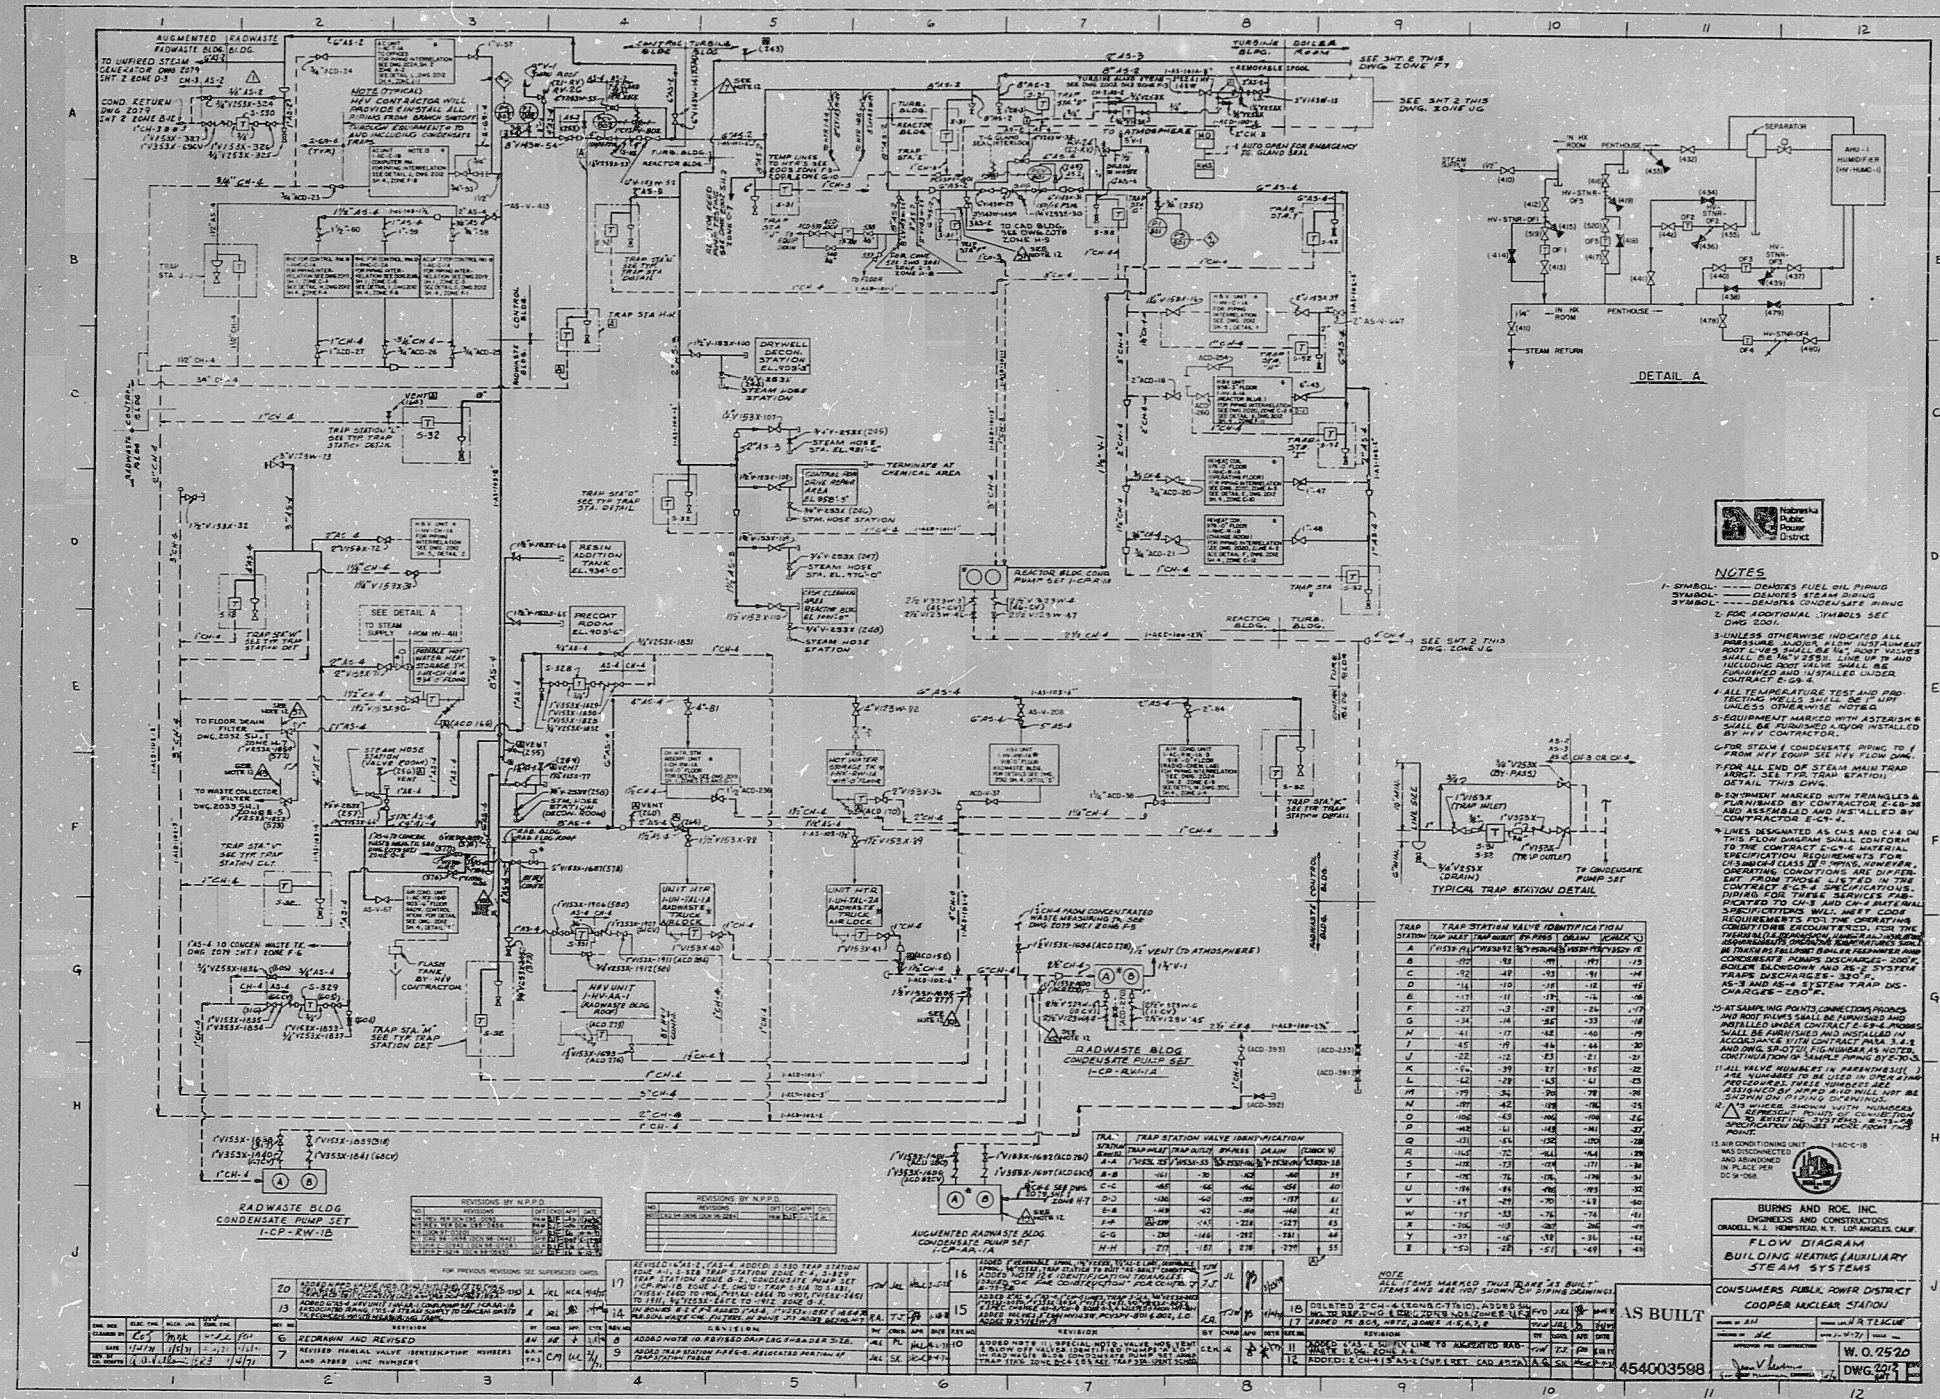

AUG. 26, 1998 NPPD

NON-CONTROLLED PRINT

MAY 07, 1999

NPPD P.A.S.

APERTURE
CARD

AS BUILT

454003598

BURNS AND ROE, INC.
ENGINEERS AND ARCHITECTS
SMALL BUSINESS ENTERPRISE, LOS ANGELES, CALIF.
BUILDING HEATING/VENTILATION
STEAM AND SYSTEMS
CONSUMERS PUBLIC POWER DISTRICT
COOPER NUCLEAR STATION

9907190021

PDR RIDS

9907190021

