



9699-FM-1A

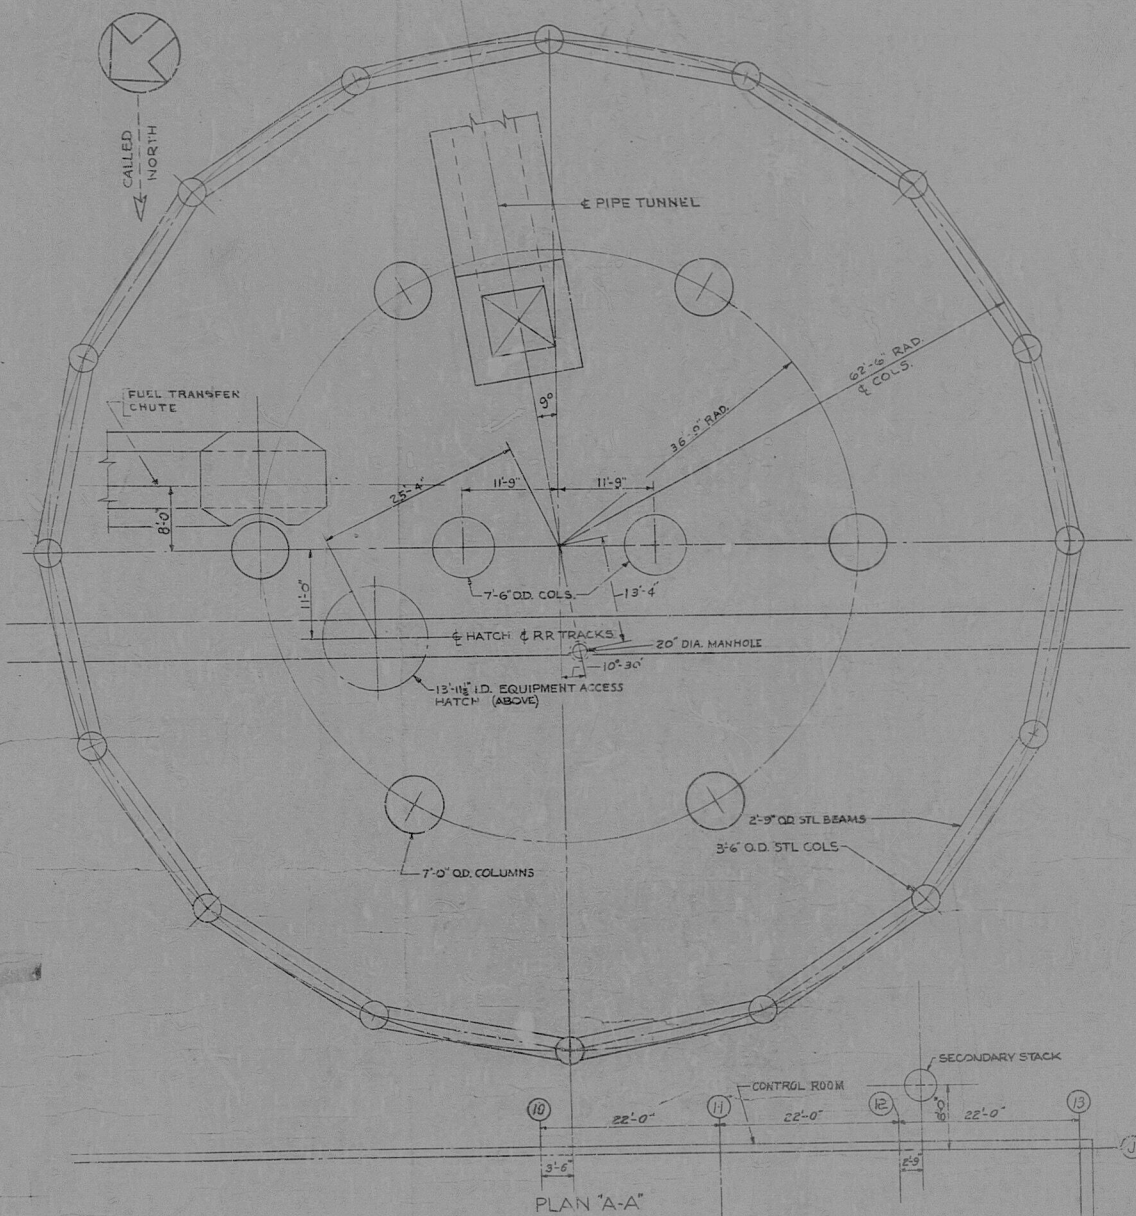

PLAN 'A-A'

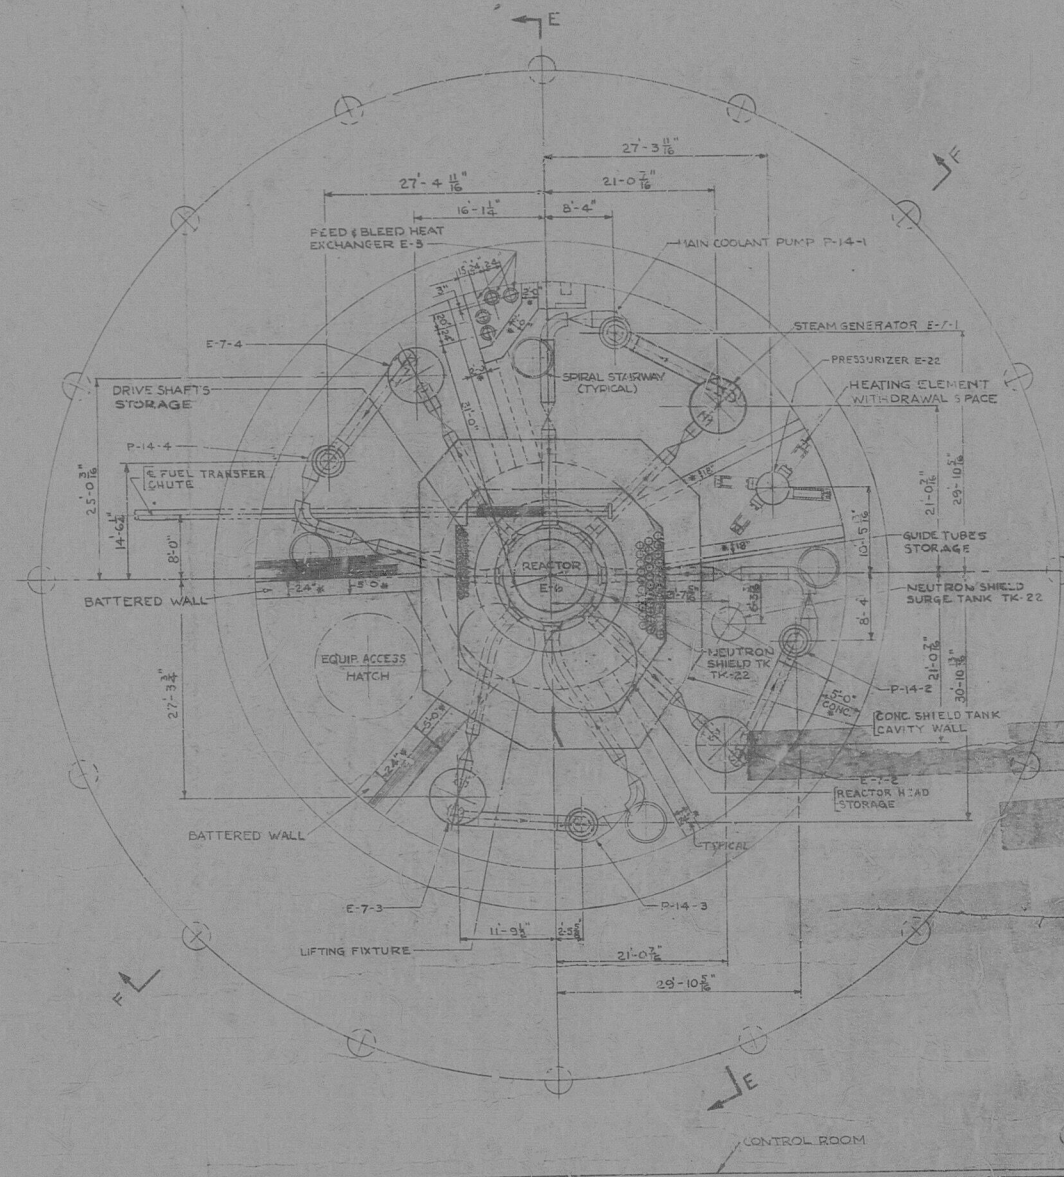

PLAN 'B-B'

NOTES:
MINIMUM THICKNESS REQUIRED FOR SHIELDING
FOR ACTUAL WALL THICKNESS SEE CONCRETE
DWG 9699-FC-56A & RC-56B.

REFERENCES
MACHINE LOCATION - PLANS SH NO 2 VAPOR CONTAINER DWG 9699-FM-1B
MACHINE LOCATION - SECTION 5 - VAPOR CONTAINER DWG 9699-FM-1C
PLATFORMS & LADDERS - VAPOR CONTAINER DWG 9699-FM-1D
FIRST VAPOR CONTAINER CHARGING FLOOR
DISMANTLING & LAY DOWN AREA - SH 1 DWG 9699-FM-1E

NO.	DESCRIPTION	DATE	BY	CHKD	APPD
1	AS BUILT CHANGES	12/24/73	WJS	WJS	WJS
2	FUEL TRANSFER CHUTE AND	12/24/73	WJS	WJS	WJS
3	PIPE TUNNEL, DISMANTLING & RELOCATION	12/24/73	WJS	WJS	WJS
4	MANHOLE ADDED	12/24/73	WJS	WJS	WJS
5	FEED BLEED HEAT EXCHANGER	12/24/73	WJS	WJS	WJS
6	RELOCATION OF EQUIPMENT	12/24/73	WJS	WJS	WJS
7	RELOCATION OF EQUIPMENT	12/24/73	WJS	WJS	WJS
APPROVED: *Walter C. Johnson*
REGISTERED PROFESSIONAL ENGINEER NO. 121
COMMONWEALTH OF MASSACHUSETTS
MACHINE LOCATION PLANS SH NO. 1
VAPOR CONTAINER
POWER STATION
YANKEE ATOMIC ELECTRIC COMPANY
ROWE, MASS.
STONE & WEBSTER ENGINEERING CORPORATION
SCALE: 1/8" = 1'-0"
DRAWING NUMBER: 9699-FM-1A

9699

FM-1A

6MACH LOC PLANS VAPOR CONTR SH 1

29X

8104030783

Yankee Rowe

DDAFAC
NRCA ANPG F NC~~xxx~~

