


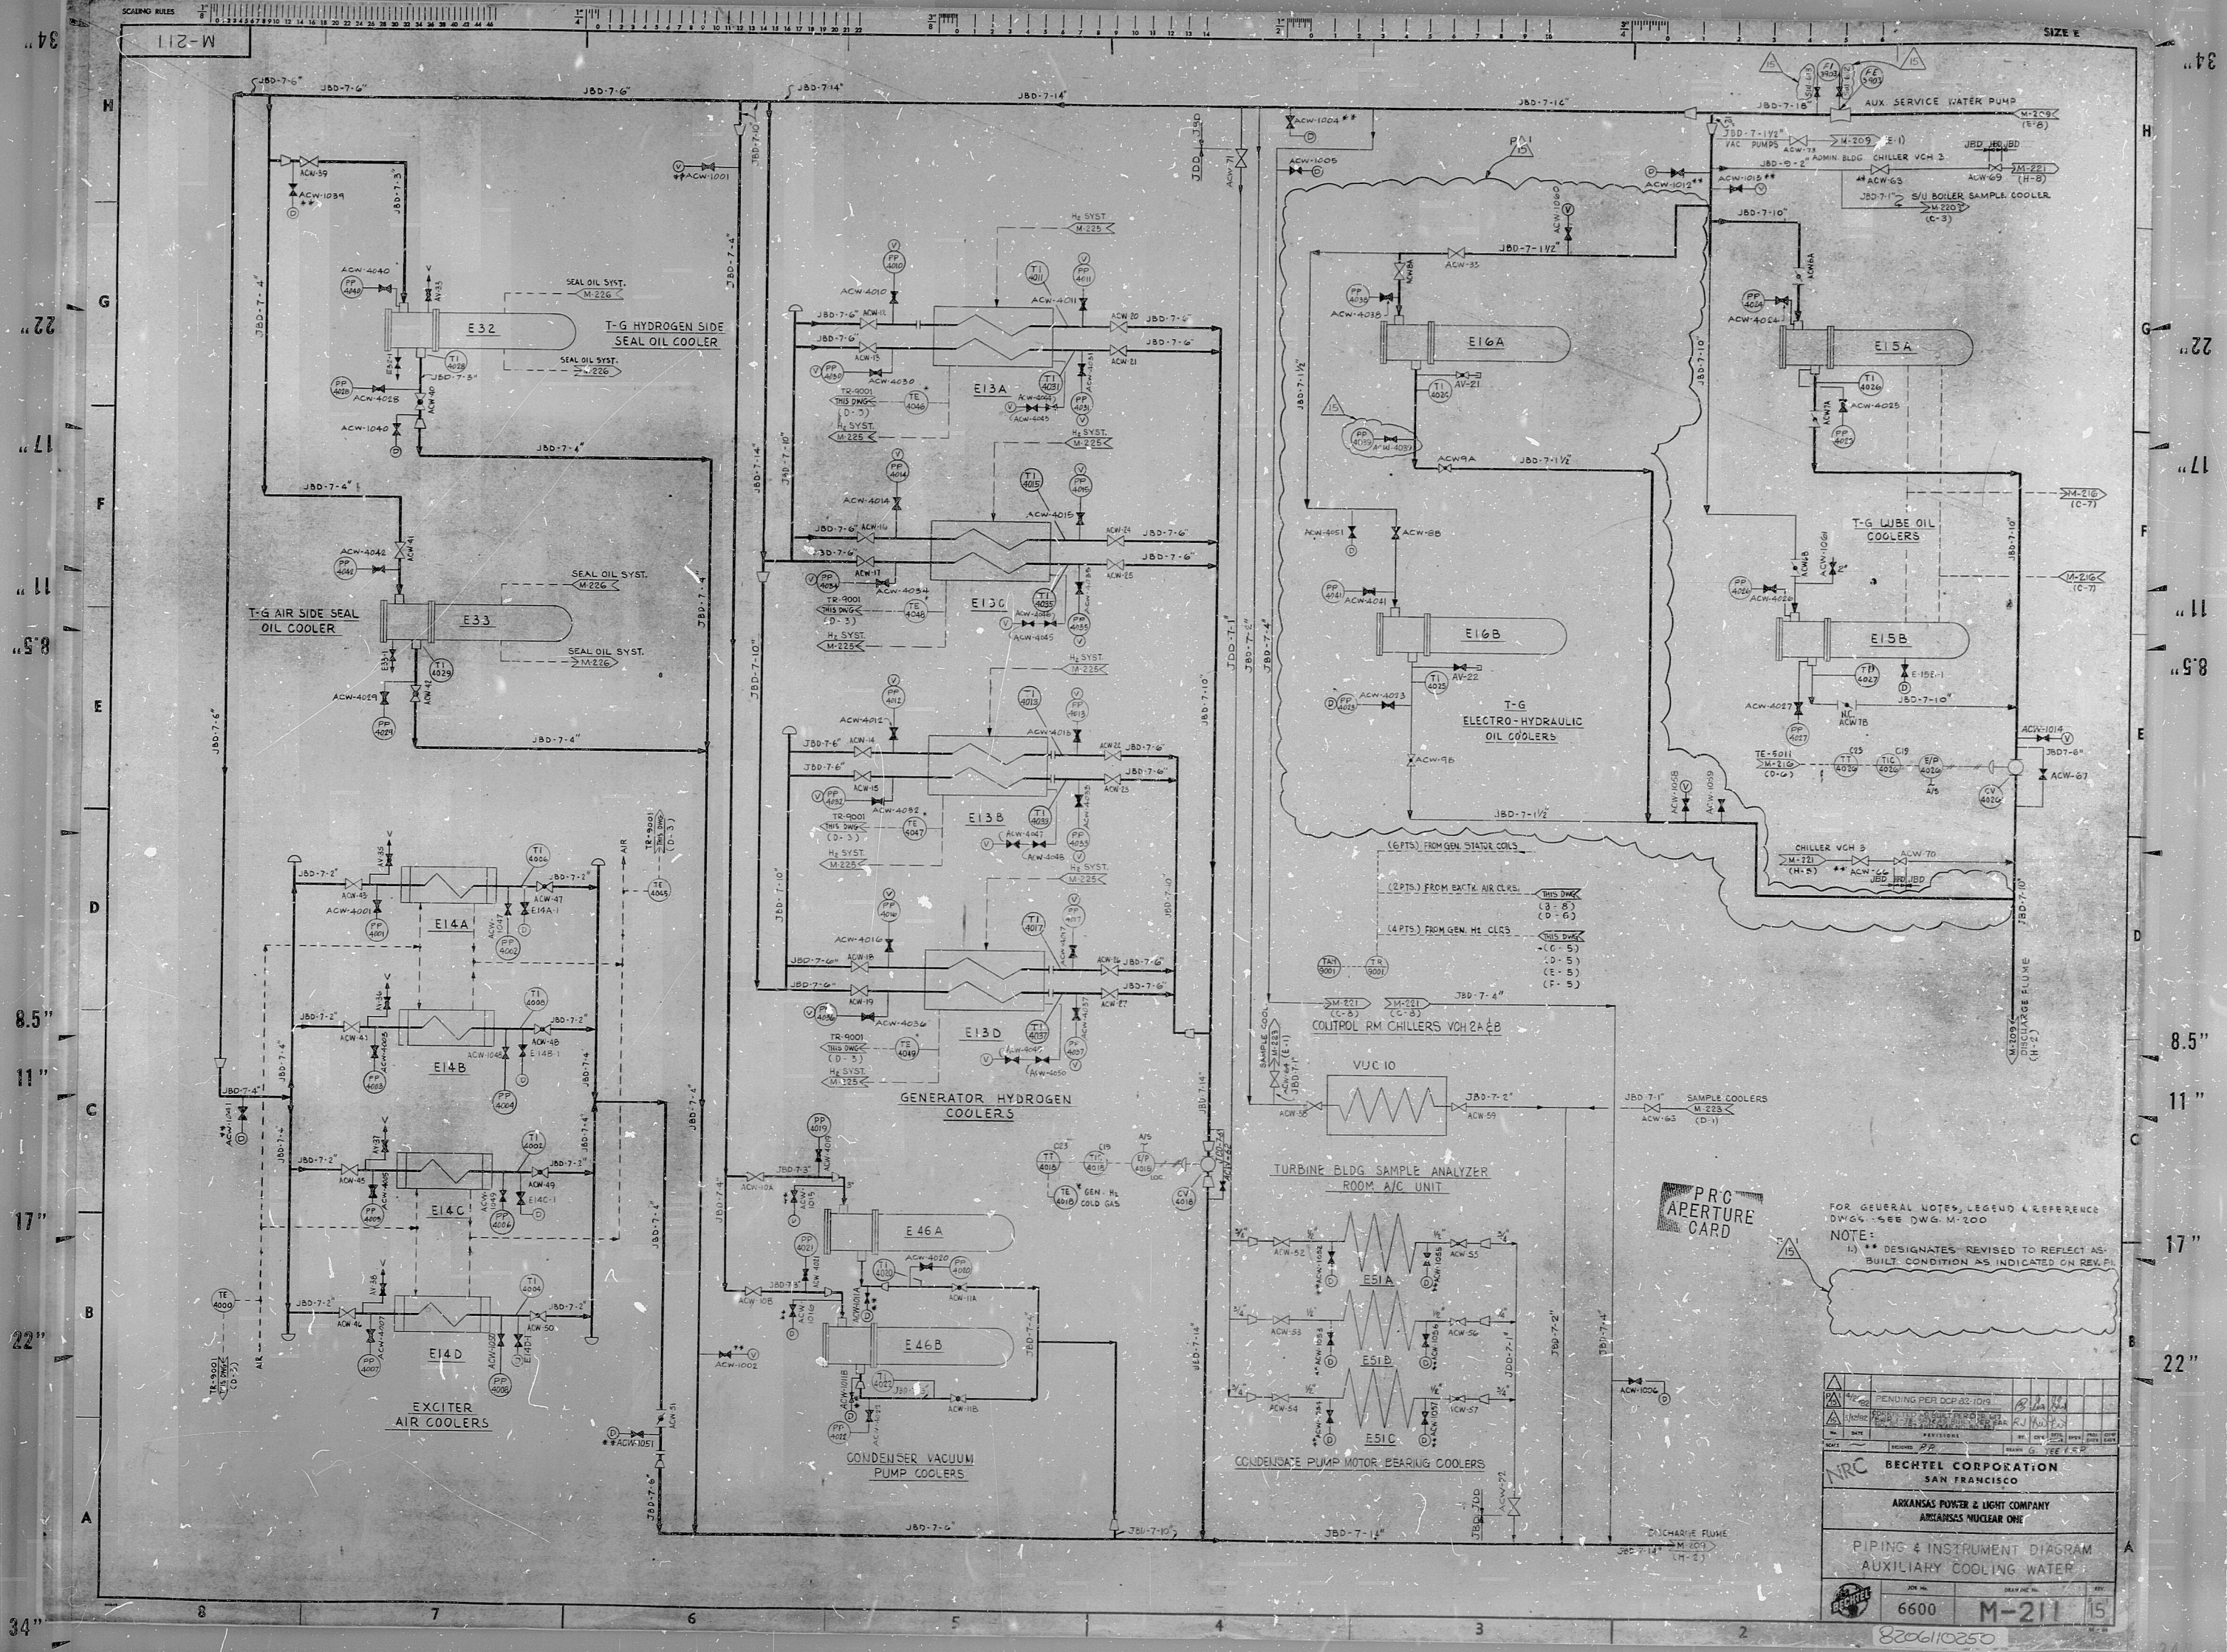

FOR GENERAL NOTES, LEGEND & REFERENCE
DWGS - SEE DWG. M-200
NOTE:
1) * DESIGNATES REVISED TO REFLECT AS-BUILT CONDITION AS INDICATED ON REV. FL.

REVISION	DATE	BY	CHKD	APP'D
1	8/20/61	W. J. YEE	W. J. YEE	W. J. YEE
2	8/20/61	W. J. YEE	W. J. YEE	W. J. YEE
3	8/20/61	W. J. YEE	W. J. YEE	W. J. YEE
4	8/20/61	W. J. YEE	W. J. YEE	W. J. YEE
5	8/20/61	W. J. YEE	W. J. YEE	W. J. YEE
6	8/20/61	W. J. YEE	W. J. YEE	W. J. YEE
7	8/20/61	W. J. YEE	W. J. YEE	W. J. YEE
8	8/20/61	W. J. YEE	W. J. YEE	W. J. YEE
9	8/20/61	W. J. YEE	W. J. YEE	W. J. YEE
10	8/20/61	W. J. YEE	W. J. YEE	W. J. YEE

6600 M-211 15

8206110250

IRC

50-313

8206110250

