


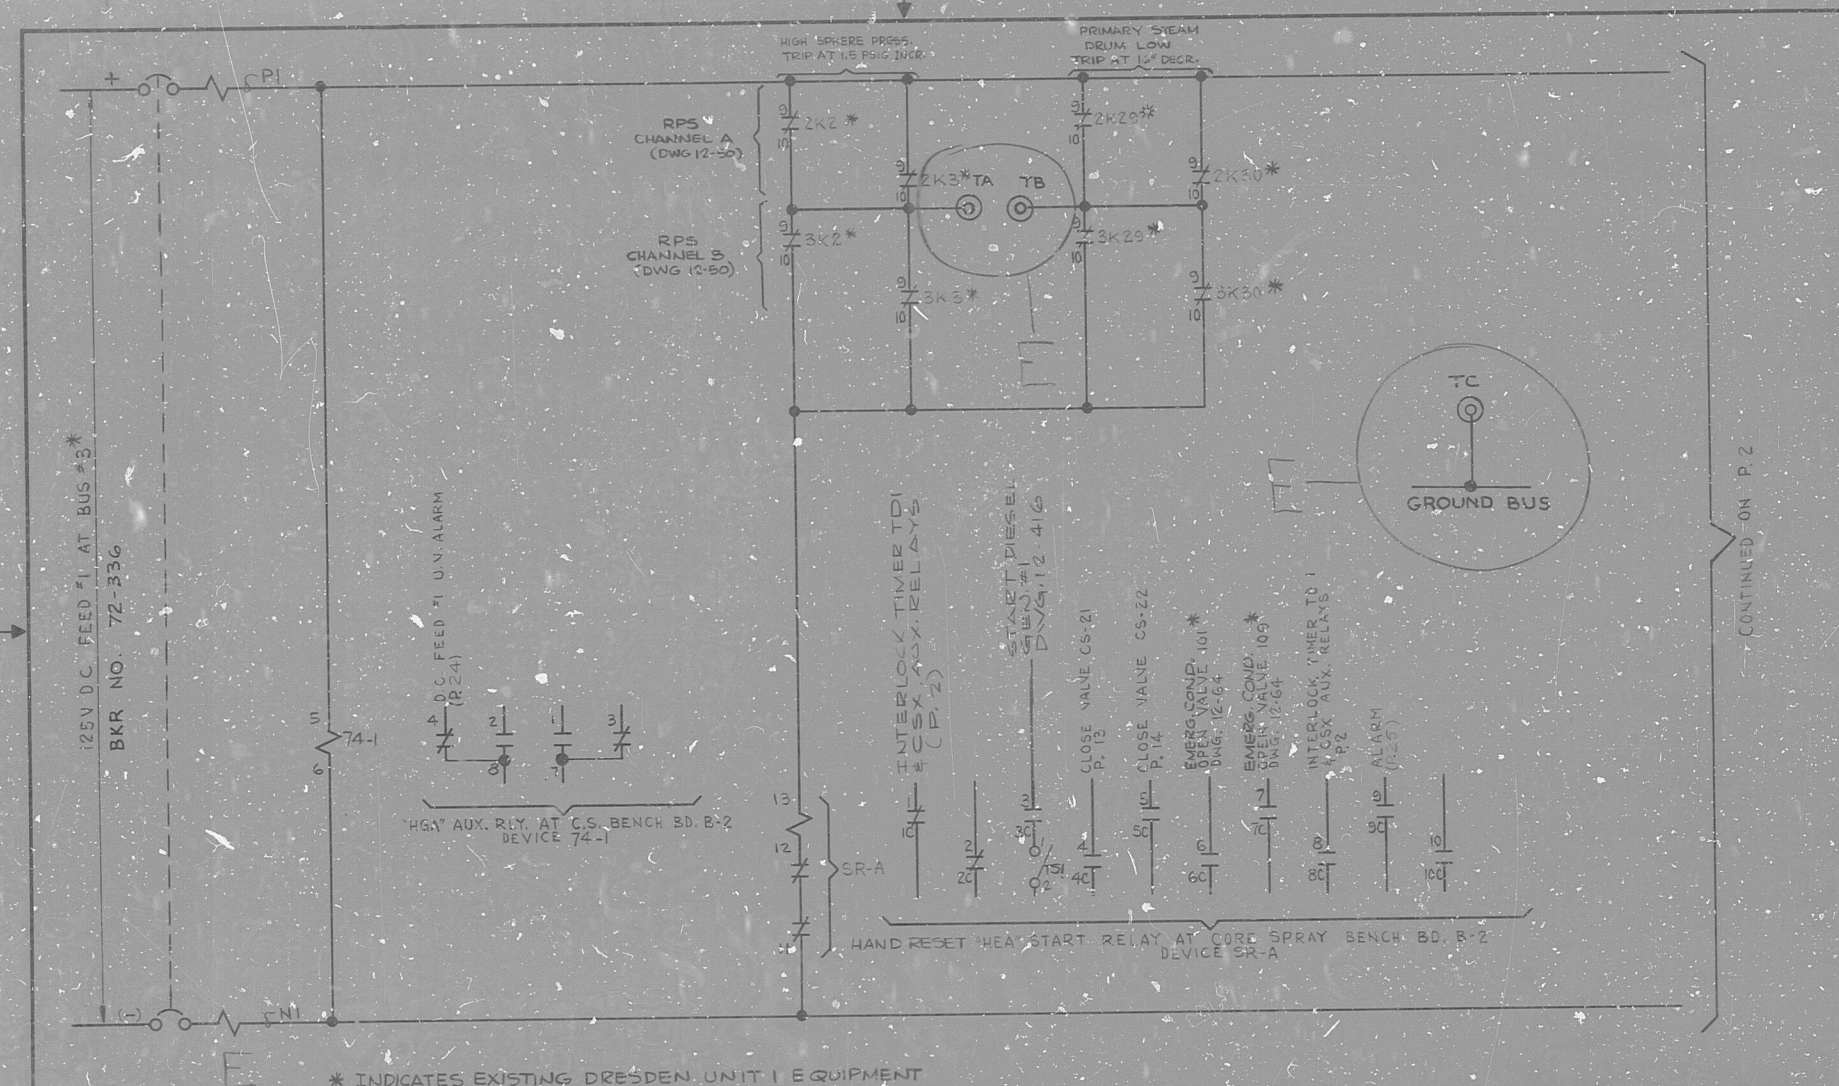

* INDICATES EXISTING DRESDEN UNIT 1 EQUIPMENT

REVISIONS				DATE		INITIATION CIRCUIT 1-PT.1 - EMERG. CORE COOLING SYS.			
A	8-24-71	AA	ISSUED FOR CONSTRUCTION	E	7-20-75	M-12-1-73-54	DRAWN	B. LINDY	8-24-71
B	8-15-72	LM	REVISION MISC.				CHECKED	A. AHMED	8-24-71
C	8-15-72	LM	AS BUILT				ENGINEER	W. Schwab	8-26-71
D	1-16-73	LM	AS BUILT						

SARGENT & LUNDY
ENGINEERS

SCHEMATIC DIAGRAM
DRESDEN NUCLEAR PWR STA
UNIT 1
COMMONWEALTH EDISON CO
CHICAGO, ILLINOIS

JOB NO.
4077
DWG. NO. 125 1001
PAGE 1

12 E 1001 Page 1

8104130407

DDAELE

