

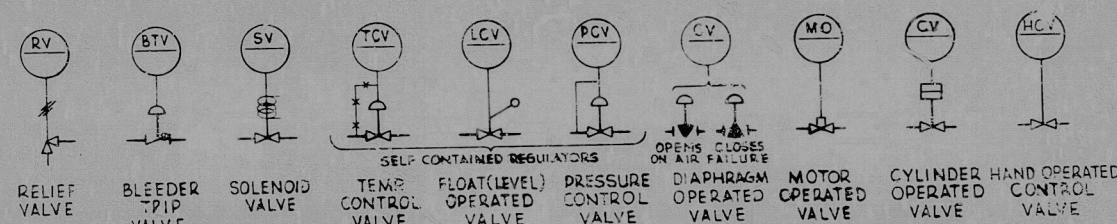
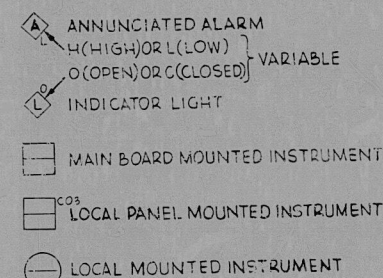


FUNCTION OF DEVICE (THIRD LETTER)	CONTROLLER		TRANSMITTER		METER		MISCELLANEOUS			
	C		T		M		S	E	X	G
	INDICATOR OR BLIND	RECORDER	INDICATOR OR BLIND	RECORDER	INDICATOR	RECORDER				
MEASURED VARIABLE (FIRST LETTER)		"R"		"R"	"I"	"R"	"S"	"E"	"X"	"G"
PRESSURE	P	PC	PRC	PT	PRT	PI	PR	PS	—	PX
TEMPERATURE	T	TC	TRC	TT	TRT	TI	TR	TS	TE	TX
FLOW	F	FC	FRC	FT	FRT	FI	FR	FS	FE	FX
LEVEL	L	LC	LRC	LT	LRT	LI	LR	LS	LE	LX
CONDUCTIVITY	C	CC	CRC			CI	CR	CS	CE	
DENSITY	De	DeC	DeRC	DeT		DeI	DeR	DeS		
OXYGEN	O ₂			O ₂ T		O ₂ I	O ₂ R			
PRESSURE DIFF.	dP	dPC		dPT		dPI	dPR	dPS		
RADIATION	R	RC		RT		RI	RR	RS	RE	RX
HYDROGEN ION CONC.	pH	pHC	pHRC	pHT	pHRT	pHI	pHR	pHS	pHE	pHX
DEW POINT	M					MI		MS	ME	
HUMIDITY	Hu	HuC						HuS		


CONTROL VALVES

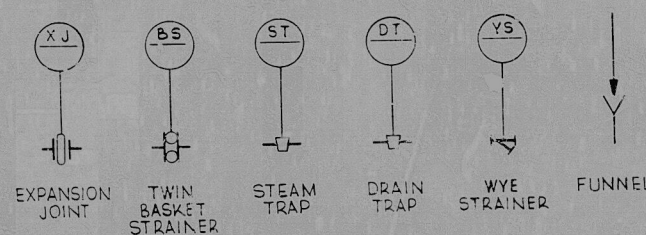


PIPING

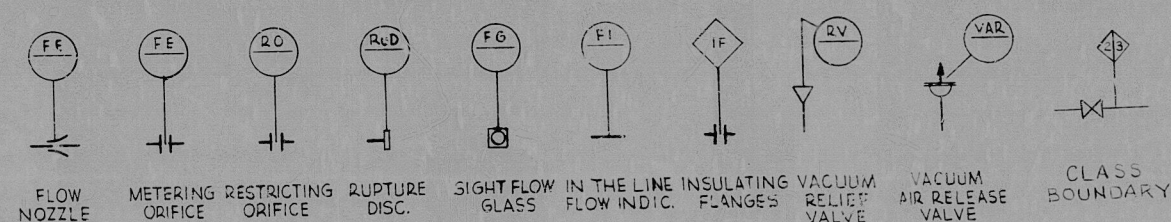


LINE

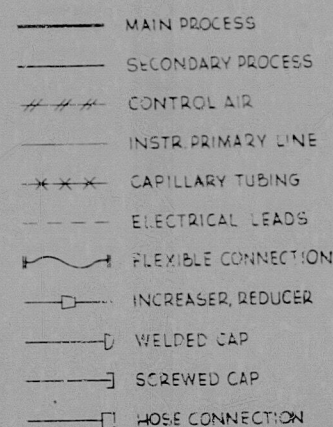

VALVES

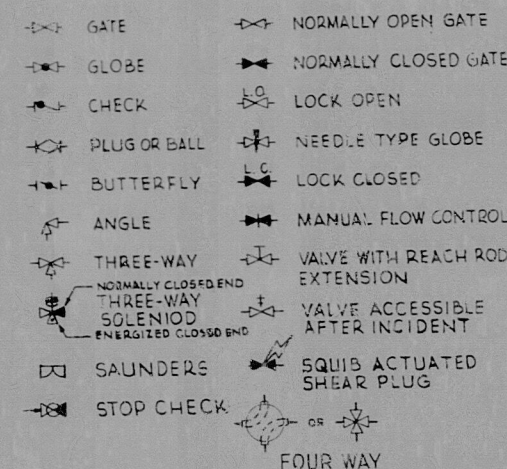

MISCELLANEOUS

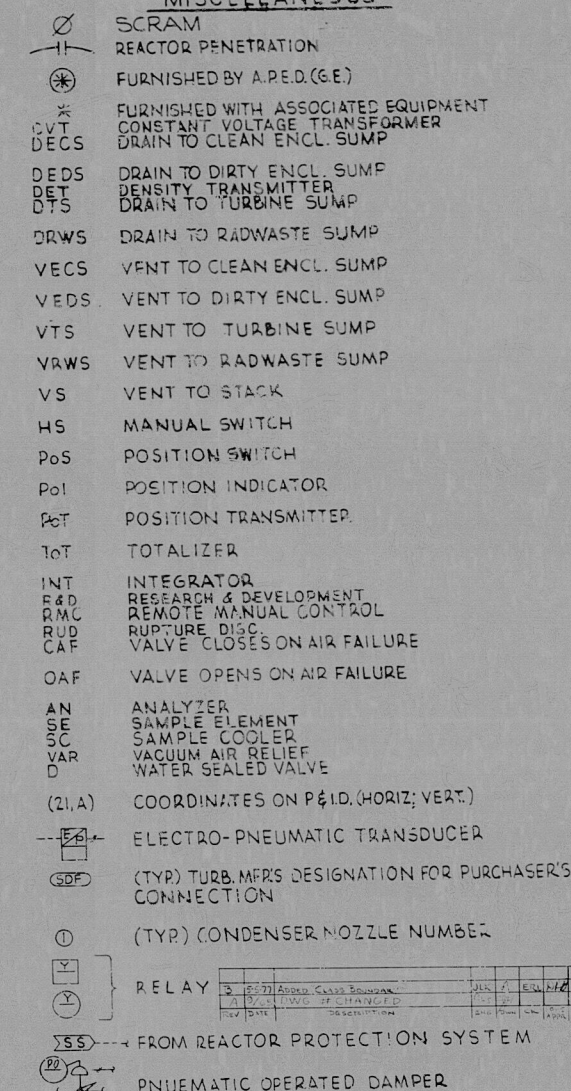


CONTROL PANEL NUMBERS

C01	CONTROL CONSOLE - CONTROL ROOM	M-201
C02	CONTROL PANEL - CONTROL ROOM	M-201
C03	SCREEN CONTROL PANEL	M-44
C04	120V INSTR. A-C AUTOMATIC TRANSFER PANEL	
C05	REACTOR PROTECTION SYS. M-G SET CONTR. PANEL	M-2
C06	RADWASTE CONTROL PANEL	M-93
C07	HEATING BOILER CONTROL PANEL	M-47
C08	CONDENSATE DEMIN. CONTROL PANEL	M-29
C09	DIESEL FIRE PUMP CONTROL PANEL	M-16
C10	HYDROGEN CONTROL PANEL	M-1
C11	AIR COMPRESSOR #1 CONTROL PANEL	M-59
C12	AIR COMPRESSOR #2 CONTROL PANEL	
C13	AIR COMPRESSOR #3 CONTROL PANEL	
C14	FIRE SYSTEM ACCUM. CONTROL PANEL	M-221
C15	CLEAN-UP DEMIN. LOCAL PANEL	M-93
C16	DOMESTIC WATER ACCUM. CONTROL PANEL	M-221
C17	ELECTRIC FIRE PUMP CONTROL PANEL	
C18	EMERG. DIESEL ENGINE-GEN. CONTROL PANEL	M-38
C19	EQUIPMENT LOCK PANEL	CB+1
C20	REACTOR BLDG. VENTILATION CONTROL PANEL	M-96
C21	PERSONNEL LOCK CONTROL BOARD	CB+1
C22	REACTOR BLDG. SUPPLY AIR FANS CONTROL PANEL	
C23	REACTOR BLDG. SPACE HTG. & COOL. WATER HEAT EXCH. LOCAL CONTROL PANEL	M-92
C24	REACTOR BLDG. STEAM DRUM PIPEWAY COOL. SYS. LOCAL CONTROL PANEL	
C25	138 KV LINE CARRIER TRANSMITTER RECVR. CABINET	
C26	REACTOR BLDG. AIR SUPPLY SHED CONTROL PANEL	M-96
C27	MAKE UP DEMIN. CONTROL PANEL	M-29
C28	AIR EJECTOR OFF-GAS MONITOR PANEL #1	M-2
C29	AIR EJECTOR OFF-GAS MONITOR PANEL #2	
C30	NUCLEAR STEAM SUPPLY LOCAL PANEL	M-93
C31	CONTROL ROD HYDRAULIC SYS. LOCAL PANEL	
C32	STACK GAS SAMPLER MONITOR PANEL #1	M-2
C33	STACK GAS SAMPLER MONITOR PANEL #2	
C34	POISON TANK VALVE FUSE PANEL	
C35	POISON TANK HEATER CONTROL PANEL	

APPROVED
FOR CONSTRUCTION

AS-BUILT

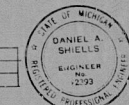

REVISIONS	DATE	BY	CHKD
1. REVISED AS BUILT	7/27/77	D.A.S.	
2. REVISED FOR CONSTRUCTION	7/27/77	D.A.S.	
3. REVISED FOR CONSTRUCTION	7/27/77	D.A.S.	
0740G40105 B001 PIPING & INSTRUMENT DIAG

Legend

60

8104290255

DDAPID

