


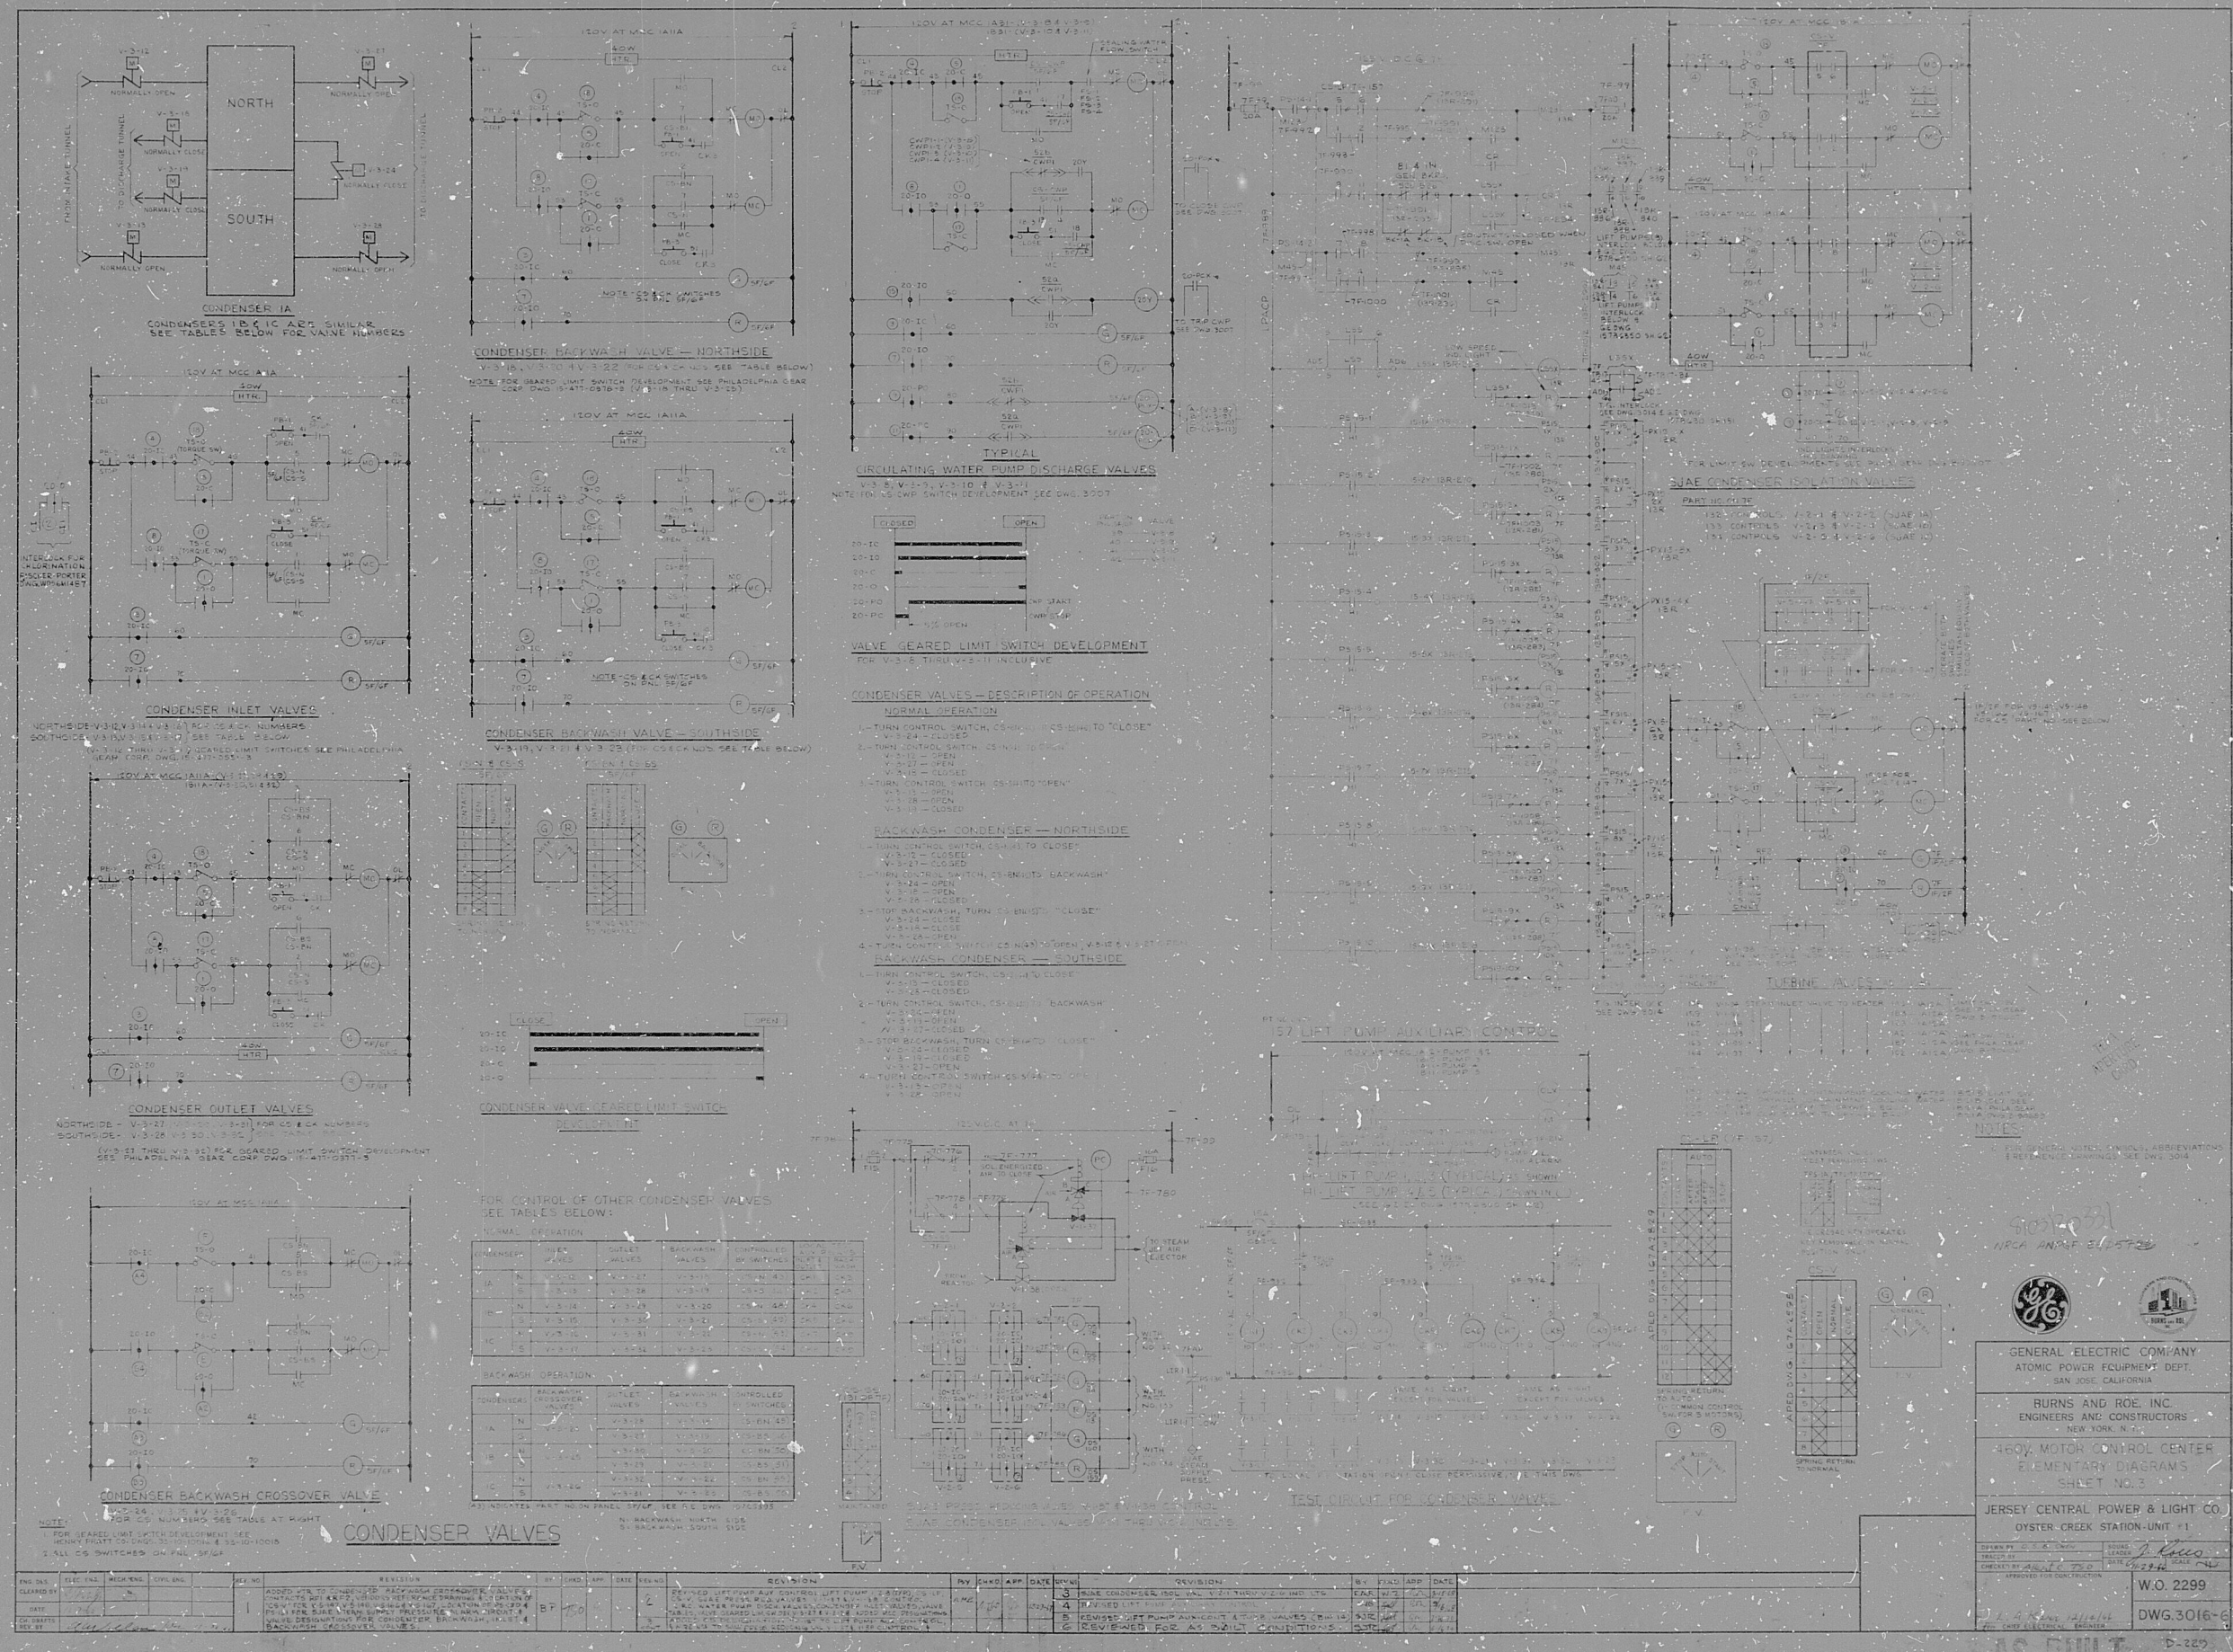

GENERAL ELECTRIC COMPANY
ATOMIC POWER EQUIPMENT DEPT.
SAN JOSE, CALIFORNIA

BURNS AND ROE, INC.
ENGINEERS AND CONSTRUCTORS
NEW YORK, N. Y.

460V. MOTOR CONTROL CENTER
ELEMENTARY DIAGRAMS
SHEET NO. 3

JERSEY CENTRAL POWER & LIGHT CO.
OYSTERS CREEK STATION UNIT #1

DESIGNED BY: J. H. H. DATE: 1/1/58
CHECKED BY: J. H. H. DATE: 1/1/58
APPROVED BY: J. H. H. DATE: 1/1/58

W.O. 2299
DWG. 3016-6

AS BUILT

8105130331

DOCKET
NUMBER

ACCESSION
NUMBER

DRAWING NUMBER

SHEET REV.

