


NPR 34

NORTHEAST UTILITIES

PILOT SOLENOID OPERATED AIR DIAPHRAGM VALVES

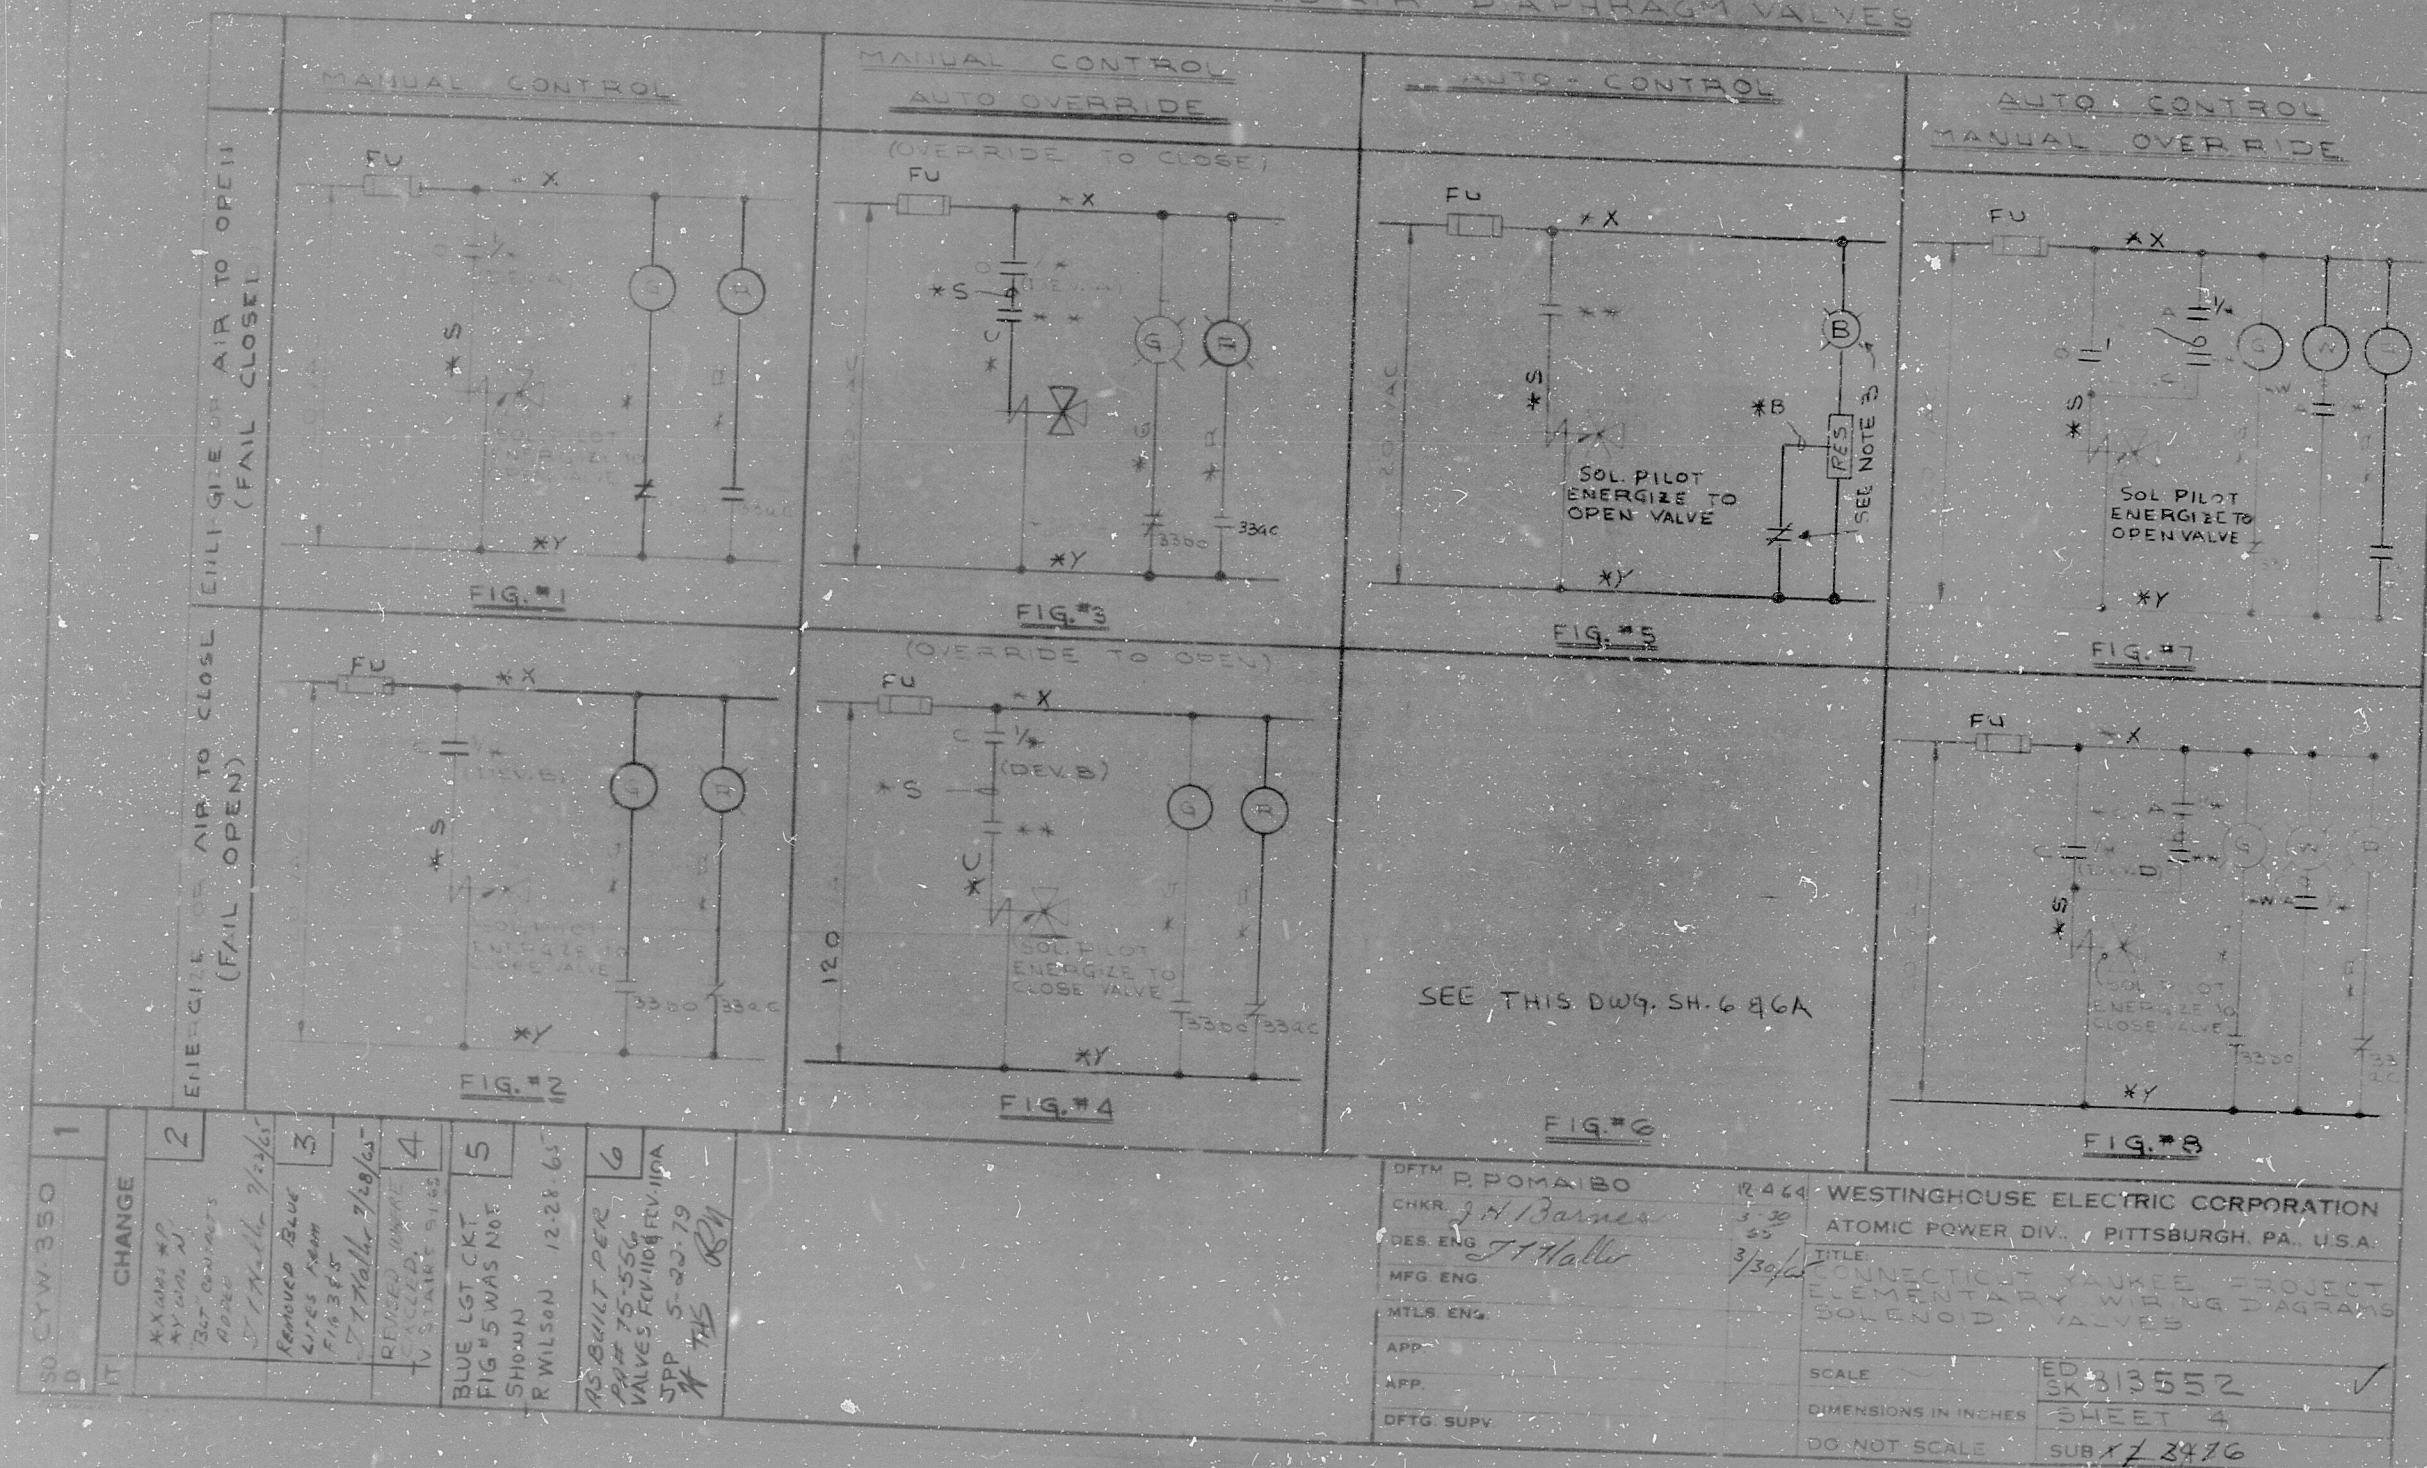

1	CHANGE
2	XXCHG #2 AYCHG #1 3/27/65 JH
3	Removed Blue Wires from Fig. #3 & 5 3/27/65 JH
4	REMOVED BLUE WIRE FROM TV START 9/10/65 JH
5	BLUE LGT. CKT. FIG. #5 WAS NOT SHOWN R. WILSON 12-28-65
6	AS-BUILT PER P. 75-556 VALVES FV104 FV110A JTP 5-23-79 JH

DFTM	R. POMA BO	12-4-64	WESTINGHOUSE ELECTRIC CORPORATION
CHKR	J. H. Barnes	3-25-65	ATOMIC POWER DIV., PITTSBURGH, PA., U.S.A.
DES. ENG.	J. H. Barnes	3/30/65	TITLE
MFG. ENG.			CONNECTICUT VALVE PROJECT
MTLS. ENG.			ELEMENTARY WIRING DIAGRAMS
APP.			SOLENOID VALVES
APP.			SCALE
DFTG. SUPV.			ED 313552
			DIMENSIONS IN INCHES
			SHEET 4
			DO NOT SCALE
			SUB 17-8476
			16101-30113
			AKCA 4046 EDP10



8105140077

DOCKET
NUMBER

ACCESSION
NUMBER

DRAWING NUMBER

SHEET REV.

