


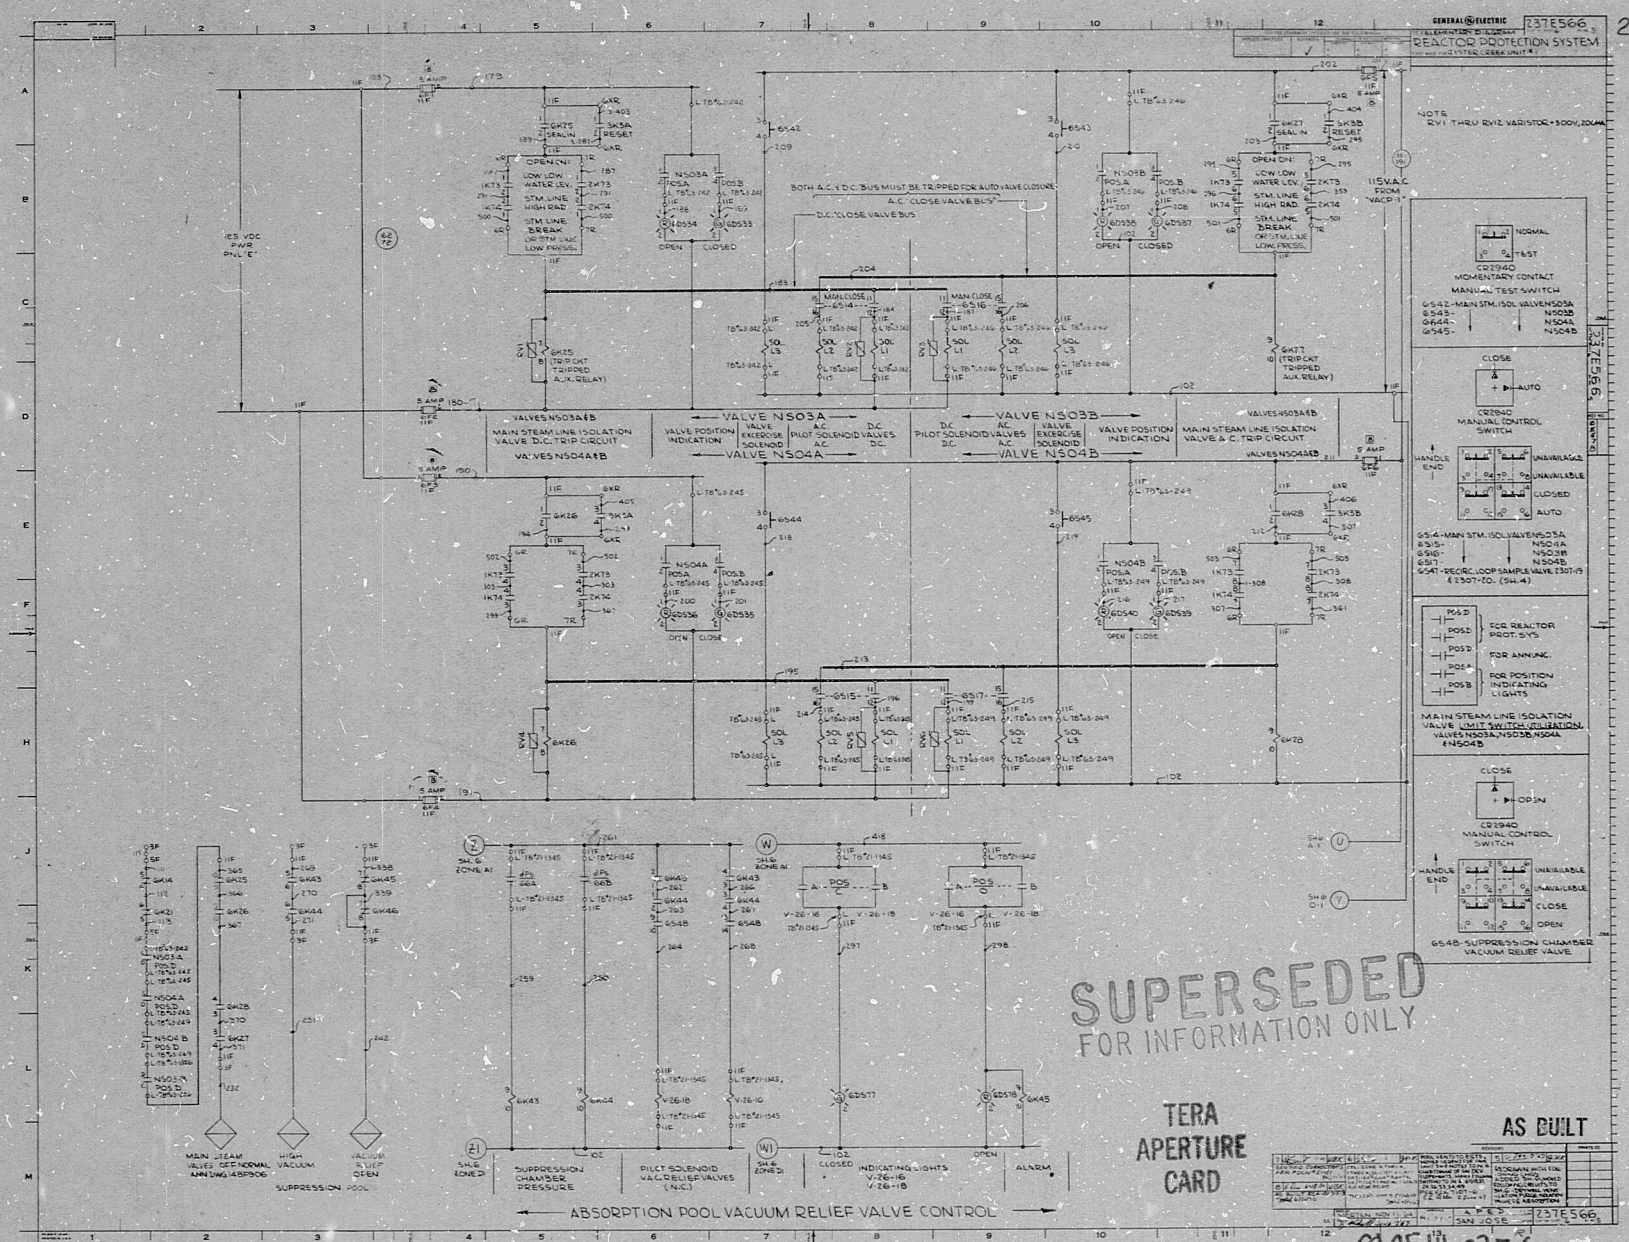

SUPERSEDED
FOR INFORMATION ONLY

TERA
APERTURE
CARD

AS BUILT

8105140256

IRC

50-219

8105140256

