

- NOTE:
1. UNLESS OTHERWISE SPECIFIED ALL PIPE SHALL BE FDR-2
 2. ALL VALVE NUMBERS IN PARENTHESIS () ARE NUMBERS TO BE USED IN OPERATING PROCEDURES. THESE NUMBERS ARE ASSIGNED BY NPPD AND WILL NOT APPEAR ON PIPING DRAWINGS.
 3. △ WHERE SHOWN WITH NUMBERS REPRESENT POINTS OF CONNECTION TO EXISTING SYSTEMS. E73-58 SPECIFICATION DEFINES WORK FROM THIS POINT.
 4. WHERE LINES INTERCONNECT AND ARE CONTINUED ON OTHER DRAWINGS, ZONE NUMBERS ARE APPROXIMATE ONLY.
 5. FLOOR DRAIN SEALED WITH GROUT PER CED 6014761.
 6. EQUIPMENT ABANDONED IN PLACE.

REVISIONS TO THIS DRAWING
REQUIRES A REVISION TO THE
CORRESPONDING ISOKEY.


AS BUILT

454003605

STATUS: Release
STATUS DATE: 06/10/2020
DS APPROVED: JDMADDO
VER: AD REV: 17 SIZE: F

VERSIONS/REVISIONS BY NPPD			
NO.	DESCRIPTION	DATE	ENG
AD/17	DR-2020-0021	20-001 DLR 6/10/20	JDMADDO

SIGNIFICANT NUMBER		DRAWN		DATE	
GROUP	1	2	3	4	5
HYF	5/13/02				
GROUP					
COOPER NUCLEAR STATION					
FLOW DIAGRAM					
TURB. & RADWASTE BLDG. CONTAMINATED					
FL. DRAIN & RADWASTE ROOF DRAIN SYS.					
APPROVED	DATE	BURNS & ROE			
FILED	DATE	2017			

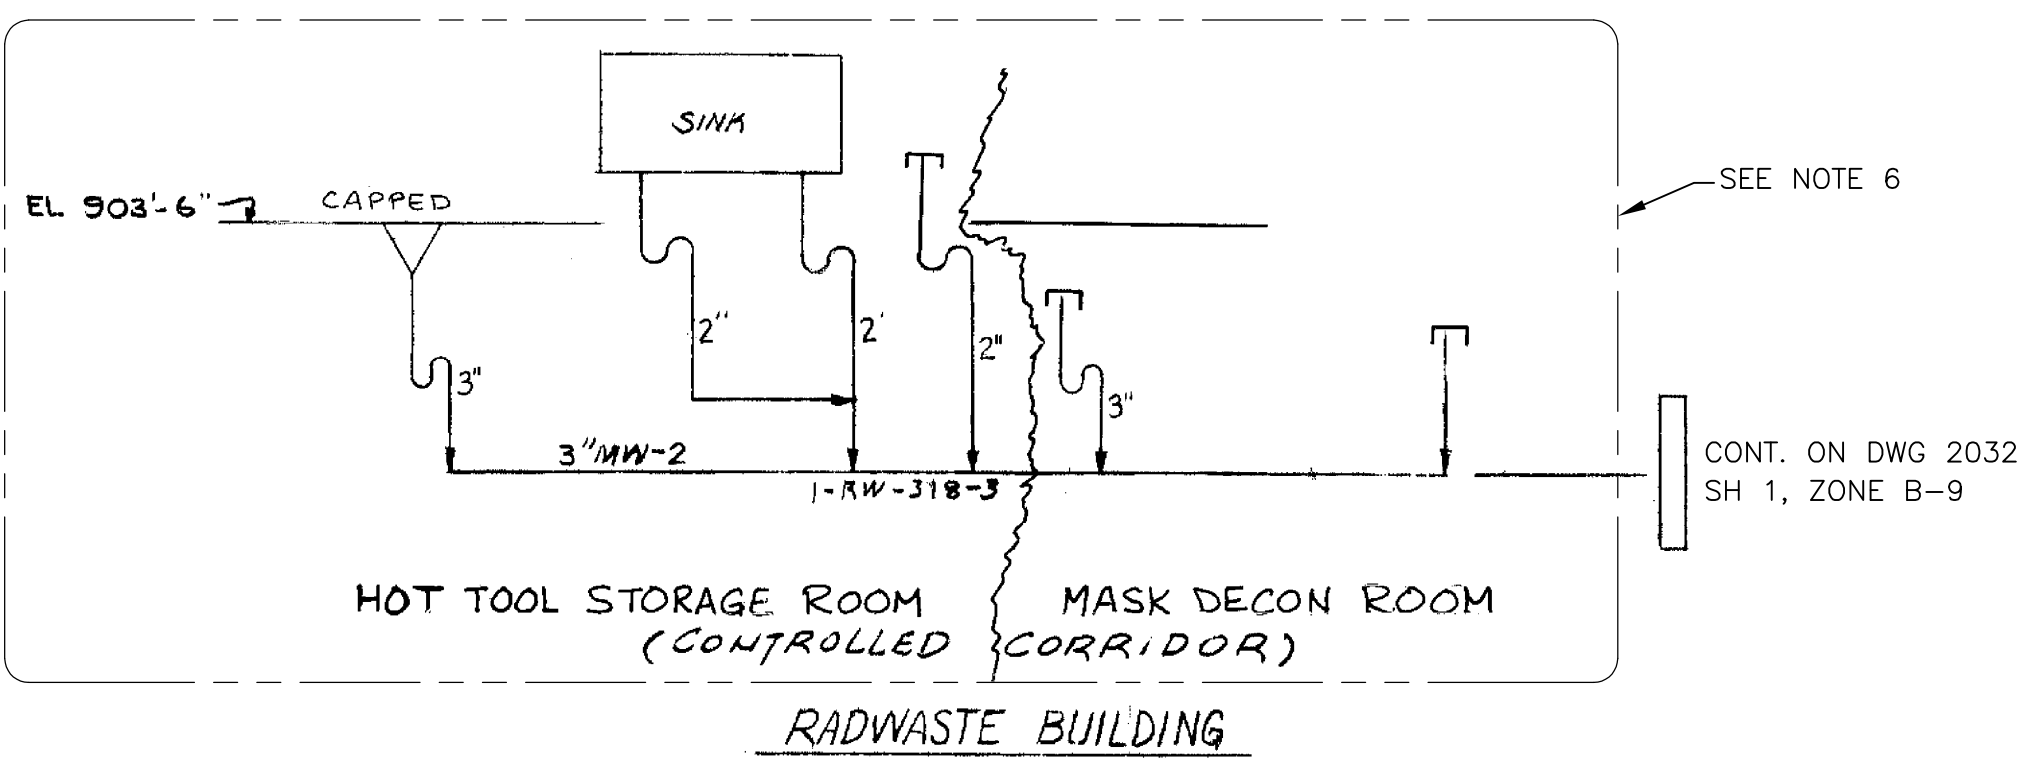

TO STORM SEWER FOR CONT-SEE DWG.

00172917